


SACRAMENTO & MONTGOMERY

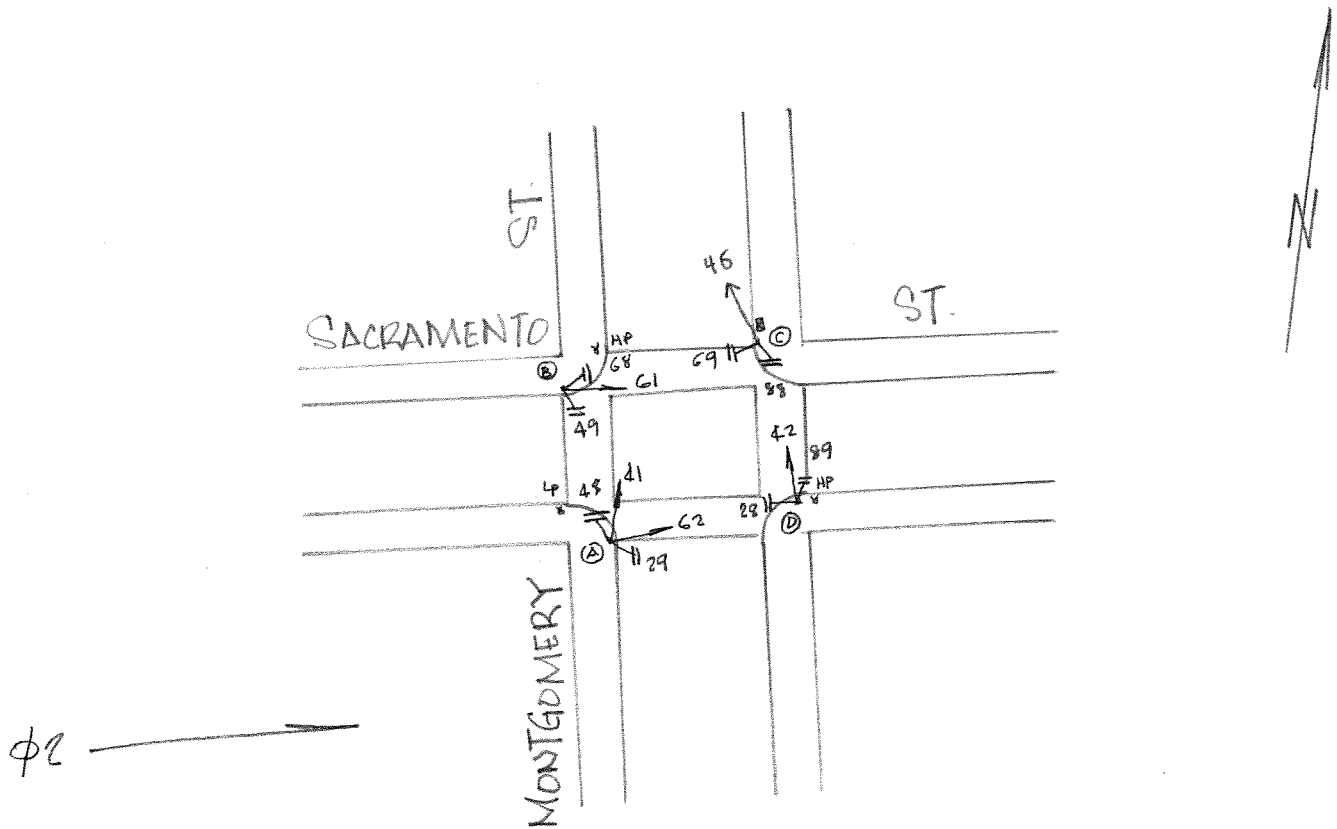

2-5-16

[illegible]

CONTROLLER CABINET SIZE : ORDINARY BASE CABINET : YES

COMMENTS :

Add 46. Upgrade all vehicle signals to 12-INCH

-DYoung