


MONTGOMERY & SUTTER

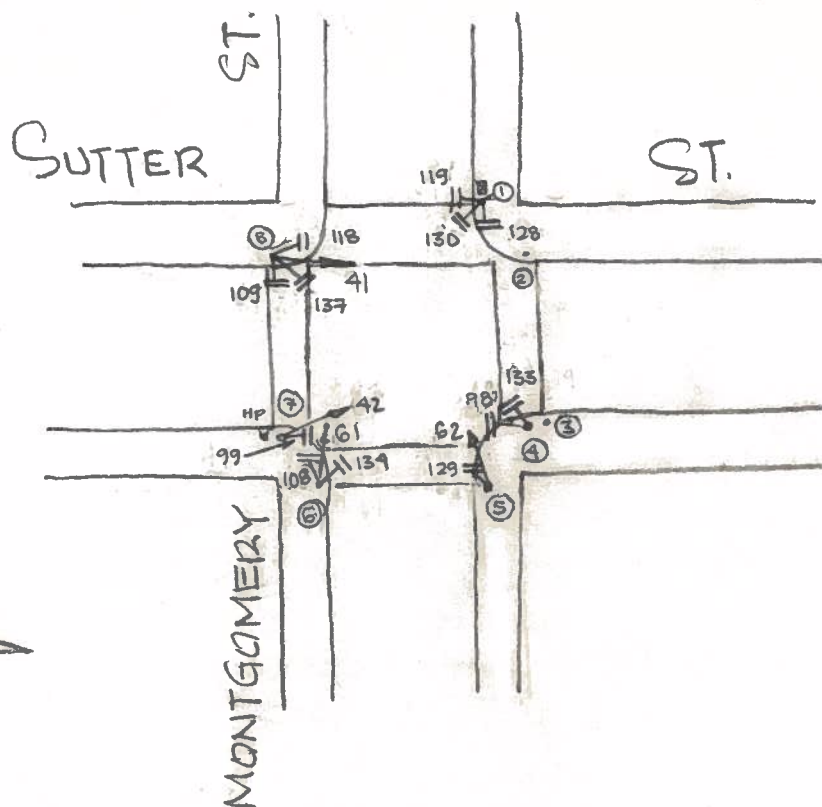

09/28/2019

POLE	FUNC.	MAT'L	SIGNAL NO.	MAKE	NO. OF SECT.	SIZE	VISOR	B.P. OR LOUVERS	MOUN'T	PED SIGNAL NO.	LEGEND	MESSAGE		MAKE	MOUN'T
												ELEMENT	COLOR		
1	S	S	41	EC	3	12"	FT 12"	NO	S	119	COUNT	IS-1	OR/W	ICC	SP-1
2	L	S	42	EC	3	8"	FC 12"	NO	TV-1	128	COUNT	IS-	OR/W	ICC	SP-1
3	L	O	61	EC	3	8"	FT 12"	NO	TV-1	130	COUNT	IS-	OR/W	ICC	TP-1
4	S	S	62	EC	3	8"	FT 12"	NO	SV-1	99	COUNT	IS-	OR/W	ICC	SP-1
5	L	S			3	8"	FC 12"	NO		133	COUNT	IS-	OR/W	ICC	SP-1
6	S	S			3	8"	FC 12"	NO		129	COUNT	IS-	OR/W	ICC	SP-1
7	S	S			3	8"	FC 12"	NO		108	COUNT	IS-	OR/W	ICC	S
8	L	O			3	8"	FC 12"	NO		134	COUNT	IS-	OR/W	ICC	S
										99	COUNT	IS-	OR/W	ICC	SP-1
										109	COUNT	IS-	OR/W	ICC	S
										118	COUNT	IS-	OR/W	ICC	S
										137	COUNT	IS-	OR/W	ICC	S

CONTROLLER CABINET SIZE : MSF BASE CABINET: YES

COMMENTS : NOMA SUMA RETIMING : UPDATE PED PHASE LABELS (SRC 2019-202)
UPDATE VEH PHASE LABEL AS PER TIMING CARD - C. SKERRIT 09/28/2019