


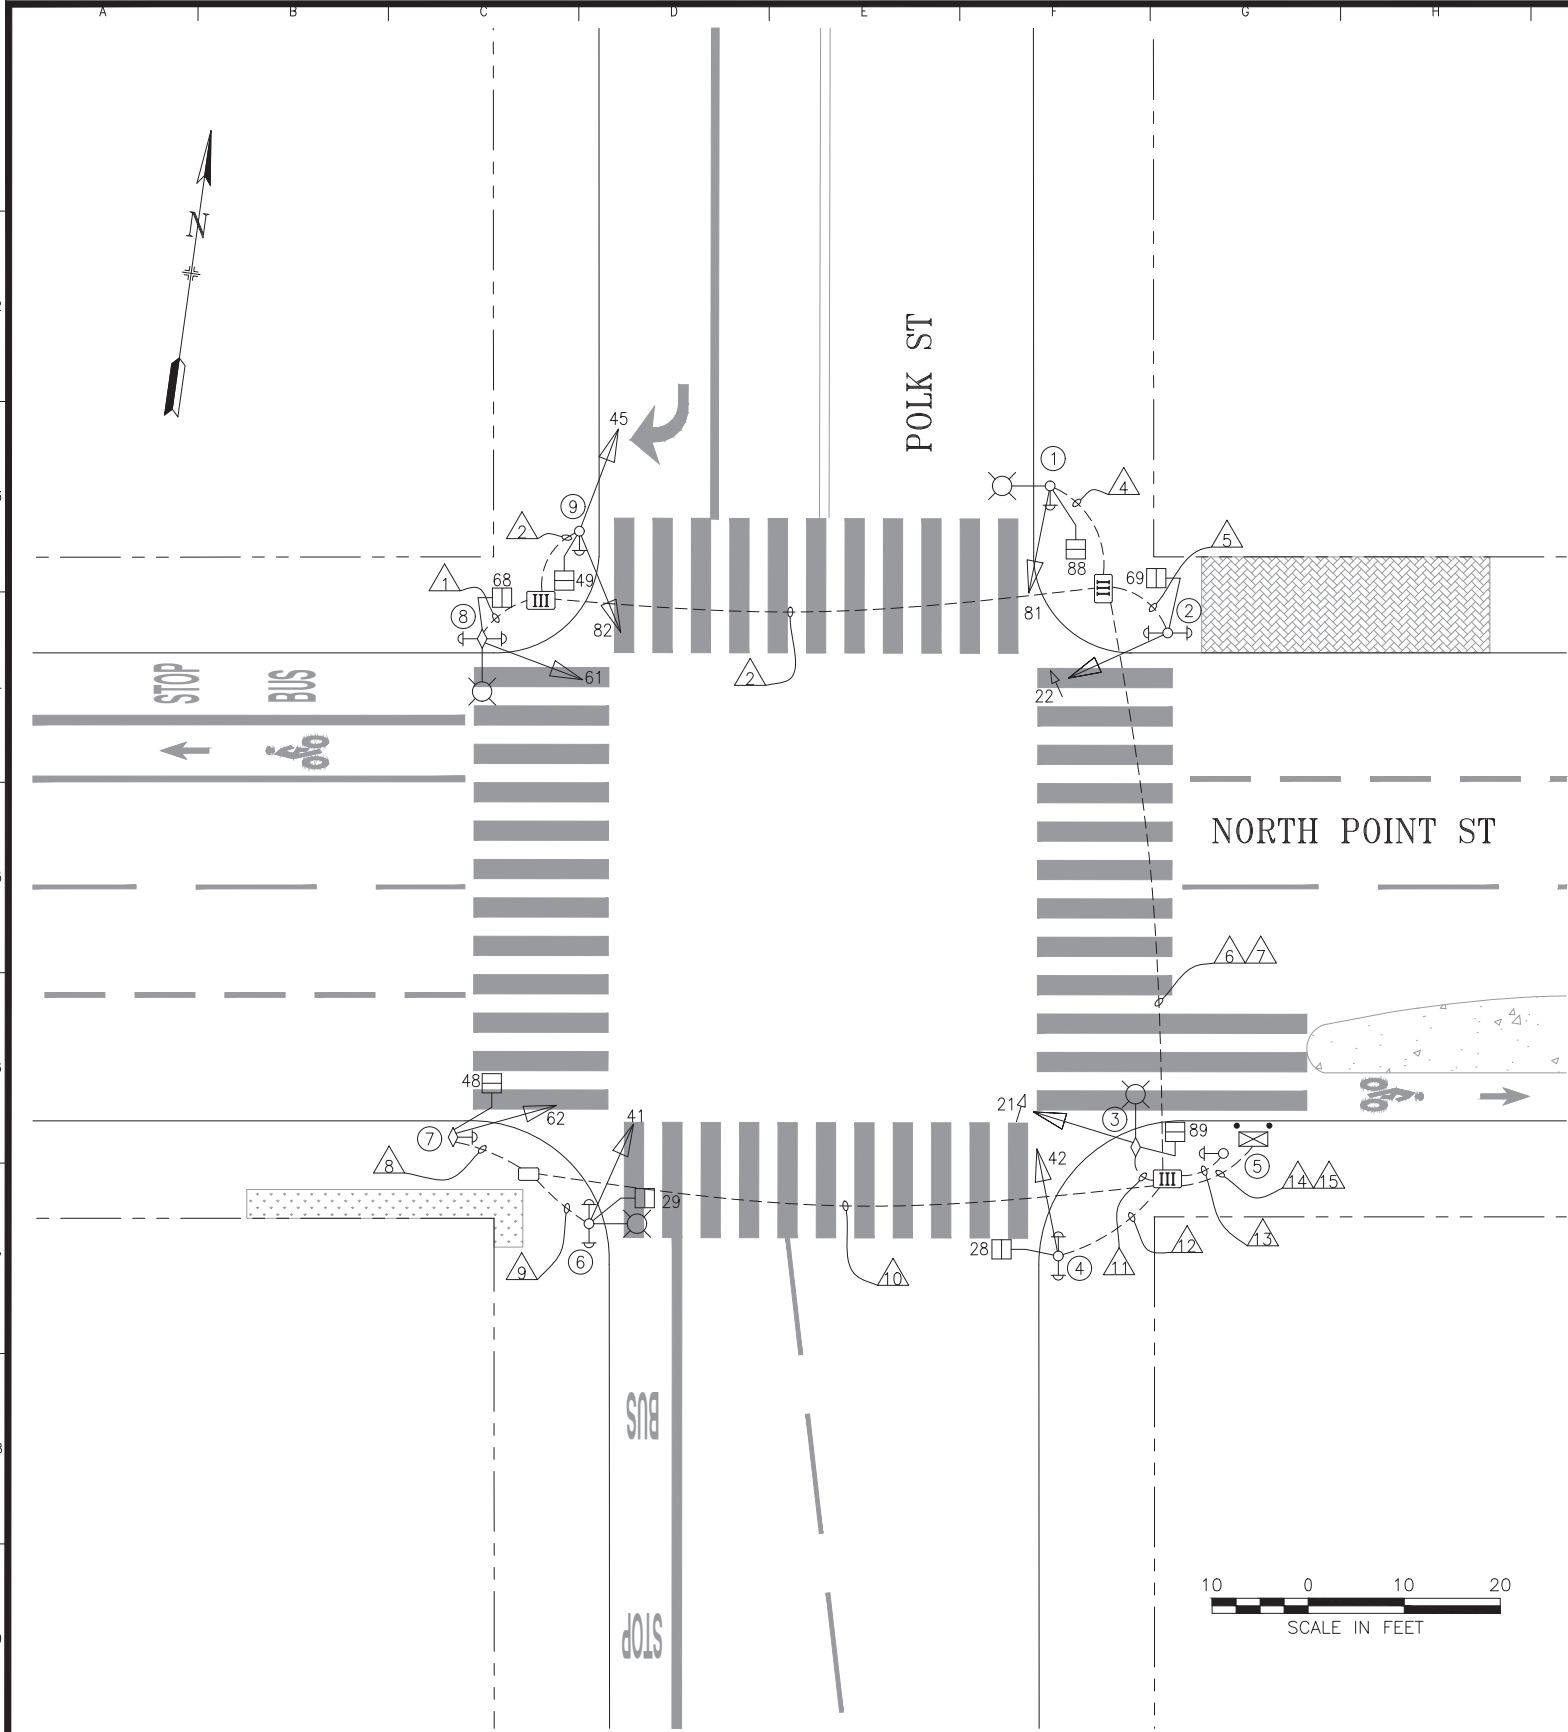

POLE AND EQUIPMENT SCHEDULE											
POLE No.	TYPE OF POLE	LUMINAIRE VOLTAGE/ WATTAGE	VEHICLE SIGNAL					PEDESTRIAN SIGNAL			REMARKS
			No.	TYPE	MOUNTING	VISORS	LOUVERS	No.	TYPE	MOUNTING	
①	1-A(10')		81	3S12"	TV-1-T	T		69	1S-COUNT	SP-1	APS-4W
②	1-A(10')		23	5S12"GYLA	TV-1-T	T		88	1S-COUNT	SP-1	APS-4W x2
③	MUNI POLE WITH 6' LA		21	5S12"GYLA	SV-1-T	T		89	1S-COUNT	SP-1	EXTERNAL CONDUIT
④	1-A(10')		42	3S12"	TV-1-T	T		28	1S-COUNT	SP-1	APS-4W x2
⑤	PPB POLE										APS-4W
⑥	CITY STANDARD STREET LIGHT		41	3S12"	SV-1-T	T		29	1S-COUNT	SP-1	MOUNT 41 @ 13' APS-4W x2
⑦	MUNI POLE		62	3S12"	SV-1-T	T		48	1S-COUNT	SP-1	APS-4W
⑧	MUNI POLE WITH 6' LA		61	3S12"	SV-1-T	T		68	1S-COUNT	SP-1	APS-4W x2
⑨	1-A(10')		45 82	3S12" 3S12"	TV-2-T	T T		49	1S-COUNT	SP-1	APS-4W

TABLE OF REVISIONS		CHECKOUT DRAWING THROUGH THE SID CUSTODIAN FOR THE LATEST REVISION		
NO.	DATE	DESCRIPTION	BY	APPROVED
1	8/12/20	APS INSTALLED PER SRC 2019-187	J.HORNBOSTEL	G.DeLEON
0	10/11/18	SIGNAL MOD BY 2126J; CONVERTED FROM 2126J & 1094N AS-BUILTS	J.HORNBOSTEL	G.DeLEON



SFMTA

DRAWN BY:		DATE:	
J. HORNBOSTEL		10/2021	
CHECKED BY:		DATE:	
G. DeLEON		10/2021	

SCALE
AS SHOWN
SHEET OF SHEETS
01 OF 02

TRAFFIC SIGNAL INVENTORY DIAGRAM
NORTH POINT STREET AND POLK STREET

CNN NO:
26704000
REV NO:
1

CONDUIT AND WIRING SCHEDULE (FURNISH AND INSTALL CONDUIT AND WIRES)																													
CONDUIT RUN NUMBER		1	2	3	4	5	6	7	8	9	10	11	12	13	14	15													
CONDUIT SIZE (INCH)		UNK	2	2	2	2	2	2	UNK	UNK	2	UNK	2	1	2	2													
				GRS	GRS	GRS	GRS	GRS			GRS		GRS		GRS	GRS													
NOTES																													
	VEHICLE SIGNAL 61	3		3			3								3														
	PED SIGNAL 68	2		2			2								2														
	VEHICLE SIGNAL 45		3	3			3								3														
	VEHICLE SIGNAL 82		3	3			3								3														
	PED SIGNAL 49		2	2			2								2														
	VEHICLE SIGNAL 81				3			3								3													
	PED SIGNAL 88				2			2								2													
	VEHICLE SIGNAL 22					5		5								5													
	PED SIGNAL 69					2		2								2													
	VEHICLE SIGNAL 62								3		3				3														
	PED SIGNAL 48								2		2				2														
	VEHICLE SIGNAL 41									3	3				3														
	PED SIGNAL 29									2	2				2														
	VEHICLE SIGNAL 21											5			5														
	PED SIGNAL 89											2			2														
	VEHICLE SIGNAL 42												3			3													
	PED SIGNAL 28												2			2													
	#14 NEUTRAL	2	2		2	2			2	2		2	2																
	#14 SPARE			3			3				3				3	3													
	TOTAL #14 WIRES	7	10	16	7	9	16	12	7	7	13	9	7	</															

1	8/12/20	APS INSTALLED PER SRC 2019-187		J.HORNBOSTEL	G.DeLEON
0	10/11/18	SIGNAL MOD BY 2126J; CONVERTED FROM 2126J & 1094N AS-BUILTS		J.HORNBOSTEL	G.DeLEON
NO.	DATE	DESCRIPTION		BY	APPROVED
TABLE OF REVISIONS					
CHECKOUT DRAWING THROUGH THE SID CUSTODIAN FOR THE LATEST REVISION					

**SFMTA**

DRAWN BY: J. HORNBOSTEL DATE: 10/2021

CHECKED BY: G. DeLEON DATE: 10/2021

NONE

02 OF 02

NORTH POINT STREET AND POLK STREET CONDUIT AND WIRING SCHEDULE