


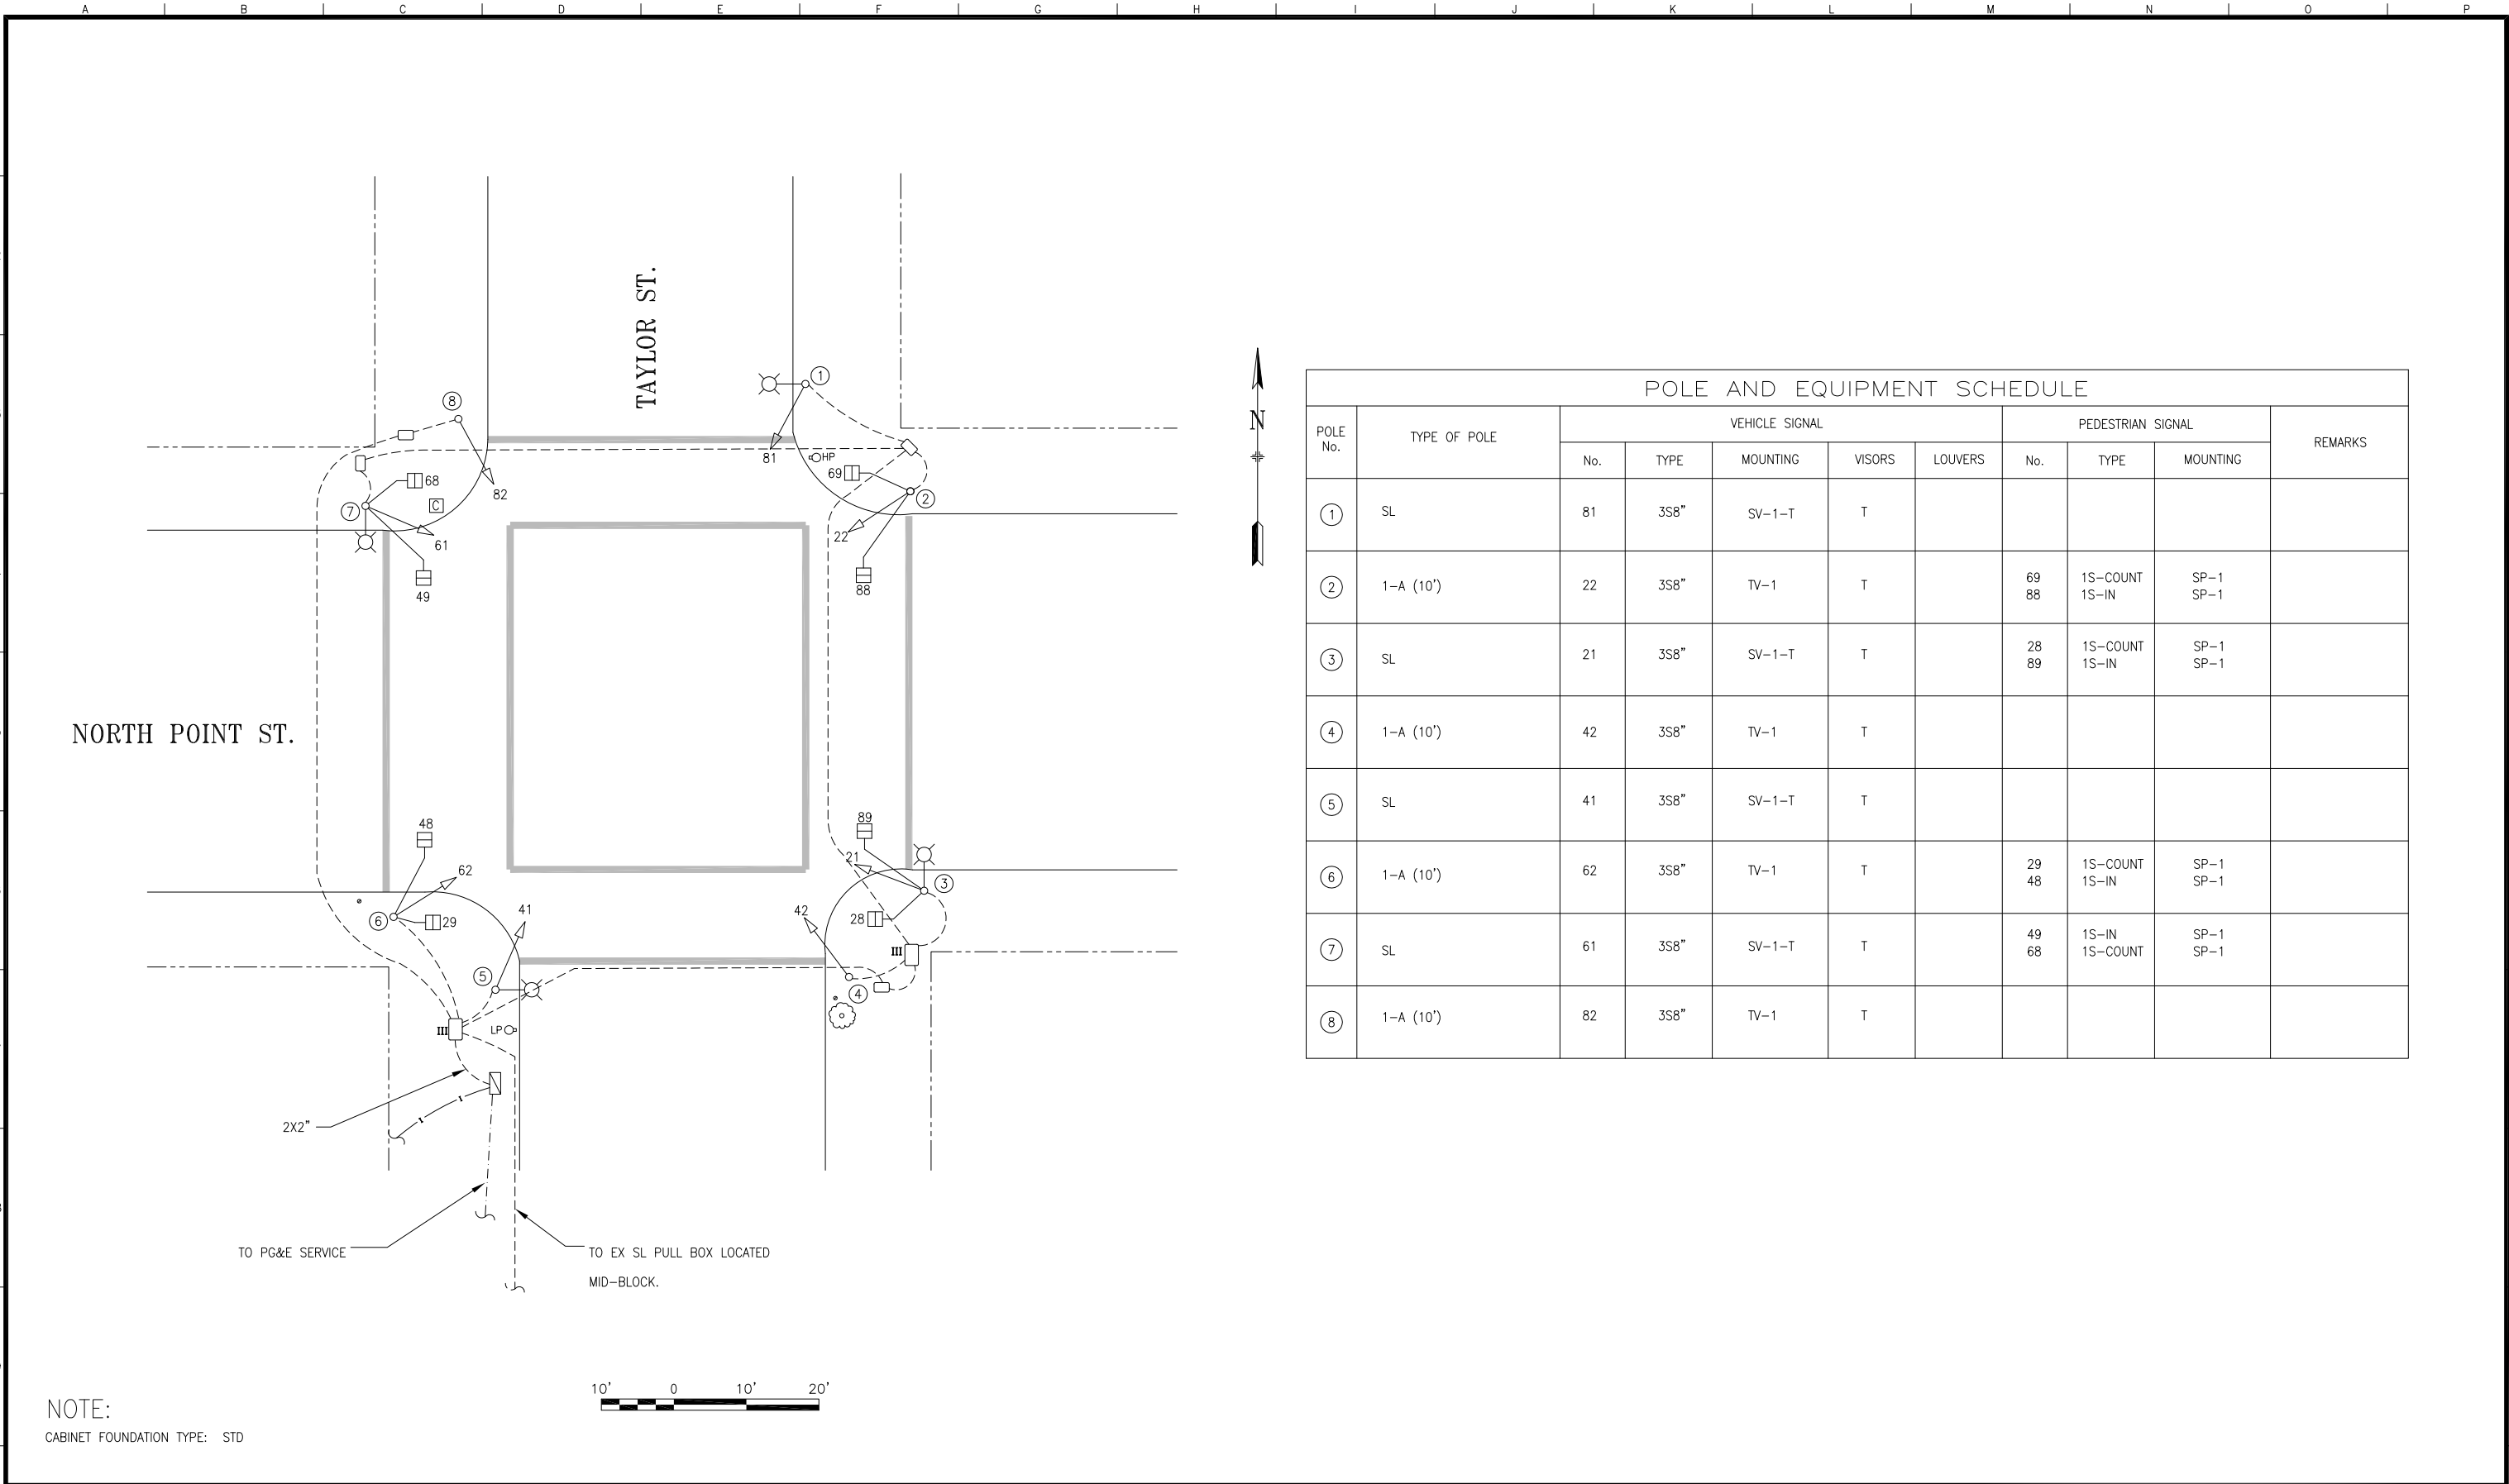

POLE AND EQUIPMENT SCHEDULE									
POLE No.	TYPE OF POLE	VEHICLE SIGNAL					PEDESTRIAN SIGNAL		
		No.	TYPE	MOUNTING	VISORS	LOUVERS	No.	TYPE	MOUNTING
①	SL	81	3S8"	SV-1-T	T				
②	1-A (10')	22	3S8"	TV-1	T		69 88	1S-COUNT 1S-IN	SP-1 SP-1
③	SL	21	3S8"	SV-1-T	T		28 89	1S-COUNT 1S-IN	SP-1 SP-1
④	1-A (10')	42	3S8"	TV-1	T				
⑤	SL	41	3S8"	SV-1-T	T				
⑥	1-A (10')	62	3S8"	TV-1	T		29 48	1S-COUNT 1S-IN	SP-1 SP-1
⑦	SL	61	3S8"	SV-1-T	T		49 68	1S-IN 1S-COUNT	SP-1 SP-1
⑧	1-A (10')	82	3S8"	TV-1	T				

2

09/01/11

ADD SIGNALS 28,29,68,69 PER SRC 10-080

ET

HQ

1

07/97

BAY & NORTH PT. PROJECT JOB# 1094 N

DVC

RO

NO.

DATE

DESCRIPTION

BY

APP.

TABLE OF REVISIONS

CHECK WITH TRACING TO SEE IF YOU HAVE LATEST REVISION



SAN FRANCISCO MUNICIPAL TRANSPORTATION AGENCY

TRANSPORTATION ENGINEERING

CITY AND COUNTY OF SAN FRANCISCO

DRAWN:

DVC

DATE:

8/29/01

CHECKED:

DATE:

SCALE:

AS SHOWN

SHEET OF SHEETS

1 OF 1

TRAFFIC SIGNAL INVENTORY DIAGRAM

NORTH POINT ST & TAYLOR ST

CNN NO.

25592000

REV NO.

FILE NAME: North Point-Taylor.dwg

DATE: Aug 30 2001 13:35

ORIGIN: Soles & Tox

SCALE FACTOR: 240

PLOT SCALE: 1=1

EXTERNAL REFERENCES: ROMANS.SHX

ROMANS.SHX

romans

ROMANS.SHX

romant.shx