


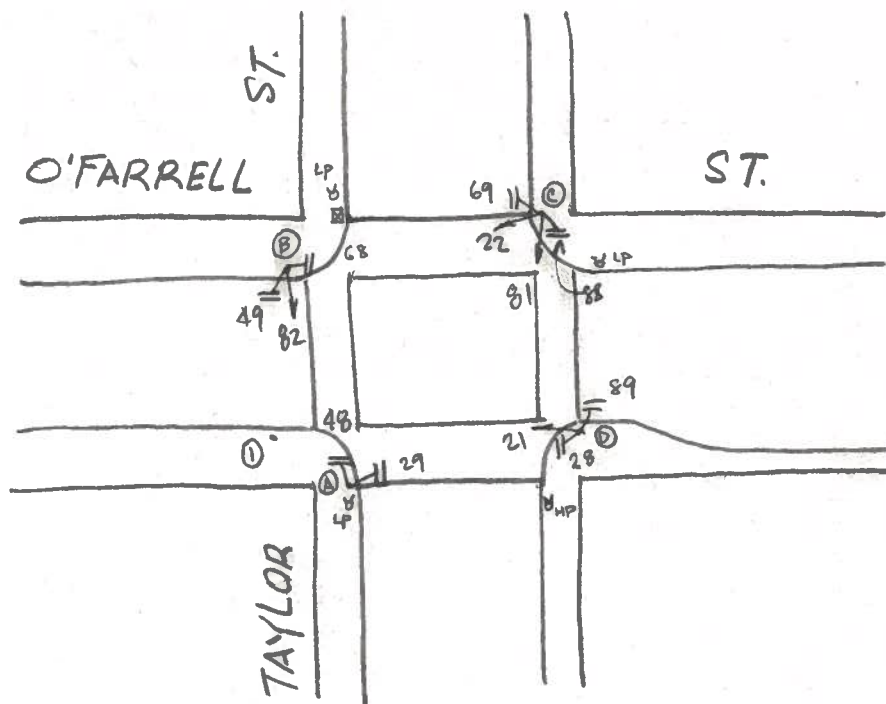

08-07-2019

POLE	FUNC.	MATL	SIGNAL NO.	MAKE	NO. OF SECT.	SIZE	VISOR	B.P. OR LOUVERS	MOUN'T	PED SIGNAL NO.	LEGEND	MESSAGE		MAKE	MOUN'T
												ELEMENT	COLOR		
A	S	S	82	EC	3	12"	T12"	NO	S	29	W/DW	GRD	W/OR	ED	T
B	S	S	22	GA	3	12"	T12"	NO	T	48	W/DW	GRD	W/OR	ED	T
C	S	S	81	GA	3	12"	T12"	NO	T	49	W/DW	GRD	W/OR	ED	S
D	S	S	21	EC	3	12"	T12"	NO	S	68	W/DW	GRD	W/OR	ED	S
										69	W/DW	GRD	W/OR	ED	S
										88	W/DW	GRD	W/OR	ED	S
										89	W/DW	GRD	W/OR	ED	S
										28	W/DW	GRD	W/OR	ED	S
1	L	O													

CONTROLLER CABINET SIZE : ORDINARY BASE CABINET: NO

COMMENTS :

Change 21, 22, 81, 82 from 3S8" to 3S12"
via SRC 2019-271. - G.Ho