


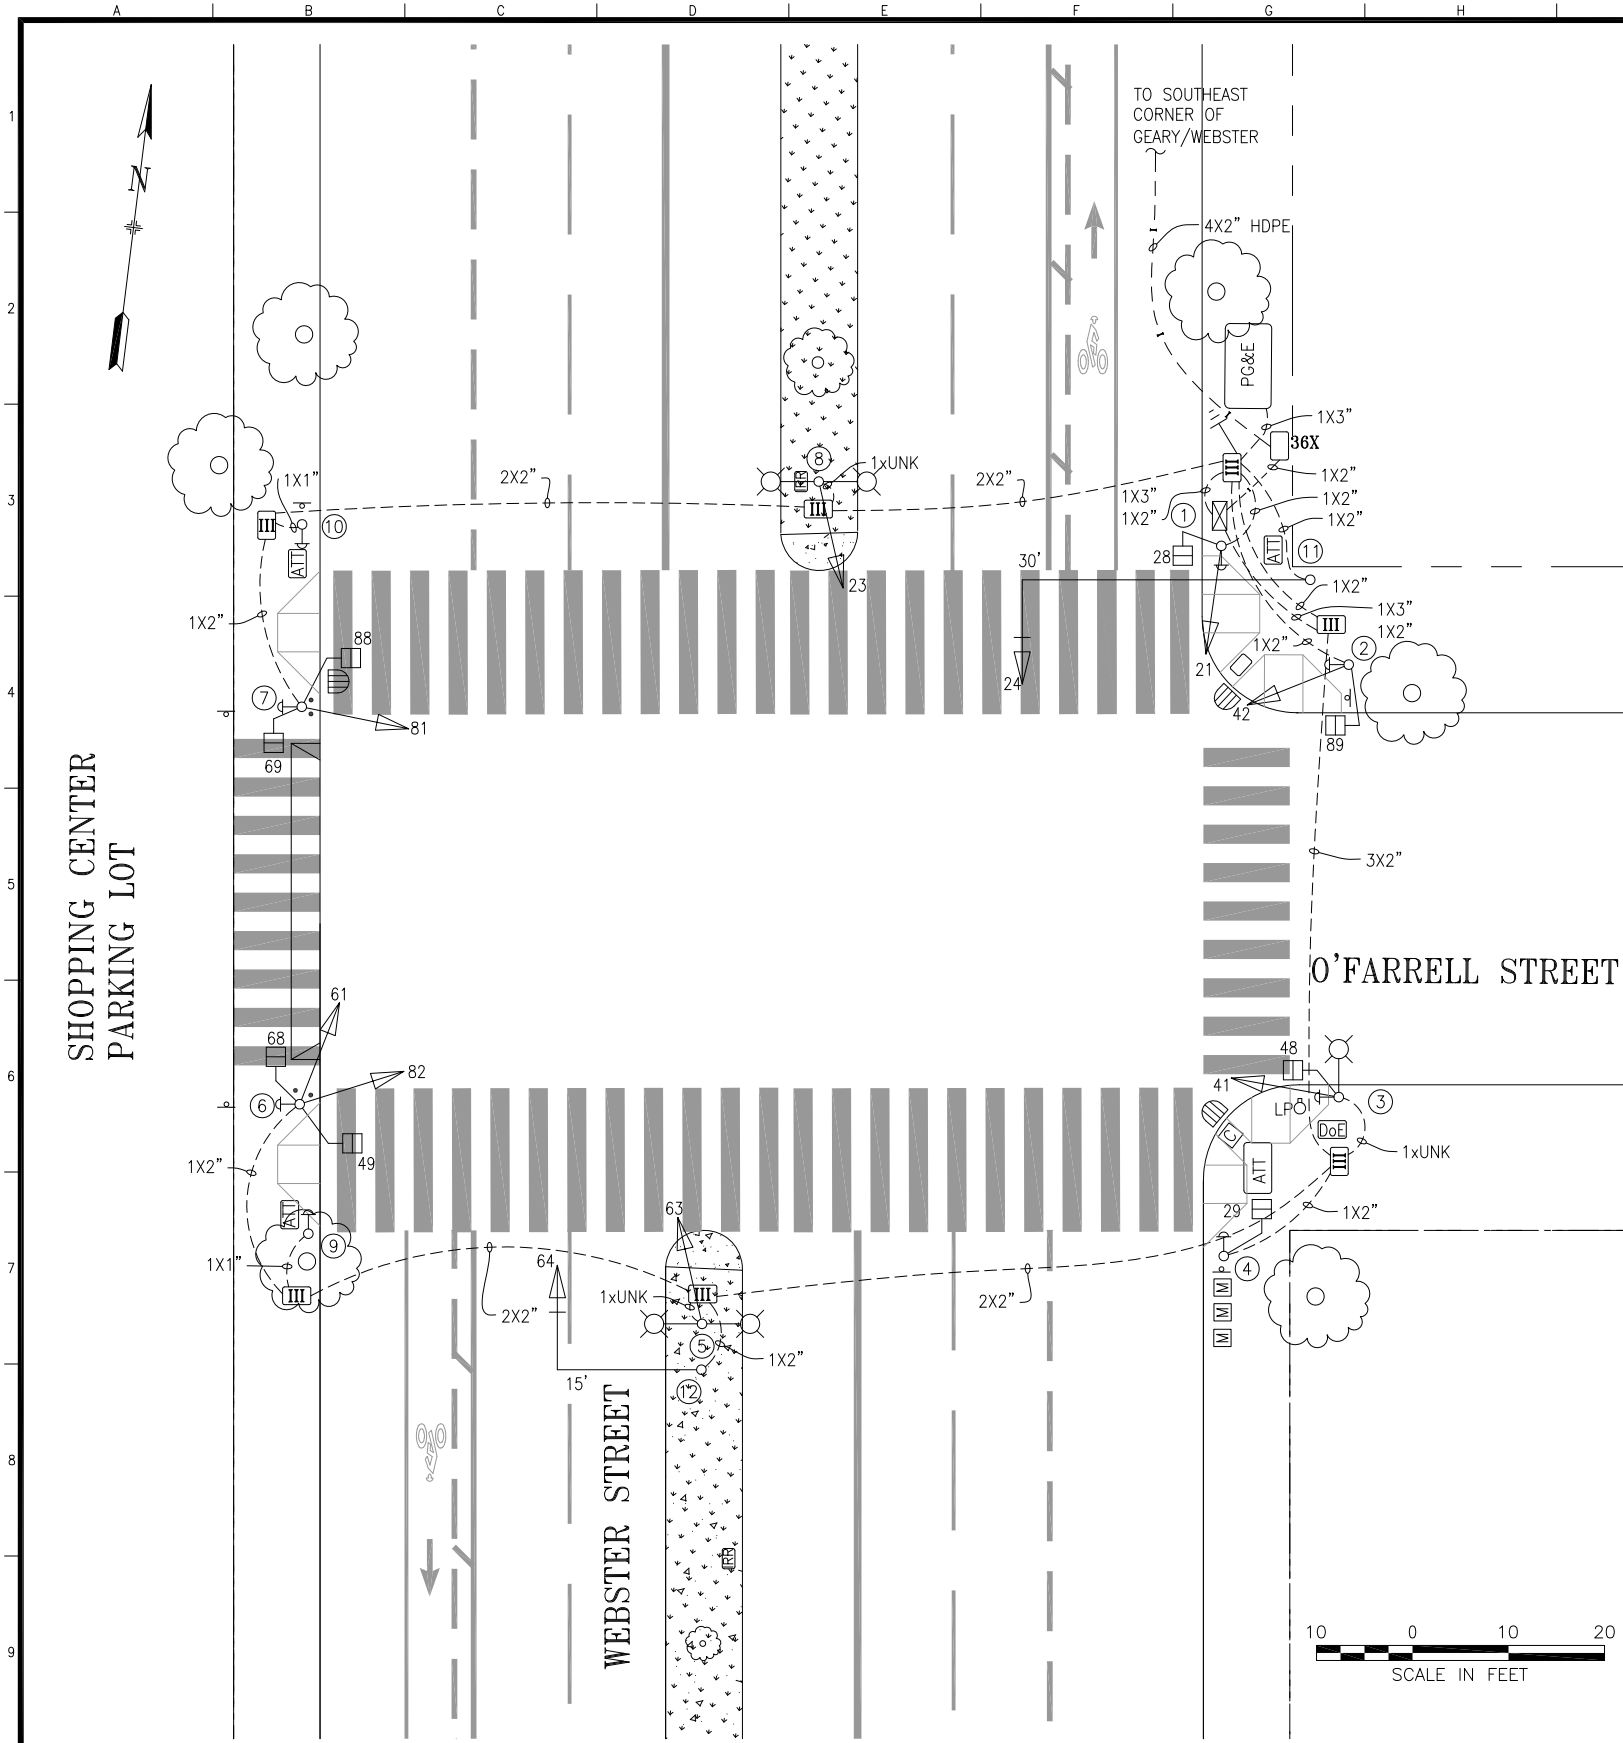

POLE AND EQUIPMENT SCHEDULE											
POLE No.	TYPE OF POLE	LUMINAIRE VOLTAGE/ WATTAGE	VEHICLE SIGNAL					PEDESTRIAN SIGNAL			REMARKS
			No.	TYPE	MOUNTING	VISORS	LOUVERS	No.	TYPE	MOUNTING	
①	1-A (10')		21	3S12"	TV-1-T	T		28	1S-COUNT	SP-1	APS-4W
②	1-A (10')		42	3S12"	TV-1-T	T		89	1S-COUNT	SP-1	APS-4W
③	MARBLELITE STREET LIGHT		41	3S12"	SV-1-T	T		48	1S-COUNT	SP-1	APS-4W
④	1-A (7')							29	1S-COUNT	TP-1	APS-4W
⑤	MARBLELITE SL W/DUAL LUMINAIRE ARMS		63	3S12"	SV-1-T	T					
⑥	1-A (13')		61 82	3S12" 3S12"	TV-1-T SV-1-T	T T		49 68	1S-COUNT 1S-COUNT	SP-1 (22") SP-1-SF (12")	MOUNT 61 ON WEST SIDE MOUNT 82 ON SOUTH SIDE APS-4W
⑦	1-A (10')		81	3S12"	TV-1-T	T		69 88	1S-COUNT 1S-COUNT	SP-1 SP-1	APS-4W
⑧	MARBLELITE SL W/DUAL LUMINAIRE ARMS		23	3S12"	SV-1-T	T					
⑨	PPB POLE										APS-4W
⑩	PPB POLE										APS-4W
⑪	18-2-100 W/30' MAST ARM		24	3S12"	MAS	T					BACKPLATE
⑫	16-2-100 W/15' MAST ARM		64	3S12"	MAS	T					BACKPLATE

0	3/24/16	NEW SIGNAL ACTIVATED THROUGH 2477J	D.Yeung	M.Velasco	
NO.	DATE	DESCRIPTION	BY	APP.	
TABLE OF REVISIONS					
CHECK WITH TRACING TO SEE IF YOU HAVE LATEST REVISION					

REFERENCE INFORMATION
& FILE NO. OF SURVEYS



SAN FRANCISCO MUNICIPAL TRANSPORTATION AGENCY
CITY AND COUNTY OF SAN FRANCISCO

DRAWN: DATE:
A.SCALES 1/11/2017
CHECKED: DATE:
G.DELEON 1/13/2017

SCALE:

AS SHOWN

SHEET OF SHEETS

1 OF 1

TRAFFIC SIGNAL INVENTORY DIAGRAM

O'FARRELL STREET AND WEBSTER STREET

CNN NO.

26588000

REV NO.

0