


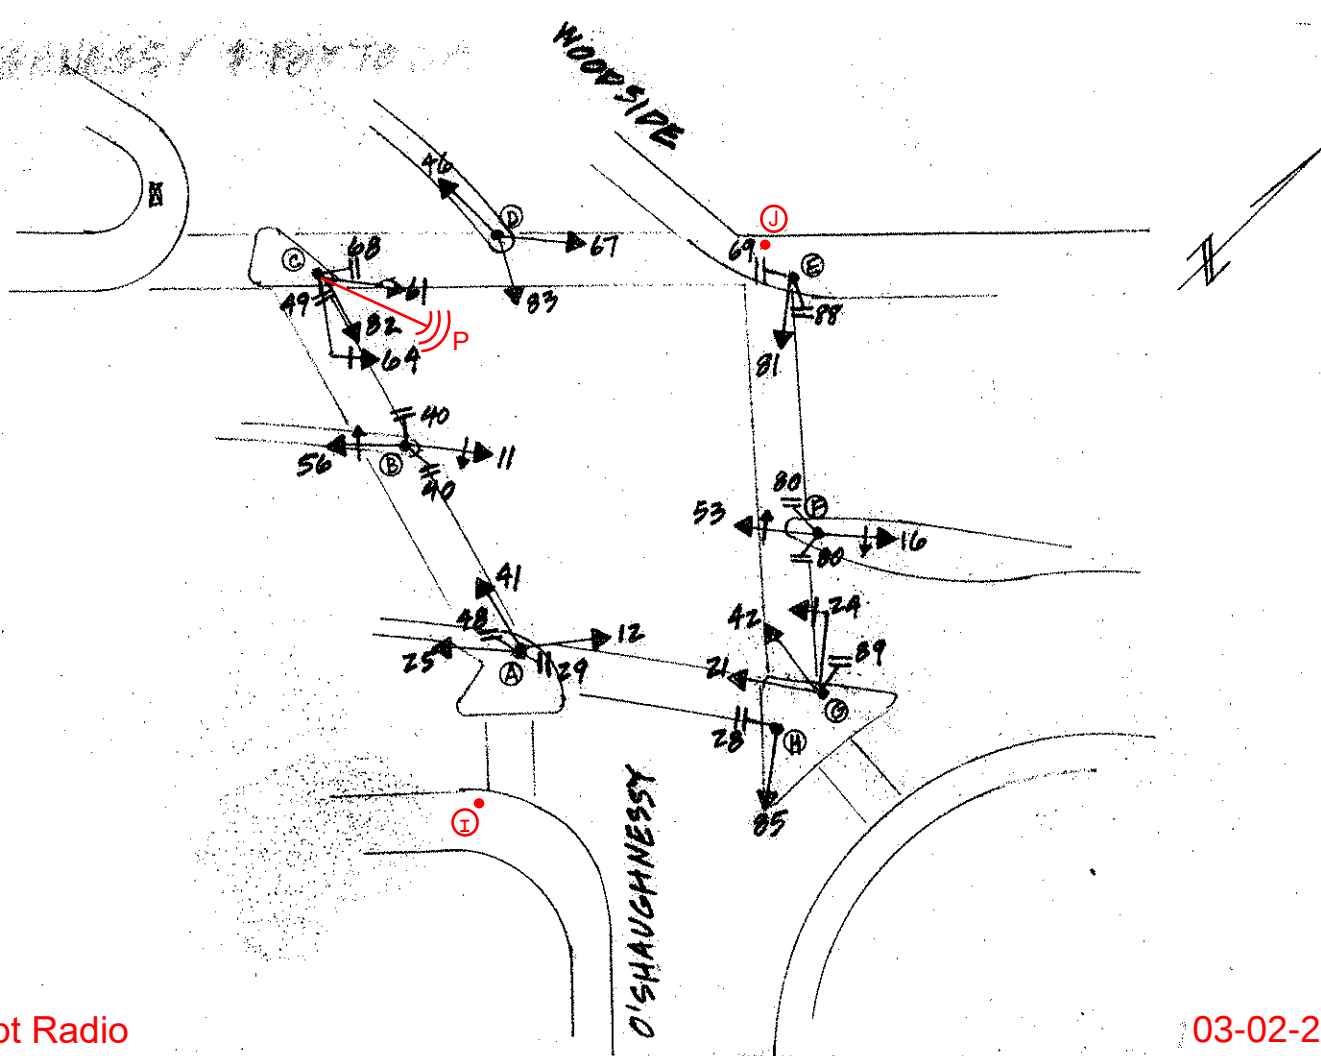

*Preempt Radio

03-02-2023

POLE	FUNC.	MATL.	SIGNAL NO.	MAKE	NO. OF SECT.	SIZE	VISOR	B.P. OR LOUVERS	MOUNT	PED SIGNAL NO.	LEGEND	MESSAGE		MAKE	MOUN
												ELEMENT	COLOR		
A	S	C	64	TCT	3	12"	FC12"	BP	MAS	88	I	15-1	W/OR	ICC	S
B	L	C	82	TCT	4	12" RYGB	FC12"	NO	S	69	I	15-1	W/OR	ICC	S
C*	S	S	61	TCT	5	12" RYGB	FC12"	NO	S	90	I	15-1	W/OR	ICC	S
D	L	C	46	TCT	3	12"	FC12"	NO	S	80	I	15-1	W/OR	ICC	S
E	S	C	83	TCT	4	12" RYGB	FC12"	NO	S	89	I	15-1	W/OR	ICC	S
F	L	C	67	TCT	5	12" RYGB	FC12"	NO	S	28	I	15-1	W/OR	ICC	S
G	S	S	81	TCT	3	12"	FC12"	NO	T	29	I	15-1	W/OR	ICC	S
H	S	S	53	TCT	3	12" RYGB	FC12"	NO	S	48	I	15-1	W/OR	ICC	S
I	S	S	16	TCT	3	12" RYGB	FC12"	NO	S	40	I	15-1	W/OR	ICC	S
J	S	S	24	TCT	3	12"	FC12"	BP	MAS	40	I	15-1	W/OR	ICC	S
			*42	TCT	4	12" RYGB	FC12"	NO	S	49	I	15-1	W/OR	ICC	S
			21	TCT	3	12"	FC12"	NO	S	68	I	15-1	W/OR	ICC	S
			85	TCT	3	12"	FC12"	NO	T						
			12	TCT	3	12" RYGB	FC12"	NO	T						
			41	TCT	3	12"	FC12"	NO	T						
			25	TCT	3	12"	FC12"	NO	T						
			56	TCT	3	12" RYGB	FC12"	NO	S						
			11	TCT	3	12" RYGB	FC12"	NO	S						

CONTROLLER CABINET SIZE : LARGE BASE CABINET : -

COMMENTS : * ARROW AT 45° (K)

Added preempt radio on Pole C per SRC 2023-023; added PPB poles I & J per field - S.Alexander, M.Velasco (03/02/23)