


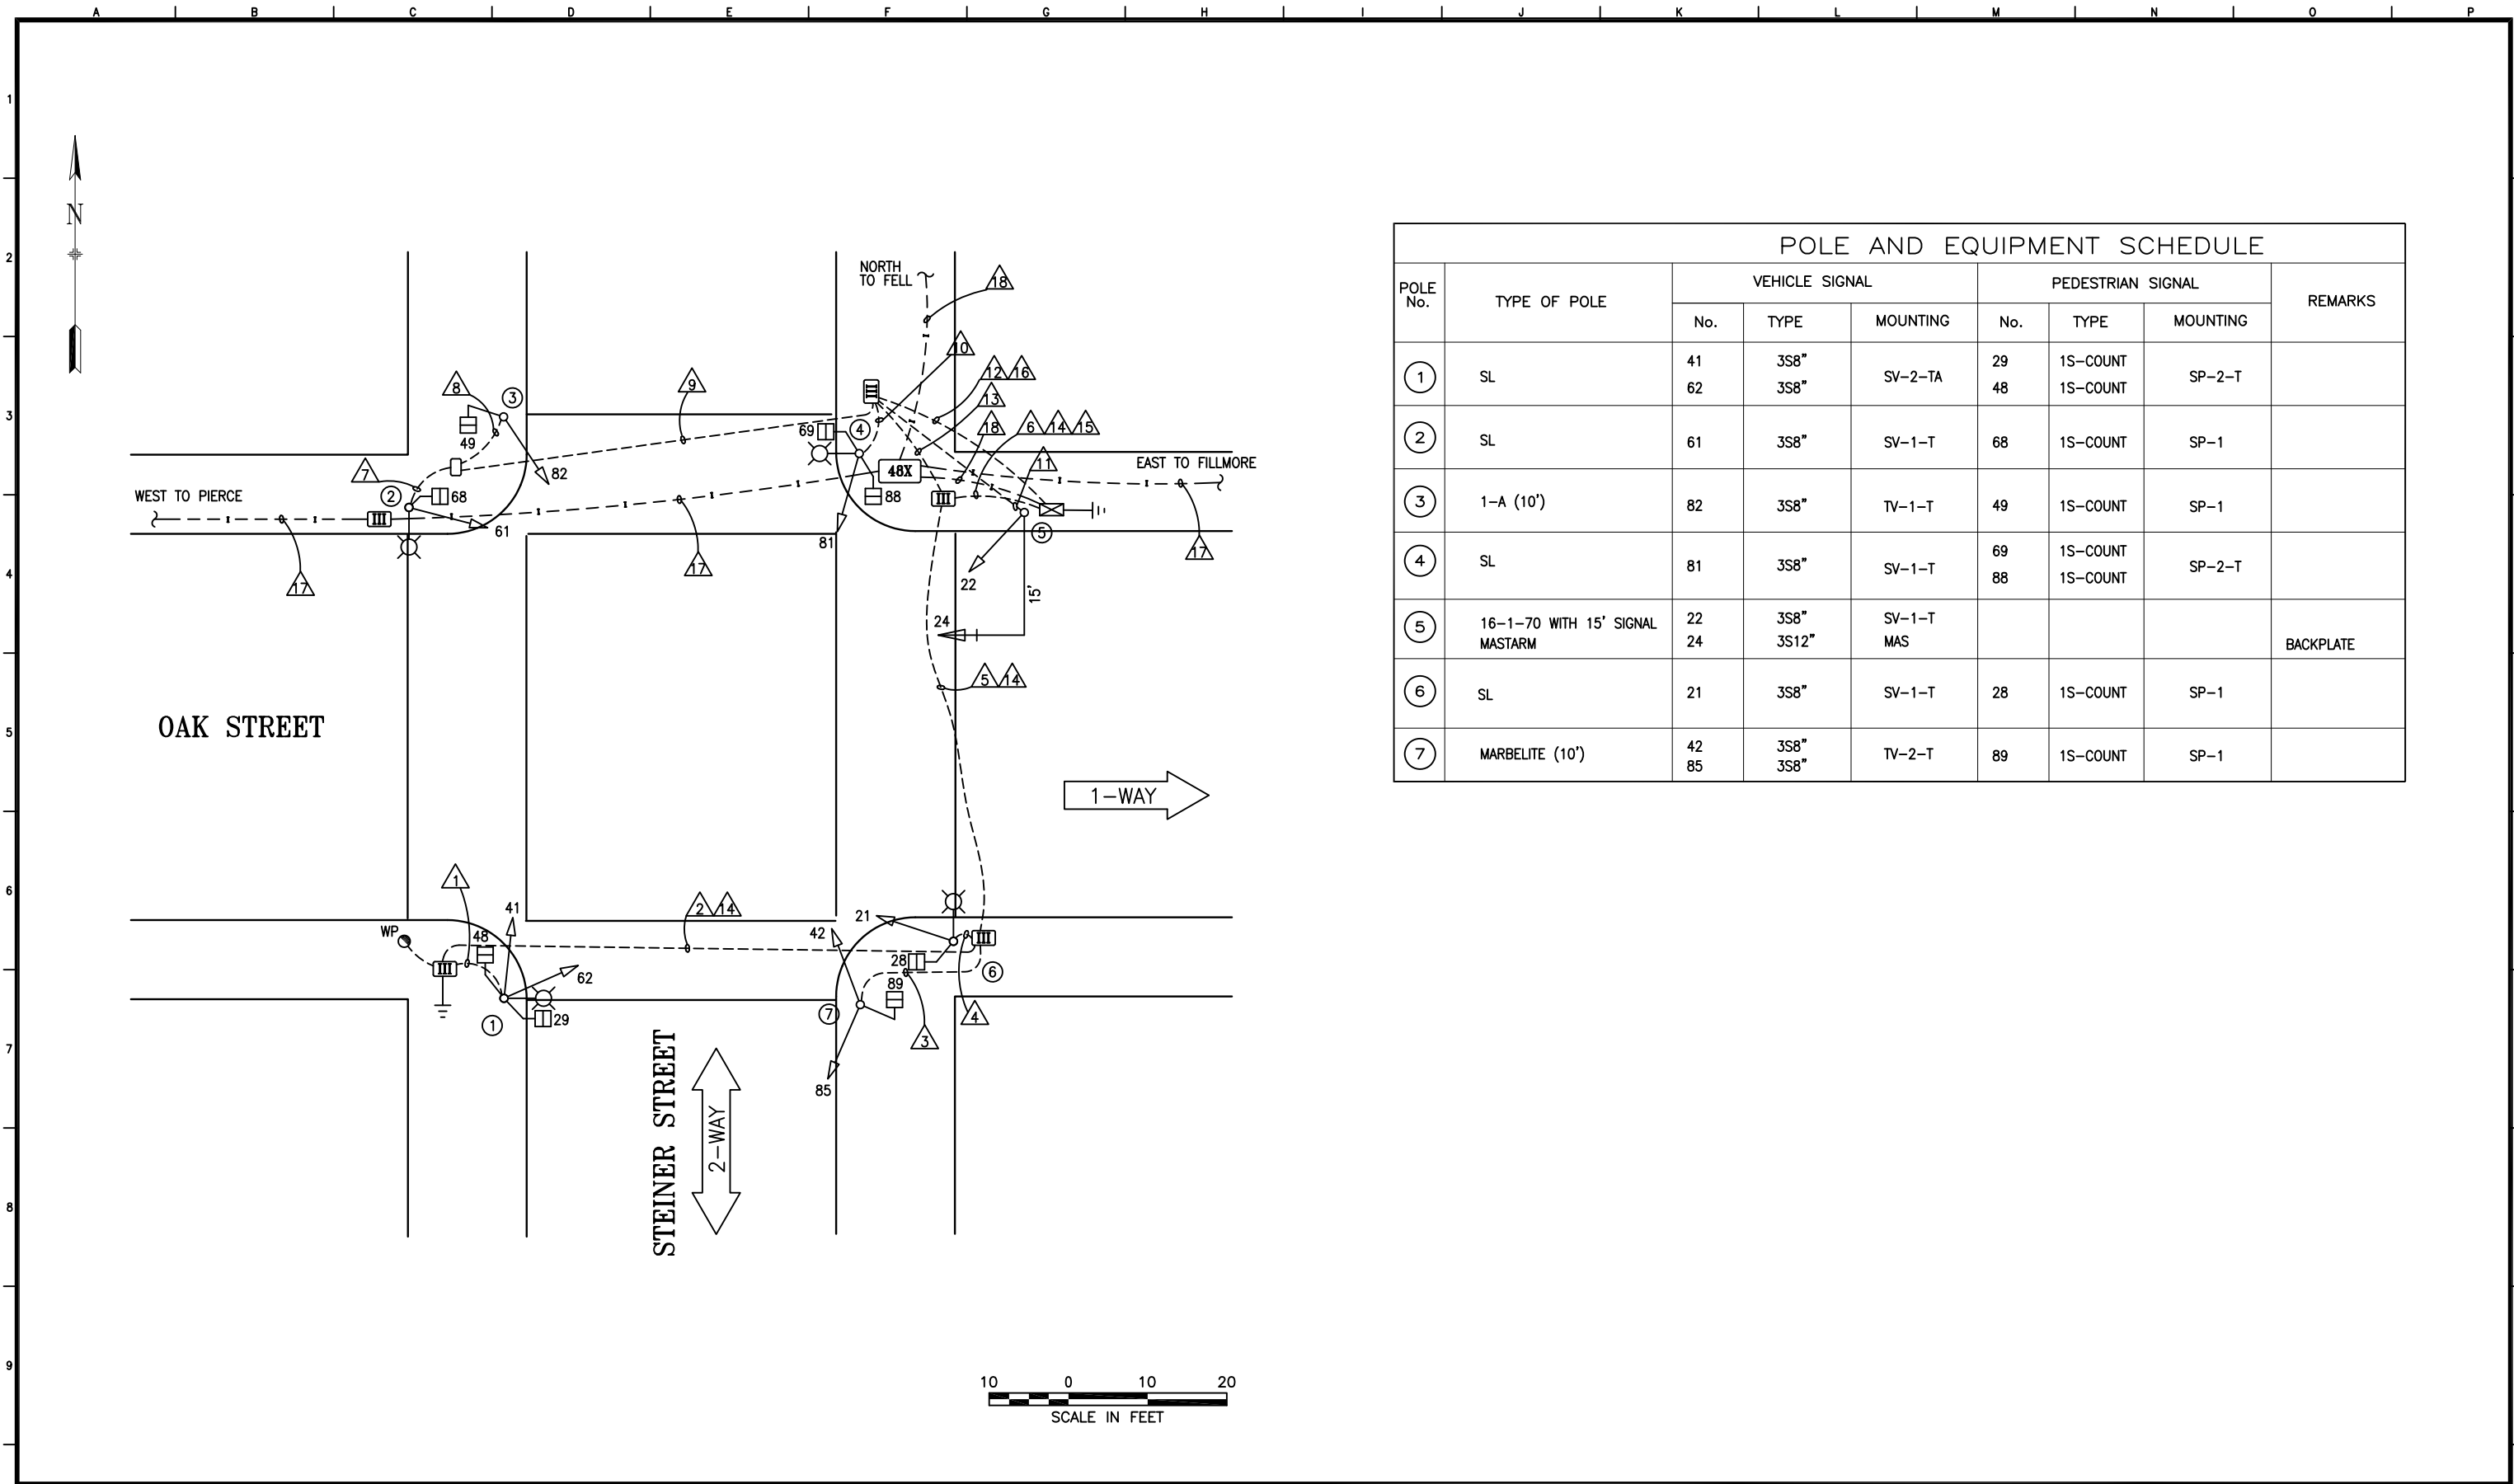

POLE AND EQUIPMENT SCHEDULE								
POLE No.	TYPE OF POLE	VEHICLE SIGNAL			PEDESTRIAN SIGNAL			REMARKS
		No.	TYPE	MOUNTING	No.	TYPE	MOUNTING	
①	SL	41 62	3S8" 3S8"	SV-2-TA	29 48	1S-COUNT 1S-COUNT	SP-2-T	
②	SL	61	3S8"	SV-1-T	68	1S-COUNT	SP-1	
③	1-A (10')	82	3S8"	TV-1-T	49	1S-COUNT	SP-1	
④	SL	81 88	3S8" 3S8"	SV-1-T	69 88	1S-COUNT 1S-COUNT	SP-2-T	
⑤	16-1-70 WITH 15' SIGNAL MASTARM	22 24	3S8" 3S12"	SV-1-T MAS				BACKPLATE
⑥	SL	21	3S8"	SV-1-T	28	1S-COUNT	SP-1	
⑦	MARBELITE (10')	42 85	3S8" 3S8"	TV-2-T	89	1S-COUNT	SP-1	

TABLE OF REVISIONS				
NO.	DATE	DESCRIPTION	BY	APP.
2	03/30/11	PED SIGNALS ACTIVATED BY SRC 2010-079	ET	BBD
1	11/07	PER FIELD: TV-1-T FOR 82; TV-2-T FOR 42,85	JH	GD
0	01/22/02	UPGRADE BY 1660N; CONVERTED FROM AS-BUILTS	JH	GD

CHECK WITH TRACING TO SEE IF YOU HAVE LATEST REVISION

REFERENCE INFORMATION & FILE NO. OF SURVEYS



SAN FRANCISCO MUNICIPAL TRANSPORTATION AGENCY
CITY AND COUNTY OF SAN FRANCISCO

DRAWN:	DATE:
JH	7/2021
CHECKED:	DATE:
GD	7/2021

SCALE:
AS SHOWN
SHEET OF SHEETS
01 OF 02

TRAFFIC SIGNAL INVENTORY DIAGRAM
OAK STREET AND STEINER STREET

CNN NO.
25994000
REV NO.
2

[illegible]

2	03/30/11	PED SIGNALS ACTIVATED BY SRC 2010-079	ET	BBI	
1	11/07	PER FIELD: TV-1-T FOR 82; TV-2-T FOR 42.85	JH	GD	
0	01/22/02	UPGRADE BY 1660N: CONVERTED FROM AS-BULTS	JH	GD	
NO.	DATE	DESCRIPTION	BY	APP	
TABLE OF REVISIONS					
CHECK WITH TRACING TO SEE IF YOU HAVE LATEST REVISION					

REFERENCE INFORMATION & FILE NO. OF SURVEYS	
--	--



SAN FRANCISCO MUNICIPAL TRANSPORTATION AGENCY
CITY AND COUNTY OF SAN FRANCISCO

DRAWN:		DATE:	
JH		7/202	
CHECKED:		DATE:	
GD		7/202	

1	
1	

SCALE:	NONE
SHEET OF SHEETS	02 OF 02

TRAFFIC SIGNAL INVENTORY DIAGRAM
OAK STREET AND STEINER STREET