


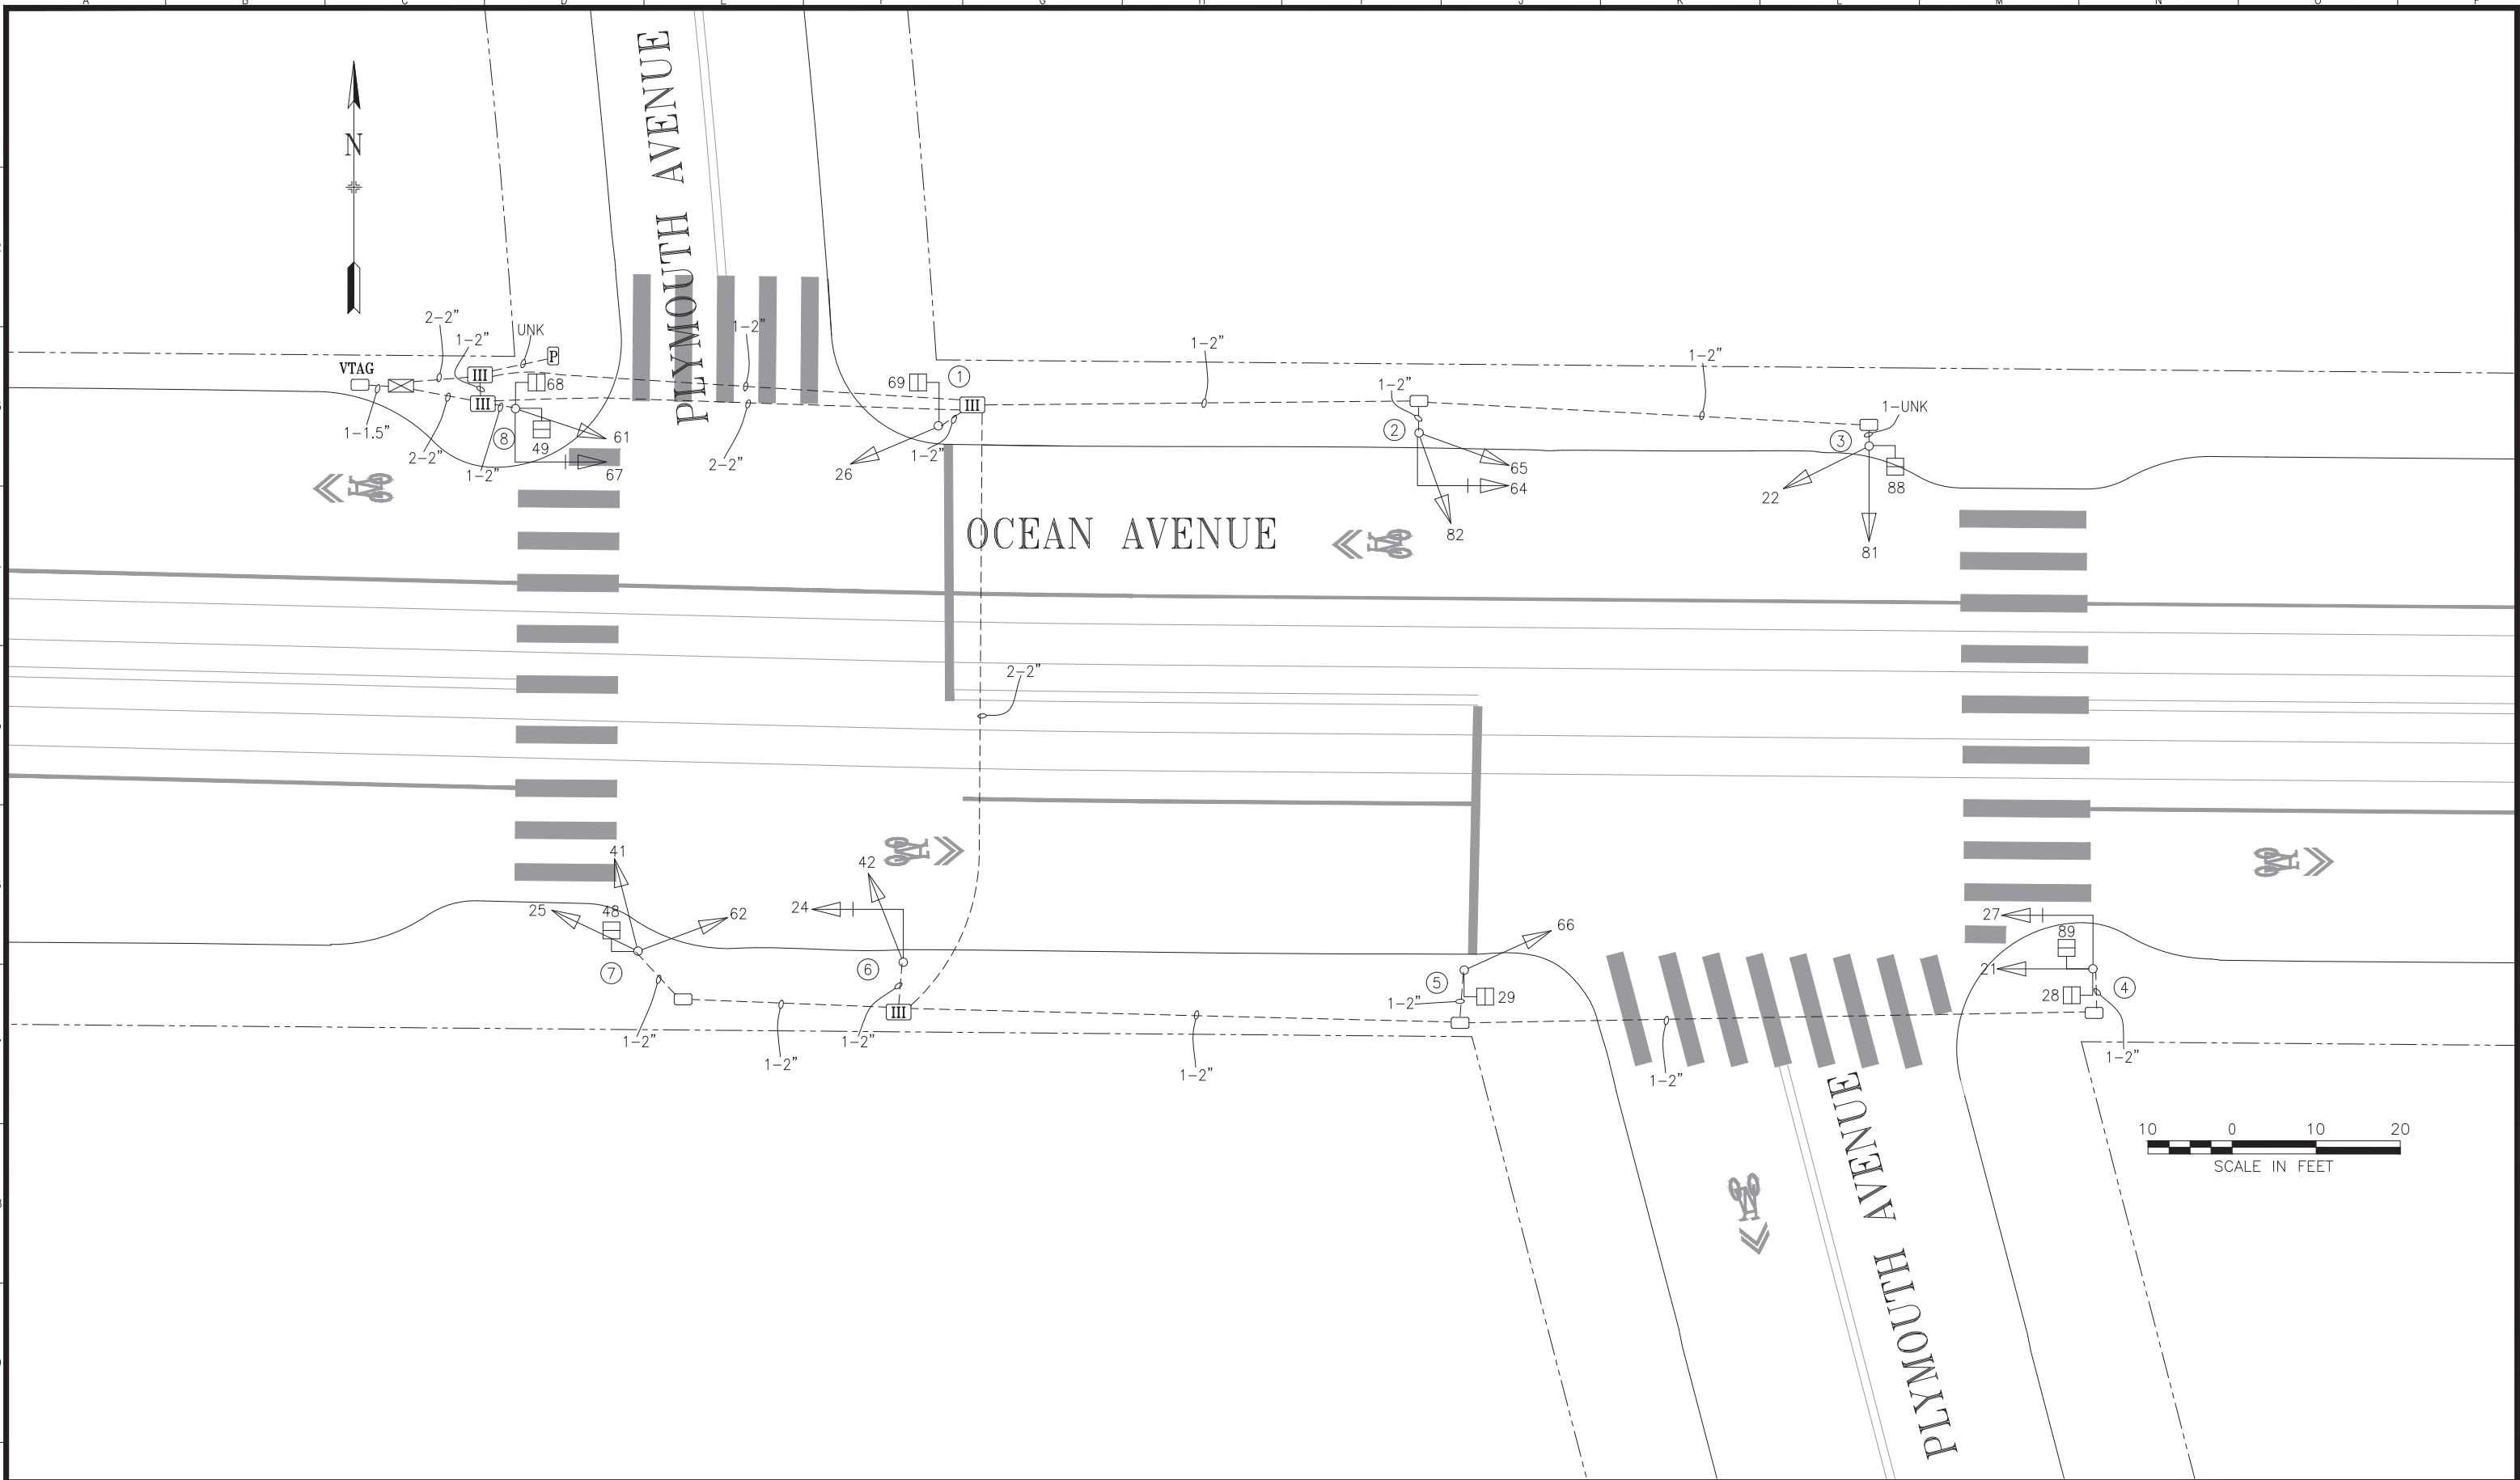

				REFERENCE INFORMATION & FILE NO. OF SURVEYS			SAN FRANCISCO MUNICIPAL TRANSPORTATION AGENCY				SCALE: AS SHOWN		TRAFFIC SIGNAL INVENTORY DIAGRAM		CNN NO. 22585000		
							CITY AND COUNTY OF SAN FRANCISCO				SHEET OF SHEETS 1 OF 2		OCEAN AVENUE AND PLYMOUTH AVENUE		REV NO. 1		
1 11/6/18		LENSES UPGRADED TO 12" PER SRC 2017-372		C.Skerrit B.Woo					DRAWN: DATE: C.SKERRIT 12/31/18								
0 12/5/02		SIGNAL UPGRADE BY MR-1130; CONVERTED FROM CONTRACT PLANS		BBD													
NO.		DATE		DESCRIPTION		BY		APP.									
TABLE OF REVISIONS																	
CHECK WITH TRACING TO SEE IF YOU HAVE LATEST REVISION																	

POLE AND EQUIPMENT SCHEDULE											
POLE No.	TYPE OF POLE	LUMINAIRE VOLTAGE/WATTAGE	VEHICLE SIGNAL					PEDESTRIAN SIGNAL			REMARKS
			No.	TYPE	MOUNTING	VISORS	LOUVERS	No.	TYPE	MOUNTING	
①	1-A (10')		26	3S12"	TV-1	T		69	1S-COUNT	SP-1	
②	16-1-70 WITH 8' MASTARM		65 82 64	3S12" 3S12" 3S12"	SV-2-TA MAS	T T T					BACKPLATE
③	CONCRETE STANDARD		22 81	3S12" 3S12"	TV-2-T	T T		88	1S-COUNT	SP-1	
④	16-1-70 WITH 8' MASTARM		21 27	3S12" PV3S12"	SV-1-T MAS	T C		28 89	1S-COUNT 1S-COUNT	SP-1 SP-1	BACKPLATE
⑤	1-A (10')		66	3S12"	TV-1	T		29	1S-COUNT	SP-1	
⑥	16-1-70 WITH 8' MASTARM		24 42	3S12" 3S12"	MAS SV-1-T	T T					BACKPLATE
⑦	1-A (10')		25 41 62	3S12" 3S12" 3S12"	TV-3-TA	T T T		48	1S-COUNT	SP-1	
⑧	16-1-70 WITH 8' MASTARM		61 67	3S12" PV3S12"	SV-1-T MAS	T C		49 68	1S-COUNT 1S-COUNT	SP-1 SP-1	BACKPLATE

						REFERENCE INFORMATION & FILE NO. OF SURVEYS	 SAN FRANCISCO MUNICIPAL TRANSPORTATION AGENCY CITY AND COUNTY OF SAN FRANCISCO			SCALE: AS SHOWN	TRAFFIC SIGNAL INVENTORY DIAGRAM	CNN NO. 22585000		
1	11/6/18	LENSES UPGRADED TO 12" PER SRC 2017-372	C.Skerrit	B.Woo				DRAWN: DATE:						
0	12/5/02	SIGNAL UPGRADE BY MR-1130; CONVERTED FROM CONTRACT PLANS	BBD					C.SKERRIT 12/31/18						
NO.	DATE	DESCRIPTION	BY	APP.				CHECKED: DATE:			SHEET OF SHEETS	OCEAN AVENUE AND PLYMOUTH AVENUE	REV NO.	
								G.DELEON 01/02/19		2 OF 2		1		
CHECK WITH TRACING TO SEE IF YOU HAVE LATEST REVISION														