


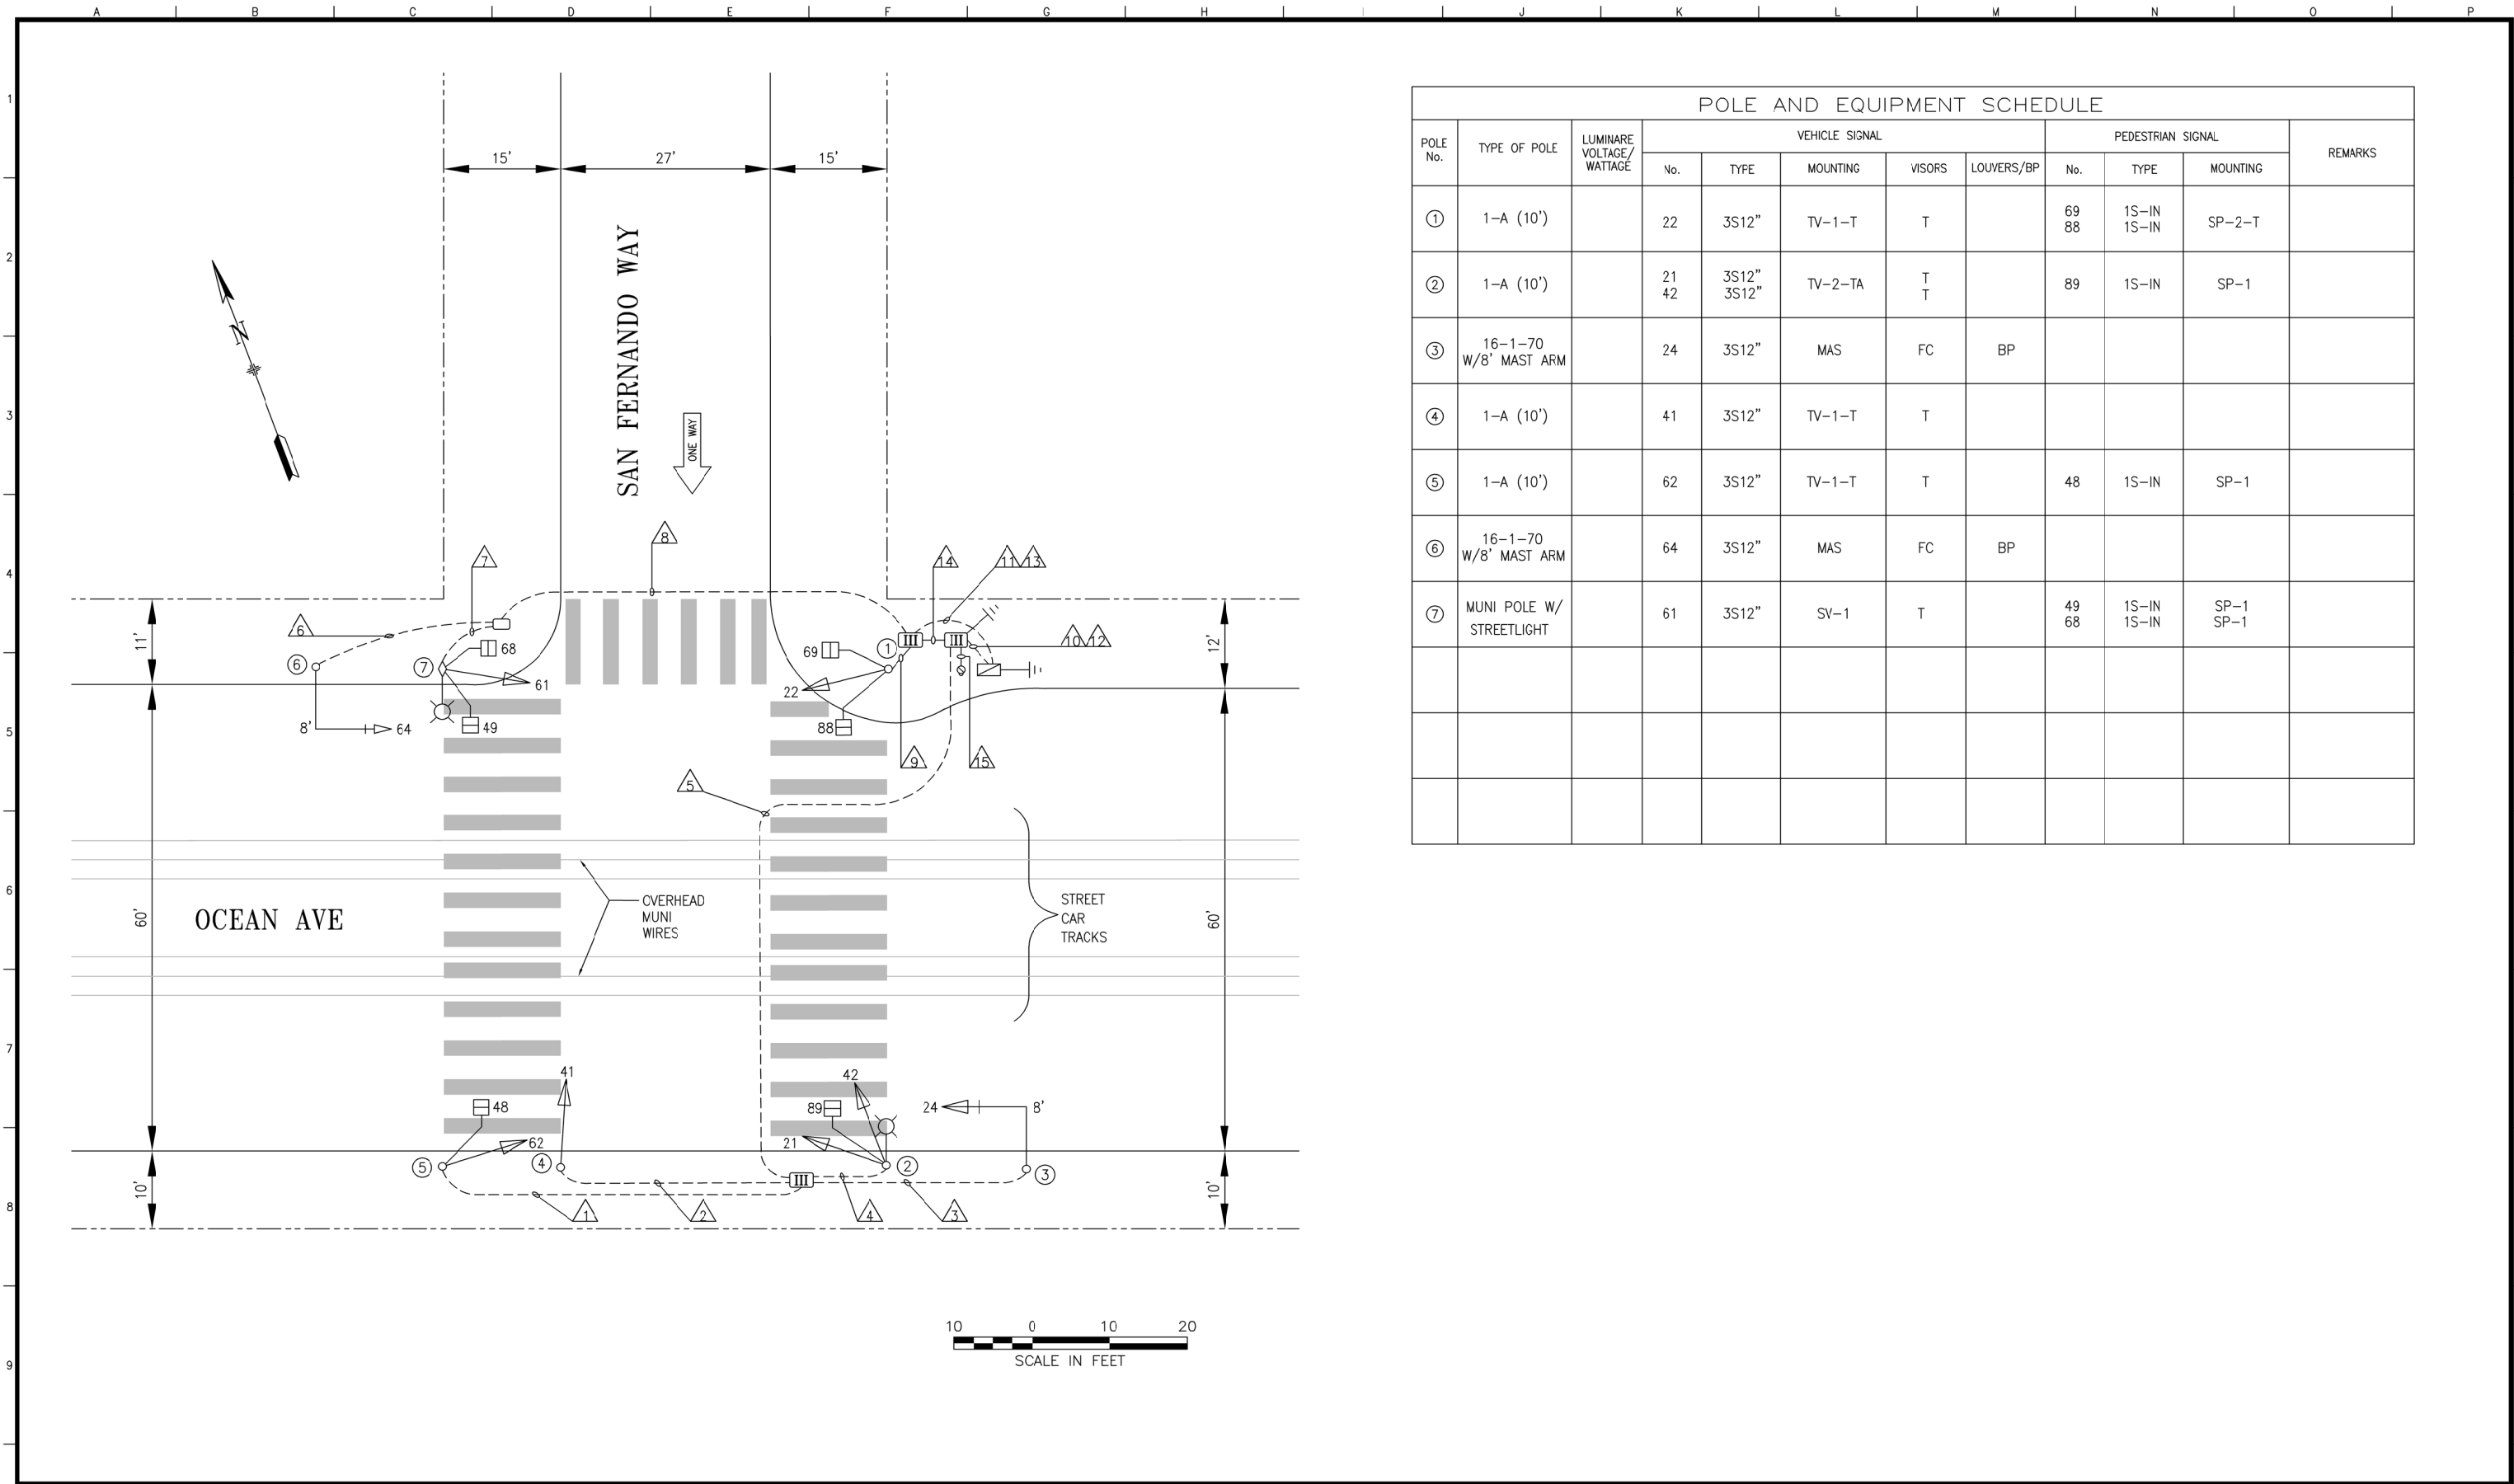

POLE AND EQUIPMENT SCHEDULE											
POLE No.	TYPE OF POLE	LUMINAIRE VOLTAGE/WATTAGE	VEHICLE SIGNAL					PEDESTRIAN SIGNAL			REMARKS
			No.	TYPE	MOUNTING	VISORS	LOUVERS/BP	No.	TYPE	MOUNTING	
①	1-A (10')		22	3S12"	TV-1-T	T		69 88	1S-IN 1S-IN	SP-2-T	
②	1-A (10')		21 42	3S12" 3S12"	TV-2-TA	T T		89	1S-IN	SP-1	
③	16-1-70 W/8' MAST ARM		24	3S12"	MAS	FC	BP				
④	1-A (10')		41	3S12"	TV-1-T	T					
⑤	1-A (10')		62	3S12"	TV-1-T	T		48	1S-IN	SP-1	
⑥	16-1-70 W/8' MAST ARM		64	3S12"	MAS	FC	BP				
⑦	MUNI POLE W/ STREETLIGHT		61	3S12"	SV-1	T		49 68	1S-IN 1S-IN	SP-1 SP-1	

3	05/10/19	12" SIGNALS BY SRC 2018-244	C SKERRIT	B WOO	
2	12/20/02	SIGNAL MODS BY MR-1130, CONVERTED FROM CONTRACT PLAN	C SKERRIT	B WOO	
1	01/97	NEW TRAFFIC SIGNALS CT48	C LEUNG	D WILLE SCHWENK	
NO.	DATE	DESCRIPTION	BY	APP.	
TABLE OF REVISIONS CHECK WITH TRACING TO SEE IF YOU HAVE LATEST REVISION					

REFERENCE INFORMATION & FILE NO. OF SURVEYS



SAN FRANCISCO MUNICIPAL TRANSPORTATION AGENCY

CITY AND COUNTY OF SAN FRANCISCO

DRAWN:	DATE:
C LEUNG	08/02/99
CHECKED:	DATE:
X XXX	XX/XX/XX

SCALE:
AS SHOWN
SHEET OF SHEETS
1 OF 2

TRAFFIC SIGNAL INVENTORY DIAGRAM
OCEAN AVENUE AND SAN FERNANDO WAY

CNN NO.
22795000
REV NO.
3

