



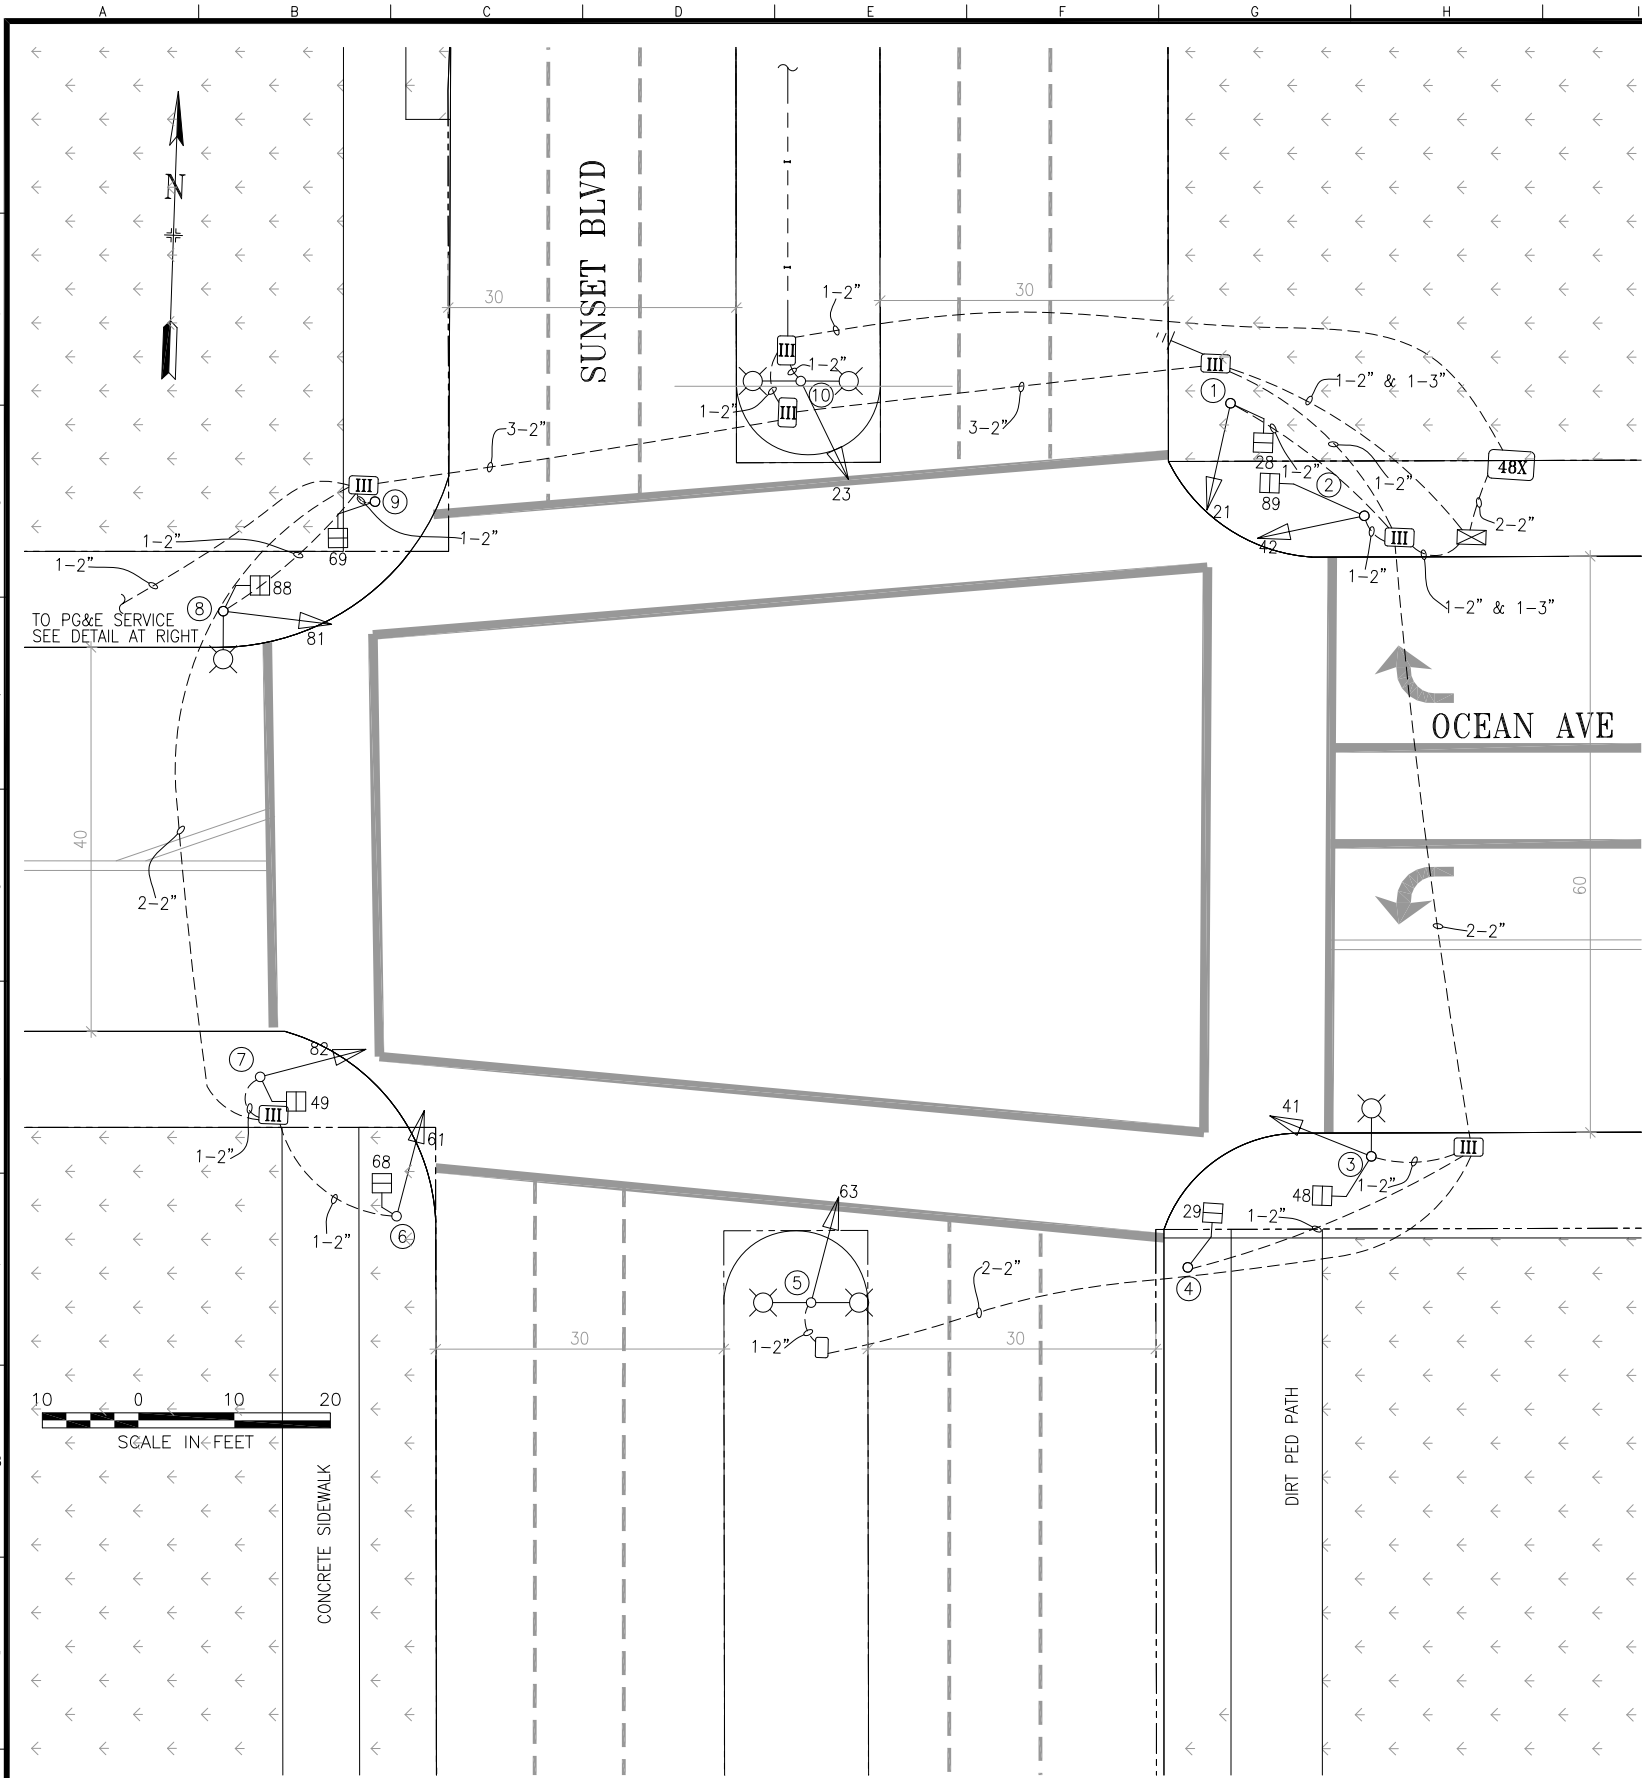

POLE AND EQUIPMENT SCHEDULE											
POLE No.	TYPE OF POLE	LUMINAIRE VOLTAGE/ WATTAGE	VEHICLE SIGNAL					PEDESTRIAN SIGNAL			REMARKS
			No.	TYPE	MOUNTING	VISORS	LOUVERS	No.	TYPE	MOUNTING	
①	1-A (10')		21	3S12"	TV-1-T	T		28	1S-COUNT	SP-1 (22")	
②	1-A (10')		42	3S12"	TV-1-T	T		89	1S-COUNT	SP-1	
③	CITY STANDARD STREET LIGHT	120V/150W	41	3S12"	SV-1-T	T		48	1S-COUNT	SP-1	
④	1-A (7')							29	1S-COUNT	TP-1	
⑤	MARBELITE SL W/ DUAL LUMINAIRE ARMS		63	3S12"	SV-1	T					
⑥	1-A (10')		61	3S12"	TV-1-T	T		68	1S-COUNT	SP-1 (22")	
⑦	1-A (10')		82	3S12"	TV-1-T	T		49	1S-COUNT	SP-1	
⑧	CITY STANDARD STREET LIGHT	120V/150W	81	3S12"	SV-1-T	T		88	1S-COUNT	SP-1	
⑨	1-A (7')							69	1S-COUNT	TP-1	
⑩	MARBELITE SL W/ DUAL LUMINAIRE ARMS		23	3S12"	SV-1	T					

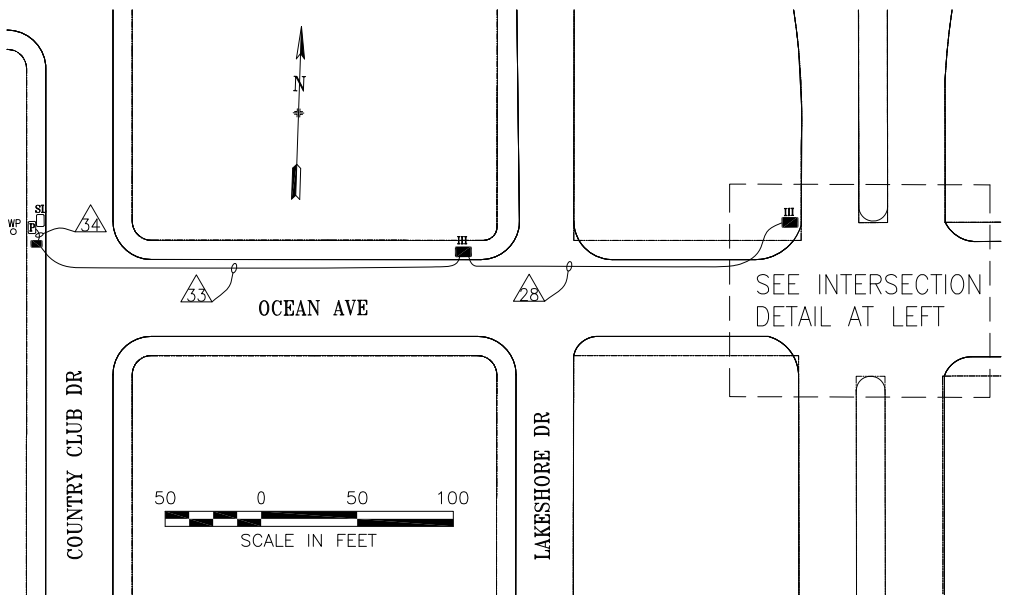

SERVICE CONNECTION WIRING DETAIL
NOT TO SCALE

TABLE OF REVISIONS		CHECK WITH TRACING TO SEE IF YOU HAVE LATEST REVISION	
NO.	DATE	DESCRIPTION	BY APP.
0	7/16/14	ACTIVATED THRU 2142J; CONVERTED FROM AS-BUILTS	JH GD

REFERENCE INFORMATION
& FILE NO. OF SURVEYS



SAN FRANCISCO MUNICIPAL TRANSPORTATION AGENCY
CITY AND COUNTY OF SAN FRANCISCO

DRAWN: DATE:
JH 06/2016
CHECKED: DATE:
GD 06/2016

SCALE:
AS SHOWN
SHEET OF SHEETS
1 OF 1

TRAFFIC SIGNAL INVENTORY DIAGRAM

OCEAN AVENUE AND SUNSET BOULEVARD

CNN NO.
23313000
REV NO.
0