


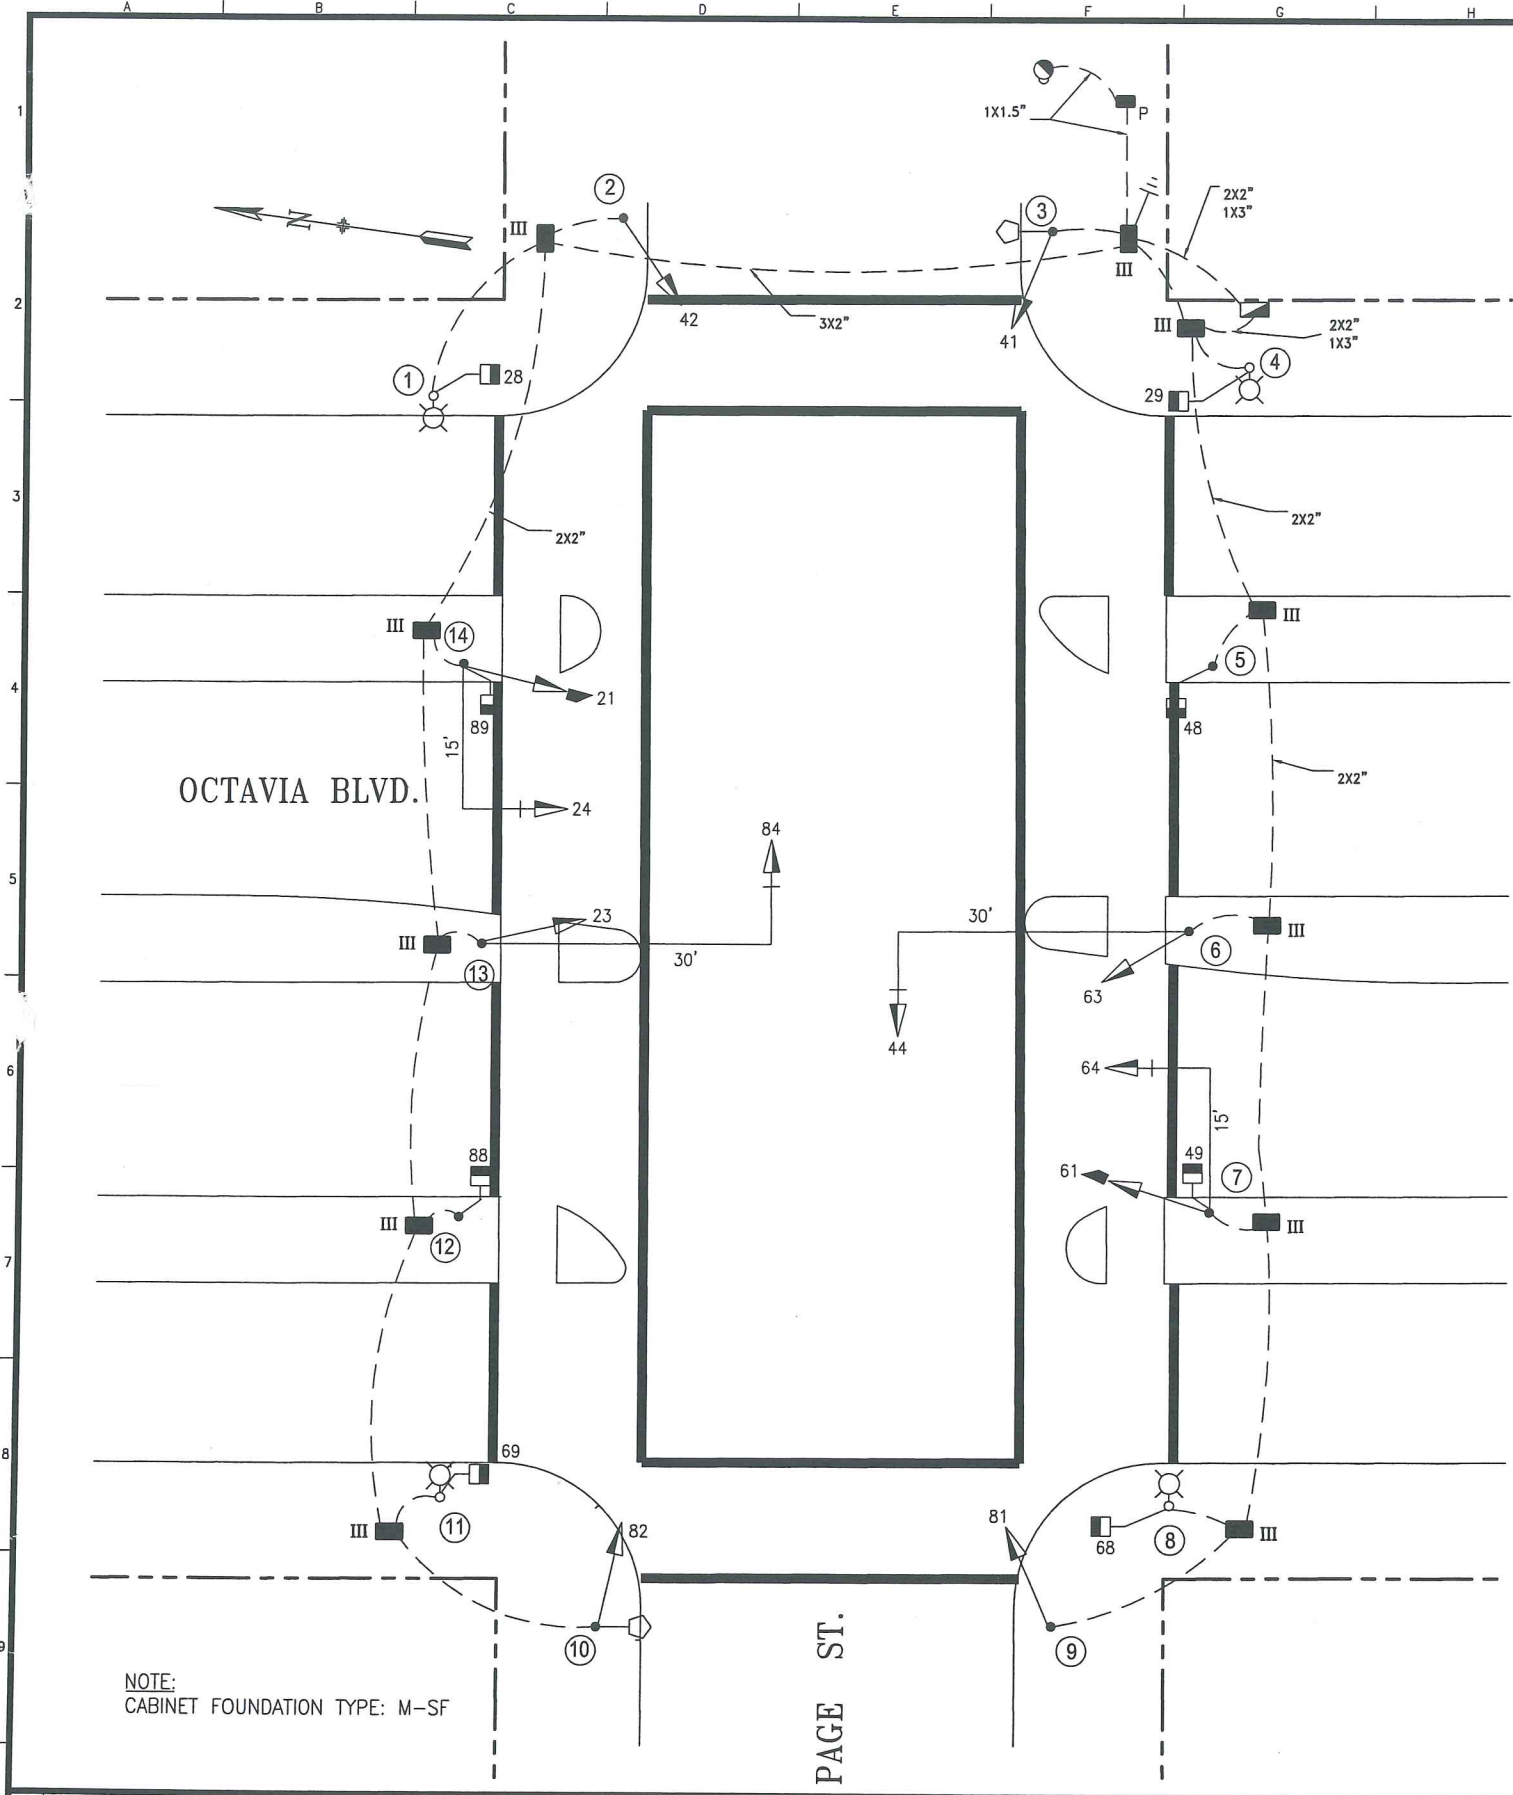

POLE AND EQUIPMENT SCHEDULE									
POLE NO.	TYPE OF POLE	LUMINAIRE (HPS) VOLTAGE/ WATTS	VEHICLE SIGNAL			PEDESTRIAN SIGNAL			REMARKS
			No.	TYPE	MOUNTING (F/I)	No.	TYPE	MOUNTING (F/I)	
①	16'-5" STREETLIGHT					28	1S-C	SP-1-T	
②	MUNI POLE 765N		42	3S12"	SV-1-TA				
③	MUNI POLE 765N WITH 6' LA		41	3S12"	SV-1-T				
④	16'-5" STREETLIGHT		-	-	-	29	1S-C	SP-1-T	
⑤	TYPE 1-A (7')		-	-	-	48	1S-C	TP-1-T	
⑥	MUNI POLE 767 WITH 30' MA		44 63	3S12" 3S12"	SV-1-T MAS	-	-	-	
⑦	16-1-70 w/15' MA		64 61	3S12" 3S12"	MAS SV-1-T	49	1S-C	SP-1-T	ANGLE VISOR
⑧	16'-5" STREETLIGHT					68	1S-C	SP-1-T	
⑨	MUNI POLE 765N		81	3S12"	SV-1-T				
⑩	MUNI POLE 765N WITH 6' LA		82	3S12"	SV-1-T				
⑪	16'-5" STREETLIGHT		-	-	-	69	1S-C	SP-1-T	
⑫	TYPE 1-A (7')		-	-	-	88	1S-C	TP-1-T	
⑬	MUNI POLE 767 WITH 30' MA		84 23	3S12" 3S12"	MAS SV-1-T	-	-	-	
⑭	16-1-70 w/15' MA		21 24	3S12" 3S12"	SV-1-T MAS	89	1S-C	SP-1-T	ANGLE VISOR

1 8/3/05		OCTAVIA BOULEVARD OPENING								DRAWN: DATE: SCALE: DY 12/05 1":10'		TRAFFIC SIGNAL INVENTORY DIAGRAM		CNN NO. 25909000	
NO. DATE		DESCRIPTION		BY APP.		COMPLETION DATE / ELECTRICIAN INITIAL		DEPARTMENT OF PARKING AND TRAFFIC		DIVISION OF TRAFFIC ENGINEERING		OCTAVIA BLVD AND PAGE ST		REV. NO.	
		TABLE OF REVISIONS						CITY AND COUNTY OF SAN FRANCISCO		SHEET OF SHEETS 1 OF 1					
		CHECK WITH TRACING TO SEE IF YOU HAVE LATEST REVISION													

Drawing Path: I:\E-FILES\Construction Section\PERSONNEL\Yueing\Octavia_Page.dwg, Login: CHENNESSY
Plot Time: Thu, 22 Dec 2005 - 5:26pm
Signal Inventory Diagram Title Block [C:\Documents and Settings\dpt user\Desktop\Signal Inventory Diagram Title Block.dwg]
CALTRANS_FDTN [U:\2020N\Octavia Blvd\2 Design\Working Drawings\Project Base\CALTRANS_FDTN.dwg]
CALTRANS_ALIGN [CALTRANS_ALIGN.dwg]
Measurement Units are English
Dimension Scale: 20 Model Units: Feet
5:26pm