


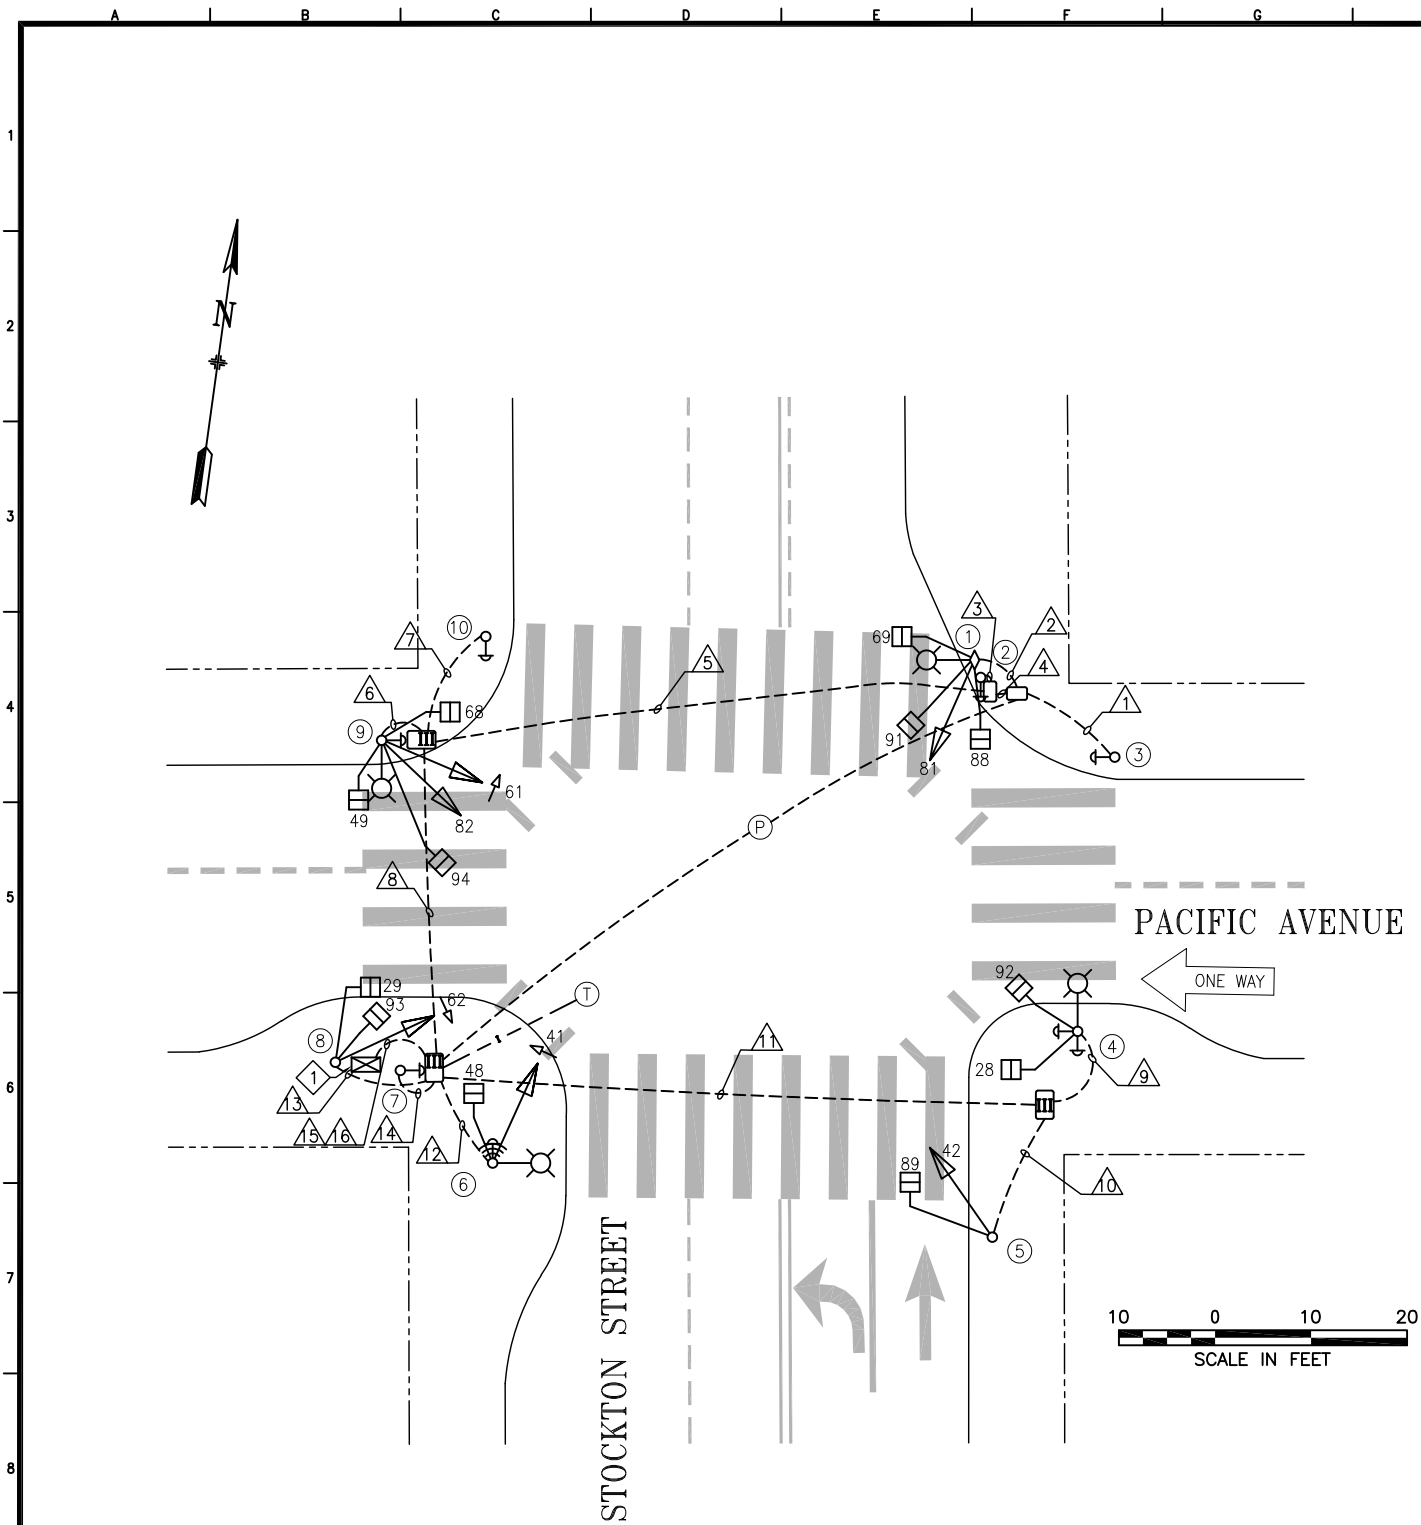

POLE AND EQUIPMENT SCHEDULE										
POLE No.	TYPE OF POLE	VEHICLE SIGNAL					PEDESTRIAN SIGNAL			REMARKS
		No.	TYPE	MOUNTING	VISORS	LOUVERS/BP	No.	TYPE	MOUNTING	
①	MUNI WITH SL	81	3S12"	SV-1-T			69 88 91	1S-COUNT 1S-COUNT 1S-COUNT	CUSTOM MOUNT SP-3-T-SF	
②	PEDESTRIAN PUSH BUTTON									APS-3W
③	PEDESTRIAN PUSH BUTTON									APS-3W
④	STEEL SL						28 92	1S-COUNT 1S-COUNT	SP-1(22") SP-1-SF(12")	APS-3W x 2
⑤	1-A (10')	42	3S12"	TV-1-T			89	1S-COUNT	SP-1	
⑥	STEEL SL	41	4S12"-GRA	SV-1-T			48	1S-COUNT	SP-1	APS-3W TSP EQUIPMENT
⑦	PEDESTRIAN PUSH BUTTON									APS-3W
⑧	1-A (10')	62	4S12"-GLA	TV-1-T			29 93	1S-COUNT 1S-COUNT	SP-1(22") SP-1-SF(12")	
⑨	STEEL SL	61 82	4S12"-GRA 3S12"	SV-2-TA			49 68 94	1S-COUNT 1S-COUNT 1S-COUNT	SP-1 SP-2-T-SF	SL OVERHEAD FED APS-3W
⑩	PEDESTRIAN PUSH BUTTON									APS-3W

SHEET NOTES:
① M-CABINET AND ADAPTER PLATE.

Δ	06/07/21	APS INSTALLED PER SRC 2021-093	E. TRAN	D. VALLE-SCHWENK	
Δ	03/12/21	CONVERTED FROM CONTRACT 2483J, CONTRACT 1987N	E. TRAN	D. VALLE-SCHWENK	
NO.	DATE	DESCRIPTION	BY	APPROVED	
TABLE OF REVISIONS					
CHECKOUT DRAWING THROUGH THE SID CUSTODIAN FOR THE LATEST REVISION					



SFMTA

DRAWN BY:	DATE:
E. TRAN	04/07/2022
CHECKED BY:	DATE:
D. VALLE-SCHWENK	04/07/2022

SCALE
AS SHOWN
SHEET OF SHEETS
1 OF 2

TRAFFIC SIGNAL INVENTORY DIAGRAM
PACIFIC AVENUE & STOCKTON STREET

CNN NO:
25053000
REV NO:
1

	A	B	C	D	E	F	G	H	I	J	K	L	M	N	O	P																			
	CONDUIT AND WIRING SCHEDULE (FURNISH AND INSTALL CONDUIT AND WIRES)																																		
1	CONDUIT RUN NUMBER	△1	△2	△3	△4	△5	△6	△7	△8	△9	△10	△11	△12	△13	△14	△15	△16																		
	CONDUIT SIZE (INCH)	2	1.5	UNK	UNK	2	2	2	2	2	2	2	2	2	2	2	2																		
	NOTES		GRS				GRS			GRS			GRS																						
	APS PPB XING PACIFIC ON POLE 3	3	3																																
2	VEHICLE SIGNAL 81		3		3	3			3							3																			
	PED SIGNAL 69		2		2	2			2							2																			
	PED SIGNAL 88		2		2	2			2							2																			
	PED SIGNAL 91		2		2	2			2							2																			
	APS PPB XING STOCKTON ON POLE 2		3	3	3																														
3	VEHICLE SIGNAL 61						4		4							4																			
	VEHICLE SIGNAL 82						3		3							3																			
	PED SIGNAL 49						2		2							2																			
	PED SIGNAL 68						2		2							2																			
	PED SIGNAL 94						2		2							2																			
	APS PPB XING PACIFIC ON POLE 9						3																												
4	APS PPB XING PACIFIC ON POLE 10						3	3																											
	PED SIGNAL 28									2		2				2																			
	PED SIGNAL 92									2		2				2																			
	APS PPB XING STOCKTON ON POLE 4									3																									
	APS PPB XING PACIFIC ON POLE 4									3	3																								
5	VEHICLE SIGNAL 42										3	3				3																			
	PED SIGNAL 89										2	2				2																			
	VEHICLE SIGNAL 41												4			4																			
	PED SIGNAL 48												2			2																			
	APS PPB XING STOCKTON ON POLE 6												3	3																					
6	VEHICLE SIGNAL 62													4		4																			
	PED SIGNAL 29													2		2																			
	PED SIGNAL 93													2		2																			
	APS PPB XING PACIFIC ON POLE 7												3		3																				
7																																			
	#14 NEUTRAL		2				3			2	2		2	3																					
	#14 SPARE					3			3			3																							
	TOTAL #14 WIRES	3	17	3	12	12	22	3	25	12	10	12	14	14	3	21	23																		
	#10 NEUTRAL					1			2			2			3	2																			
	#10 WIRES STREETLIGHT		2						2				2																						
8	1/4" PULL ROPE					1			1																										
9																																			

[illegible]