


PARNASSUS W/HILLWAY

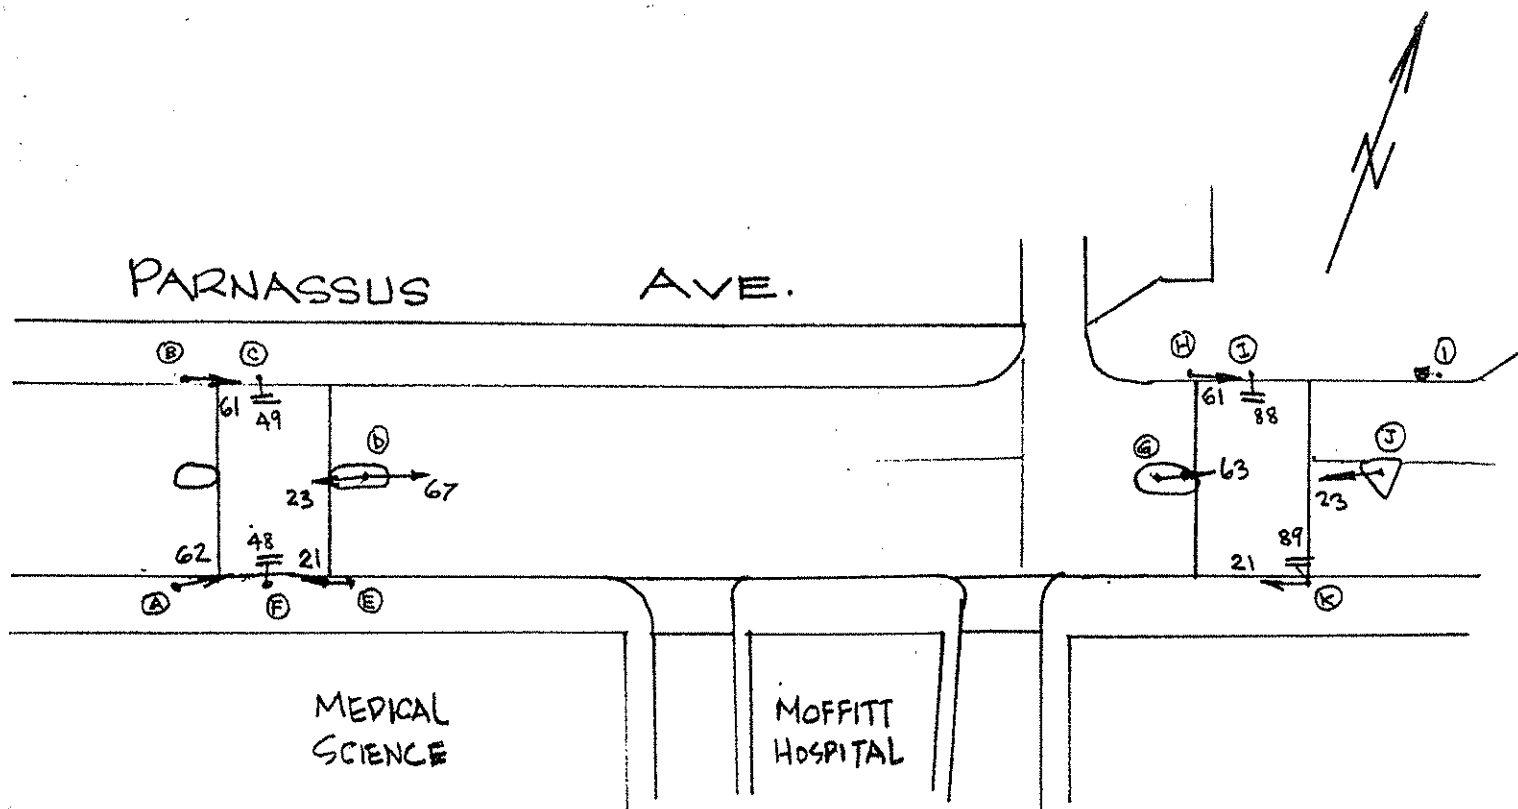

φ2 →

11/1/00

POLE	FUNC.	MAT'L	SIGNAL NO.	MAKE	NO. OF SECT.	SIZE	VISOR	B.P. OR LOUVERS	MOUNT	PED SIGNAL NO.	LEGEND	MESSAGE		MAKE	MOUNT
												ELEMENT	COLOR		
A	M	S	62	EC	3	8"	FC 8"	No	S	48	W/DW	GRD	W/CR	ED	T
B	M	S	61	EC	3	8"	FC 8"	No	S	49	W/DW	GRD	W/CR	ED	T
C	S	C	23	TCT	3	12"	T	No	T	88	W/DW	GRD	W/CR	ED	T
D	S	C	21	EC	3	12" 5+6	FC 12"	No	T	89	W/DW	GRD	W/CR	ED	S
E	S	C	63	TCT	3	12"	T	No	T						
F	S	C	61	EC	3	12" 5+6	FC 12"	No	S						
G	S	C	23	EC	3	8"	FC 8"	No	T						
H	M	S	21	EC	3	8"	FC 8"	No	T						
I	S	C	67	TCT	3	12"	T	No	T						
J	S	C													
K	S	C													
I	M	S													

CONTROLLER CABINET SIZE : ORDINARY BASE CABINET: YES

COMMENTS :