


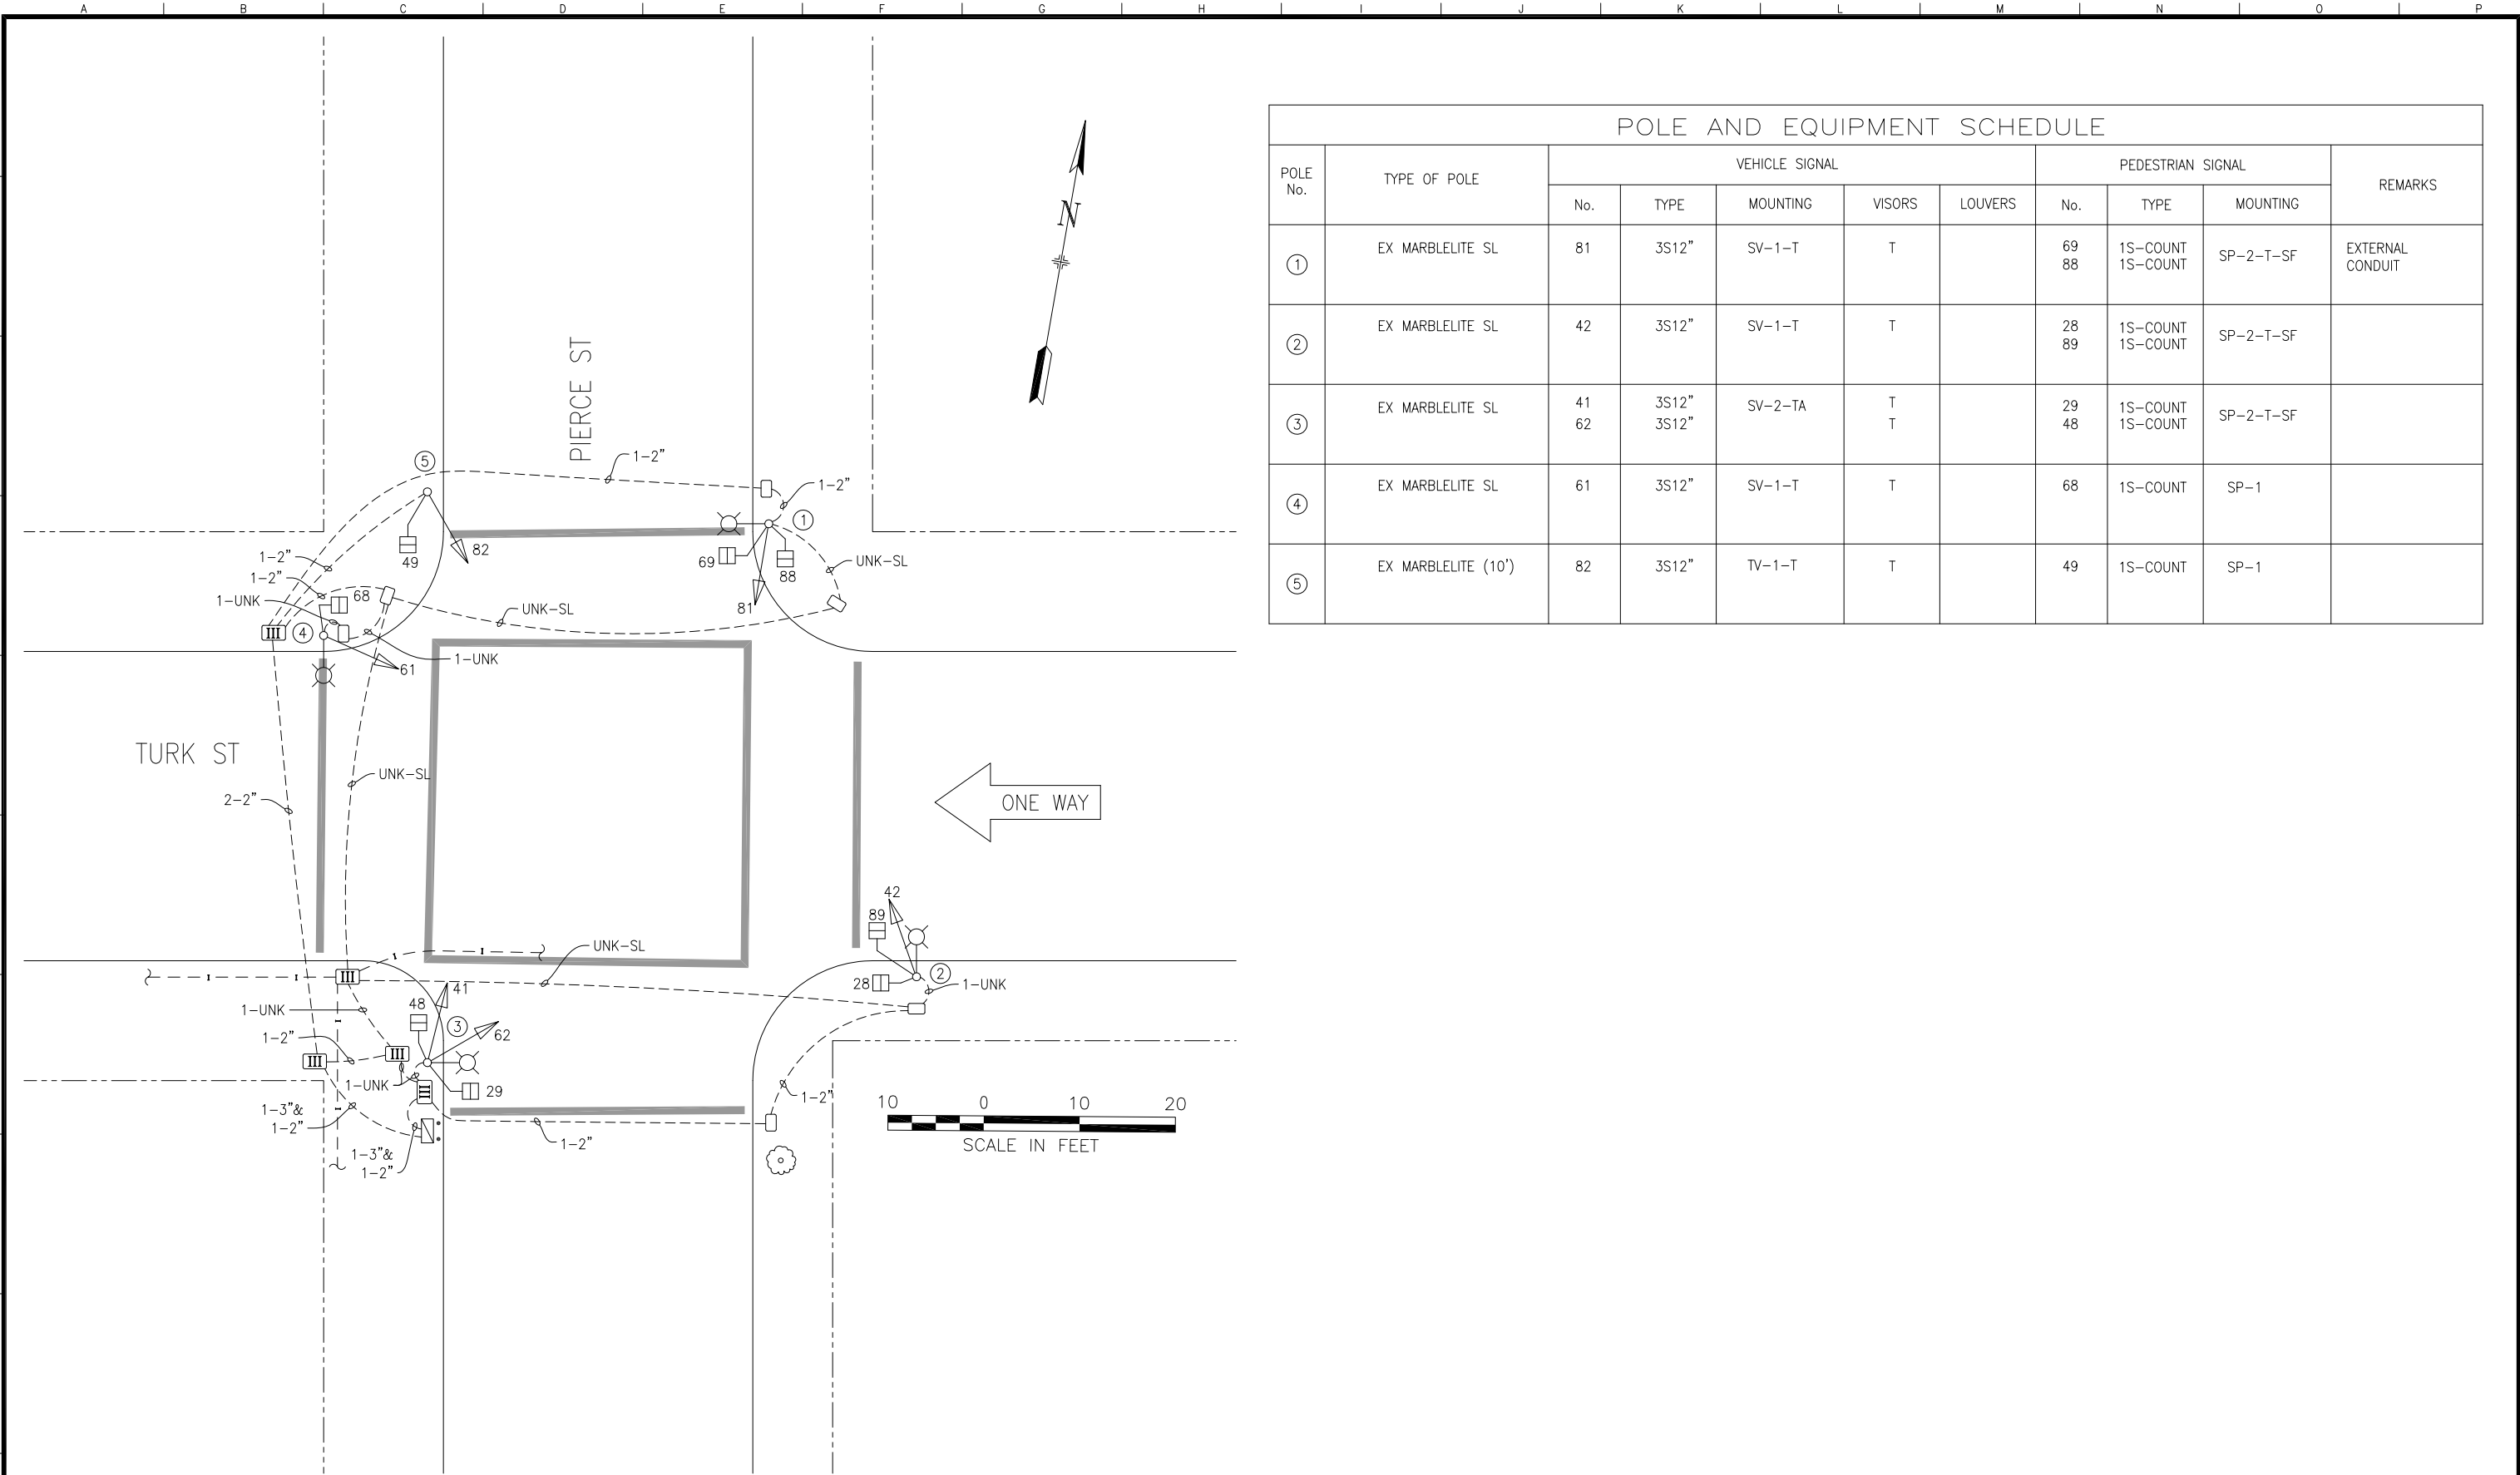

POLE AND EQUIPMENT SCHEDULE										
POLE No.	TYPE OF POLE	VEHICLE SIGNAL					PEDESTRIAN SIGNAL			REMARKS
		No.	TYPE	MOUNTING	VISORS	LOUVERS	No.	TYPE	MOUNTING	
①	EX MARBLELITE SL	81	3S12"	SV-1-T	T		69 88	1S-COUNT 1S-COUNT	SP-2-T-SF	EXTERNAL CONDUIT
②	EX MARBLELITE SL	42	3S12"	SV-1-T	T		28 89	1S-COUNT 1S-COUNT	SP-2-T-SF	
③	EX MARBLELITE SL	41 62	3S12" 3S12"	SV-2-TA	T T		29 48	1S-COUNT 1S-COUNT	SP-2-T-SF	
④	EX MARBLELITE SL	61	3S12"	SV-1-T	T		68	1S-COUNT	SP-1	
⑤	EX MARBLELITE (10')	82	3S12"	TV-1-T	T		49	1S-COUNT	SP-1	

1	08/31/17	SRC 2017-217, UPGRADE ALL LENSES TO 12"	CS2	BW	
0	12/10/08	MOD ACTIVATED BY 0895J; CONVERTED FROM AS-BUILTS	JH	GD	
NO.	DATE	DESCRIPTION	BY	APP.	

TABLE OF REVISIONS
CHECK WITH TRACING TO SEE IF YOU HAVE LATEST REVISION

REFERENCE INFORMATION
& FILE NO. OF SURVEYS



SAN FRANCISCO MUNICIPAL TRANSPORTATION AGENCY
CITY AND COUNTY OF SAN FRANCISCO

DRAWN:	DATE:
JH	11/17
CHECKED:	DATE:
GD	11/17

SCALE:

AS SHOWN

SHEET OF SHEETS

01 OF 01

TRAFFIC SIGNAL INVENTORY DIAGRAM

PIERCE ST & TURK ST

CNN NO.

26047000

REV NO.

1