


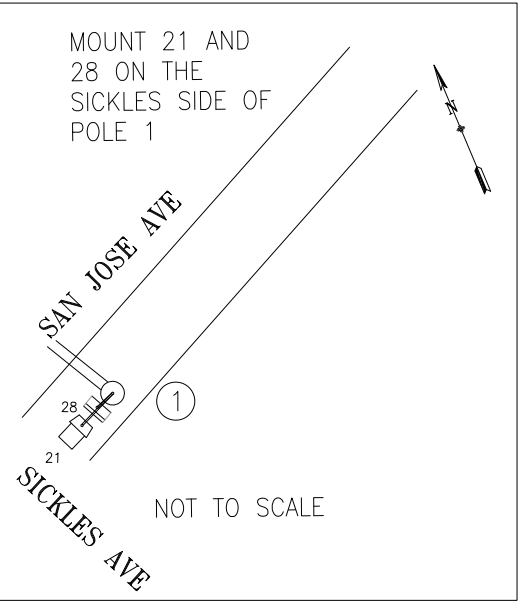


TABLE OF REVISIONS			CHECKOUT DRAWING THROUGH THE SID CUSTODIAN FOR THE LATEST REVISION		
NO.	DATE	DESCRIPTION	BY	APPROVED	
1	4/5/22	NEW APS & 4 PPB POSTS PER 2021-342 & CALTRANS PROJECT.	DYeung	GdeLeon	
0	7/24/14	MOD ACTIVATED THRU 2108J; CONVERTED FROM CONTRACT PLANS	JHornbostel	MVelasco	

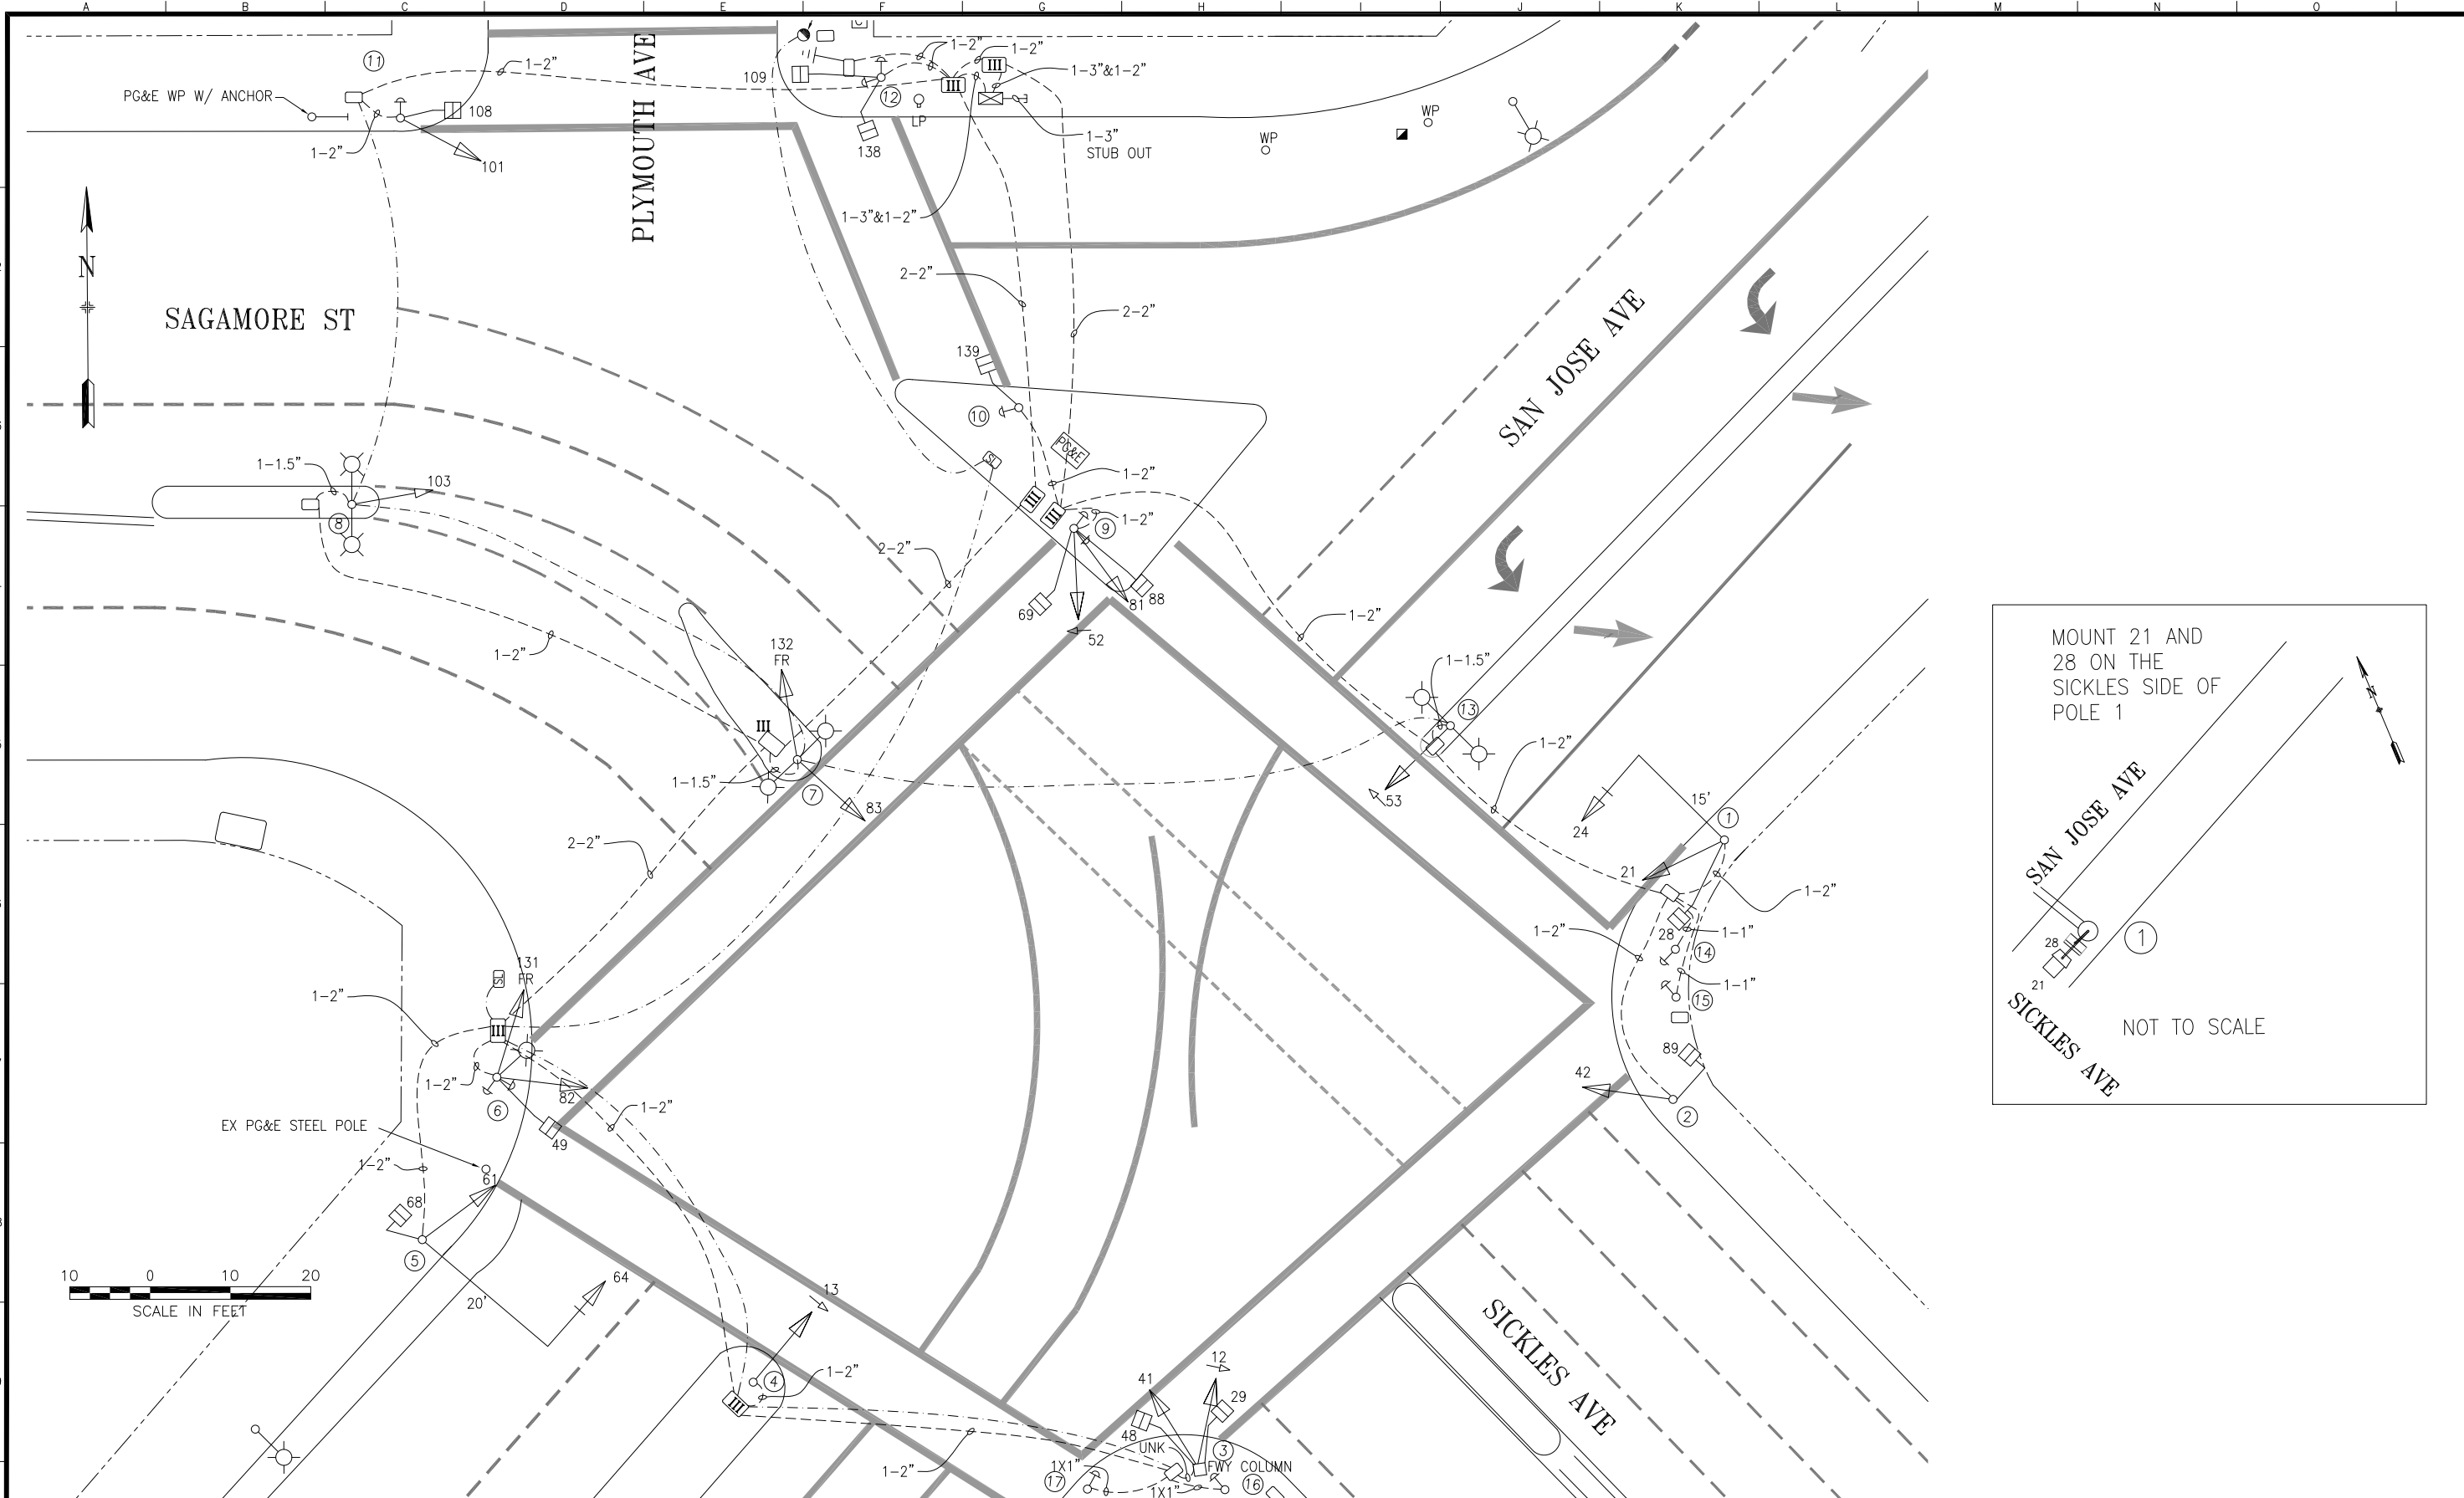

DRAWN BY:	DATE:
JH	09/2015
CHECKED BY:	DATE:
MV	09/2015

SCALE
AS SHOWN
SHEET OF SHEETS
1 OF 2

TRAFFIC SIGNAL INVENTORY DIAGRAM
PLYMOUTH ST, SAGAMORE ST, SAN JOSE AVE AND SICKLES AVE

CNN NO:
33722000
REV NO:
1

1	A	B	C	D	E	F	G	H	I	J	K	L	M	N	O	P	1
2																	2
3																	3
4																	4
5																	5
6																	6
7																	7
8																	8
9																	9

POLE AND EQUIPMENT SCHEDULE											
POLE No.	TYPE OF POLE	LUMINAIRE VOLTAGE/ WATTAGE	VEHICLE SIGNAL					PEDESTRIAN SIGNAL			REMARKS
			No.	TYPE	MOUNTING	VISORS	LOUVERS	No.	TYPE	MOUNTING	
①	16-1-100 W/ 15' MAST ARM		24 21	3S12" 3S12"	MAS SV-1	T T		28	1S-COUNT	SP-1	BACKPLATE MOUNT 21 & 28 ON SICKLES SIDE OF POLE
②	1-A (10')		42	3S12"	TV-1-T	T		89	1S-COUNT	SP-1	
③	CALTRANS COLUMN		12 41	3S12"LA 3S12"	MODIFIED SV-2-TA			29 48	1S-COUNT 1S-COUNT	MODIFIED SP-2-T	REUSE EXISTING MOUNTING FOR 12 & 41
④	1-A (10')		13	3S12"LA	TV-1-T						
⑤	16-1-100 W/ 20' MAST ARM		64 61	3S12" 3S12"	MAS SV-1-T	T T		68	1S-COUNT	SP-1	BACKPLATE
⑥	CITY STANDARD STREET LIGHT WITH 6' LUMINAIRE ARM	120V/ 150W	131 82	3S12"FR 3S12"	SV-2-TA			49	1S-COUNT	SP-1	APS-3W APS-3W
⑦	MARBELITE STREETLIGHT		132 83	3S12"FR 3S12"	SV-2-TA						
⑧	MARBELITE STREETLIGHT		103	3S8"	SV-1						
⑨	1-A (10')		81 52	3S12" 3S12LA"	TV-2-T			69 88	1S-COUNT 1S-COUNT	SP-1 SP-1	APS-3W APS-3W
⑩	1-A (7')							139	1S-COUNT	TP-1	APS-3W
⑪	1-A (10')		101	3S12"	TV-1-T			108	1S-COUNT	SP-1	APS-3W
⑫	1-A (7')							109 138	1S-COUNT 1S-COUNT	TP-2-T	APS-3W APS-3W
⑬	MARBELITE STREETLIGHT		53	3S12"LA	SV-1-T						
⑭	PPB POST										APS-3W
⑮	PPB POST										APS-3W
⑯	PPB POST										APS-3W
⑰	PPB POST										APS-3W

1	4/5/22	NEW APS & 4 PPB POSTS PER 2021-342 & CALTRANS PROJECT, PER FIELD: SV-1(POLE 8) & NO EXT CONDUIT ON SL	DYeung	GdeLeon	
0	7/24/14	MOD ACTIVATED THRU 2108J; CONVERTED FROM CONTRACT PLANS	JHornbostel	MVelasco	
NO.	DATE	DESCRIPTION	BY	APPROVED	

TABLE OF REVISIONS
CHECKOUT DRAWING THROUGH THE SID CUSTODIAN FOR THE LATEST REVISION



DRAWN BY: JH	DATE: 09/2015
CHECKED BY: MV	DATE: 09/2015

SCALE	NO SCALE
SHEET OF SHEETS	2 OF 2

TRAFFIC SIGNAL INVENTORY DIAGRAM	CNN NO: 33722000
PLYMOUTH ST, SAGAMORE ST, SAN JOSE AVE AND SICKLES AVE POLE AND EQUIPMENT SCHEDULE	REV NO: 1