


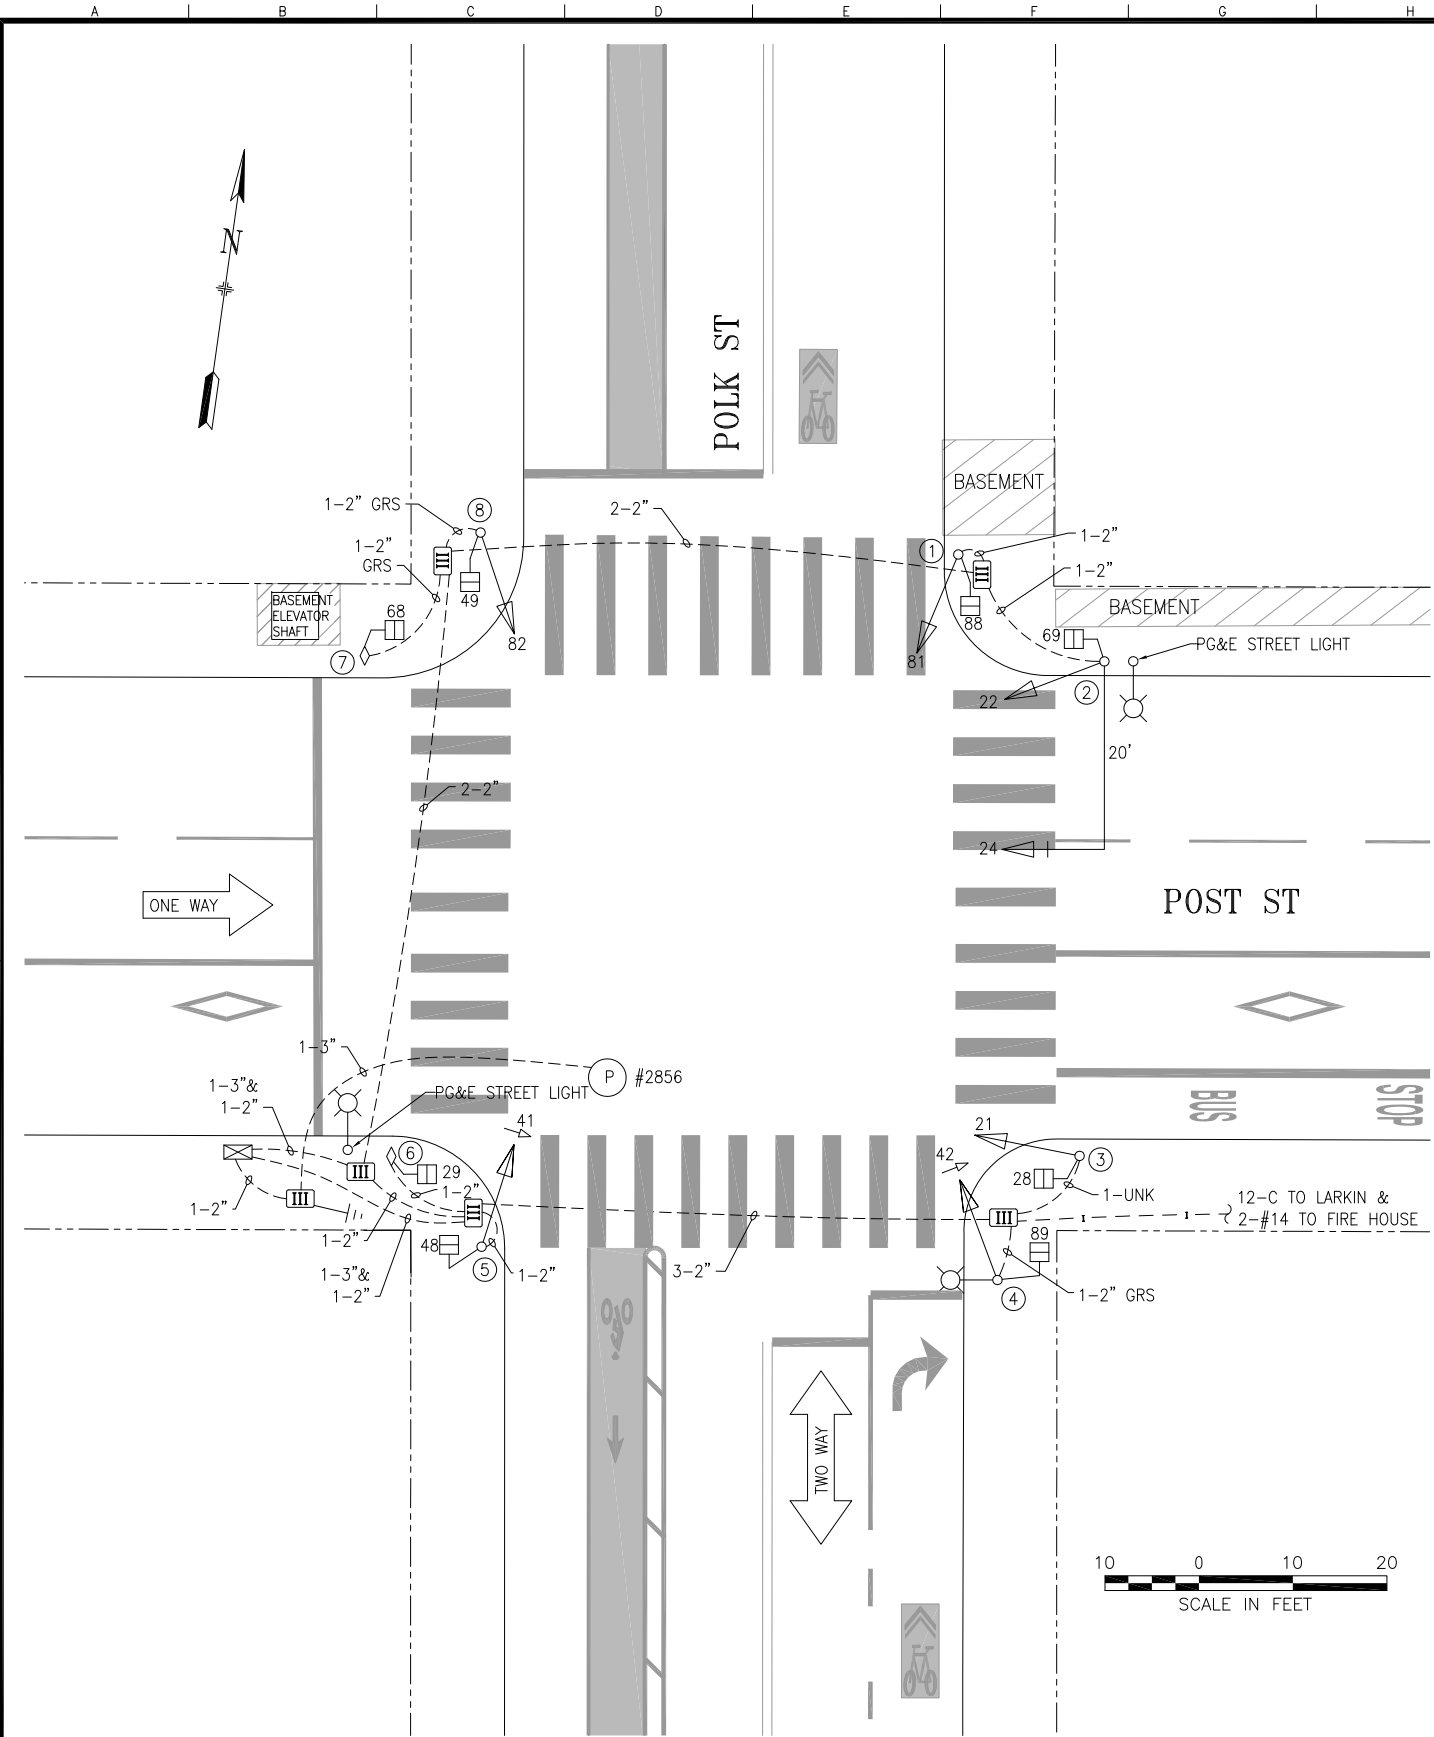

POLE AND EQUIPMENT SCHEDULE											
POLE No.	TYPE OF POLE	LUMINAIRE VOLTAGE/ WATTAGE	VEHICLE SIGNAL					PEDESTRIAN SIGNAL			REMARKS
			No.	TYPE	MOUNTING	VISORS	LOUVERS	No.	TYPE	MOUNTING	
①	1-A (10')		81	3S12"	TV-1-T	T		88	1S-COUNT	SP-1	
②	16-2-100 W/ 20' MAST ARM		22 24	3S12" 3S12"	SV-1-T MAS	T T		69	1S-COUNT	SP-1	BACKPLATE
③	1-A (10')		21	3S12"	TV-1-T	T		28	1S-COUNT	SP-1	MOUNT 21 @ 45 DEGREES
④	ORNAMENTAL STREET LIGHT		42	4S12"GLA	SV-1-T	T		89	1S-COUNT	SP-1	
⑤	1-A (10')		41	4S12"GLA	TV-1-T	T		48	1S-COUNT	SP-1	
⑥	MUNI POLE							29	1S-COUNT	SP-1-T	EXTERNAL CONDUIT
⑦	MUNI POLE							68	1S-COUNT	SP-1-T	EXTERNAL CONDUIT
⑧	ORNAMENTAL STREET LIGHT		82	3S12"	SV-1-T	T		49	1S-COUNT	SP-1	

TABLE OF REVISIONS			
1	12/6/18	2126J PUNCH LIST INSPECTION-POLES 4 & 8 REPLACED	JH GD
0	8/3/17	FULL UPGRADE BY 2586J; CONVERTED FROM AS-BUILTS	JH GD
NO.	DATE	DESCRIPTION	BY APP.
CHECK WITH TRACING TO SEE IF YOU HAVE LATEST REVISION			

REFERENCE INFORMATION & FILE NO. OF SURVEYS	



SAN FRANCISCO MUNICIPAL TRANSPORTATION AGENCY
CITY AND COUNTY OF SAN FRANCISCO

DRAWN:	DATE:
JH	4/2018
CHECKED:	DATE:
GD	4/2018

SCALE:
AS SHOWN
SHEET OF SHEETS
01 OF 01

TRAFFIC SIGNAL INVENTORY DIAGRAM
POLK STREET AND POST STREET

CNN NO.
25200000
REV NO.
1