


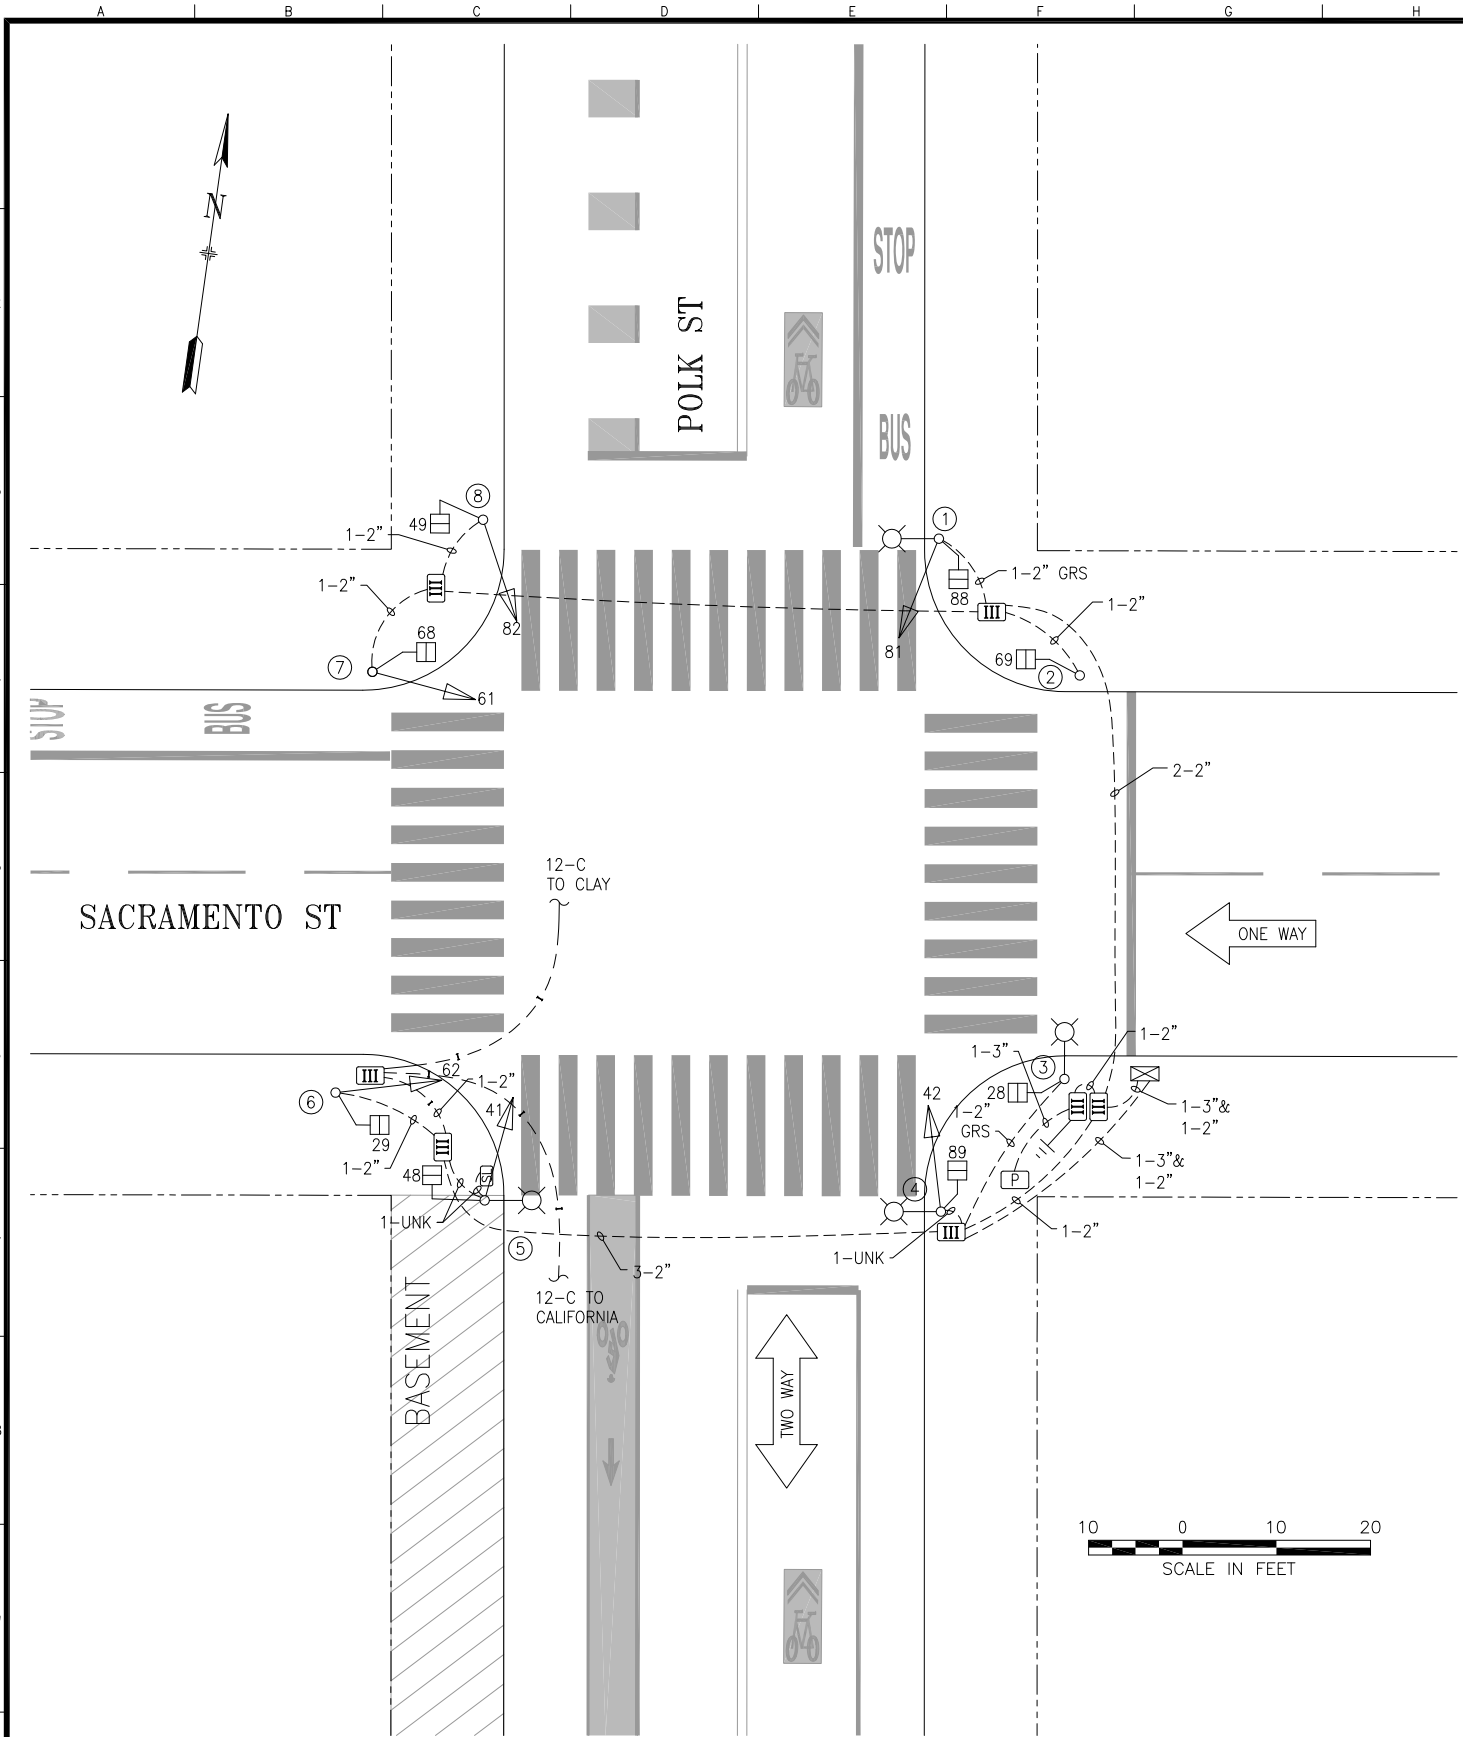

POLE AND EQUIPMENT SCHEDULE											
POLE No.	TYPE OF POLE	LUMINAIRE VOLTAGE/WATTAGE	VEHICLE SIGNAL					PEDESTRIAN SIGNAL			REMARKS
			No.	TYPE	MOUNTING	VISORS	LOUVERS	No.	TYPE	MOUNTING	
①	ORNAMENTAL STREET LIGHT		81	3S12"	SV-1 (16")	T		88	1S-COUNT	SP-1	
②	1-A (10')							69	1S-COUNT	SP-1	
③	CITY STANDARD STREET LIGHT							28	1S-COUNT	SP-1	
④	ORNAMENTAL STREET LIGHT		42	3S12"	SV-1-T	T		89	1S-COUNT	SP-1	
⑤	STREET LIGHT W/ ORNAMENTAL LUMINAIRE		41	3S12"	SV-1-T	T		48	1S-COUNT	SP-1	
⑥	1-A (10')		62	3S12"	TV-1-T	T		29	1S-COUNT	SP-1	
⑦	1-A (10')		61	3S12"	TV-1-T	T		68	1S-COUNT	SP-1	
⑧	1-A (10')		82	3S12"	TV-1-T	T		49	1S-COUNT	SP-1	

TABLE OF REVISIONS				
CHECK WITH TRACING TO SEE IF YOU HAVE LATEST REVISION				
1	6/4/19	2126J PUNCH LIST INSPECTION - POLE 1 REPLACED	JH	GD
0	7/26/17	FULL UPGRADE BY 2586J; CONVERTED FROM AS-BUILTS	JH	GD
NO.	DATE	DESCRIPTION	BY	APP.

REFERENCE INFORMATION & FILE NO. OF SURVEYS	



SAN FRANCISCO MUNICIPAL TRANSPORTATION AGENCY
CITY AND COUNTY OF SAN FRANCISCO

DRAWN:	DATE:
JH	4/2018
CHECKED:	DATE:
GD	4/2018

SCALE:
AS SHOWN
SHEET OF SHEETS
01 OF 01

TRAFFIC SIGNAL INVENTORY DIAGRAM
POLK STREET AND SACRAMENTO STREET

CNN NO.
25301000
REV NO.
1