



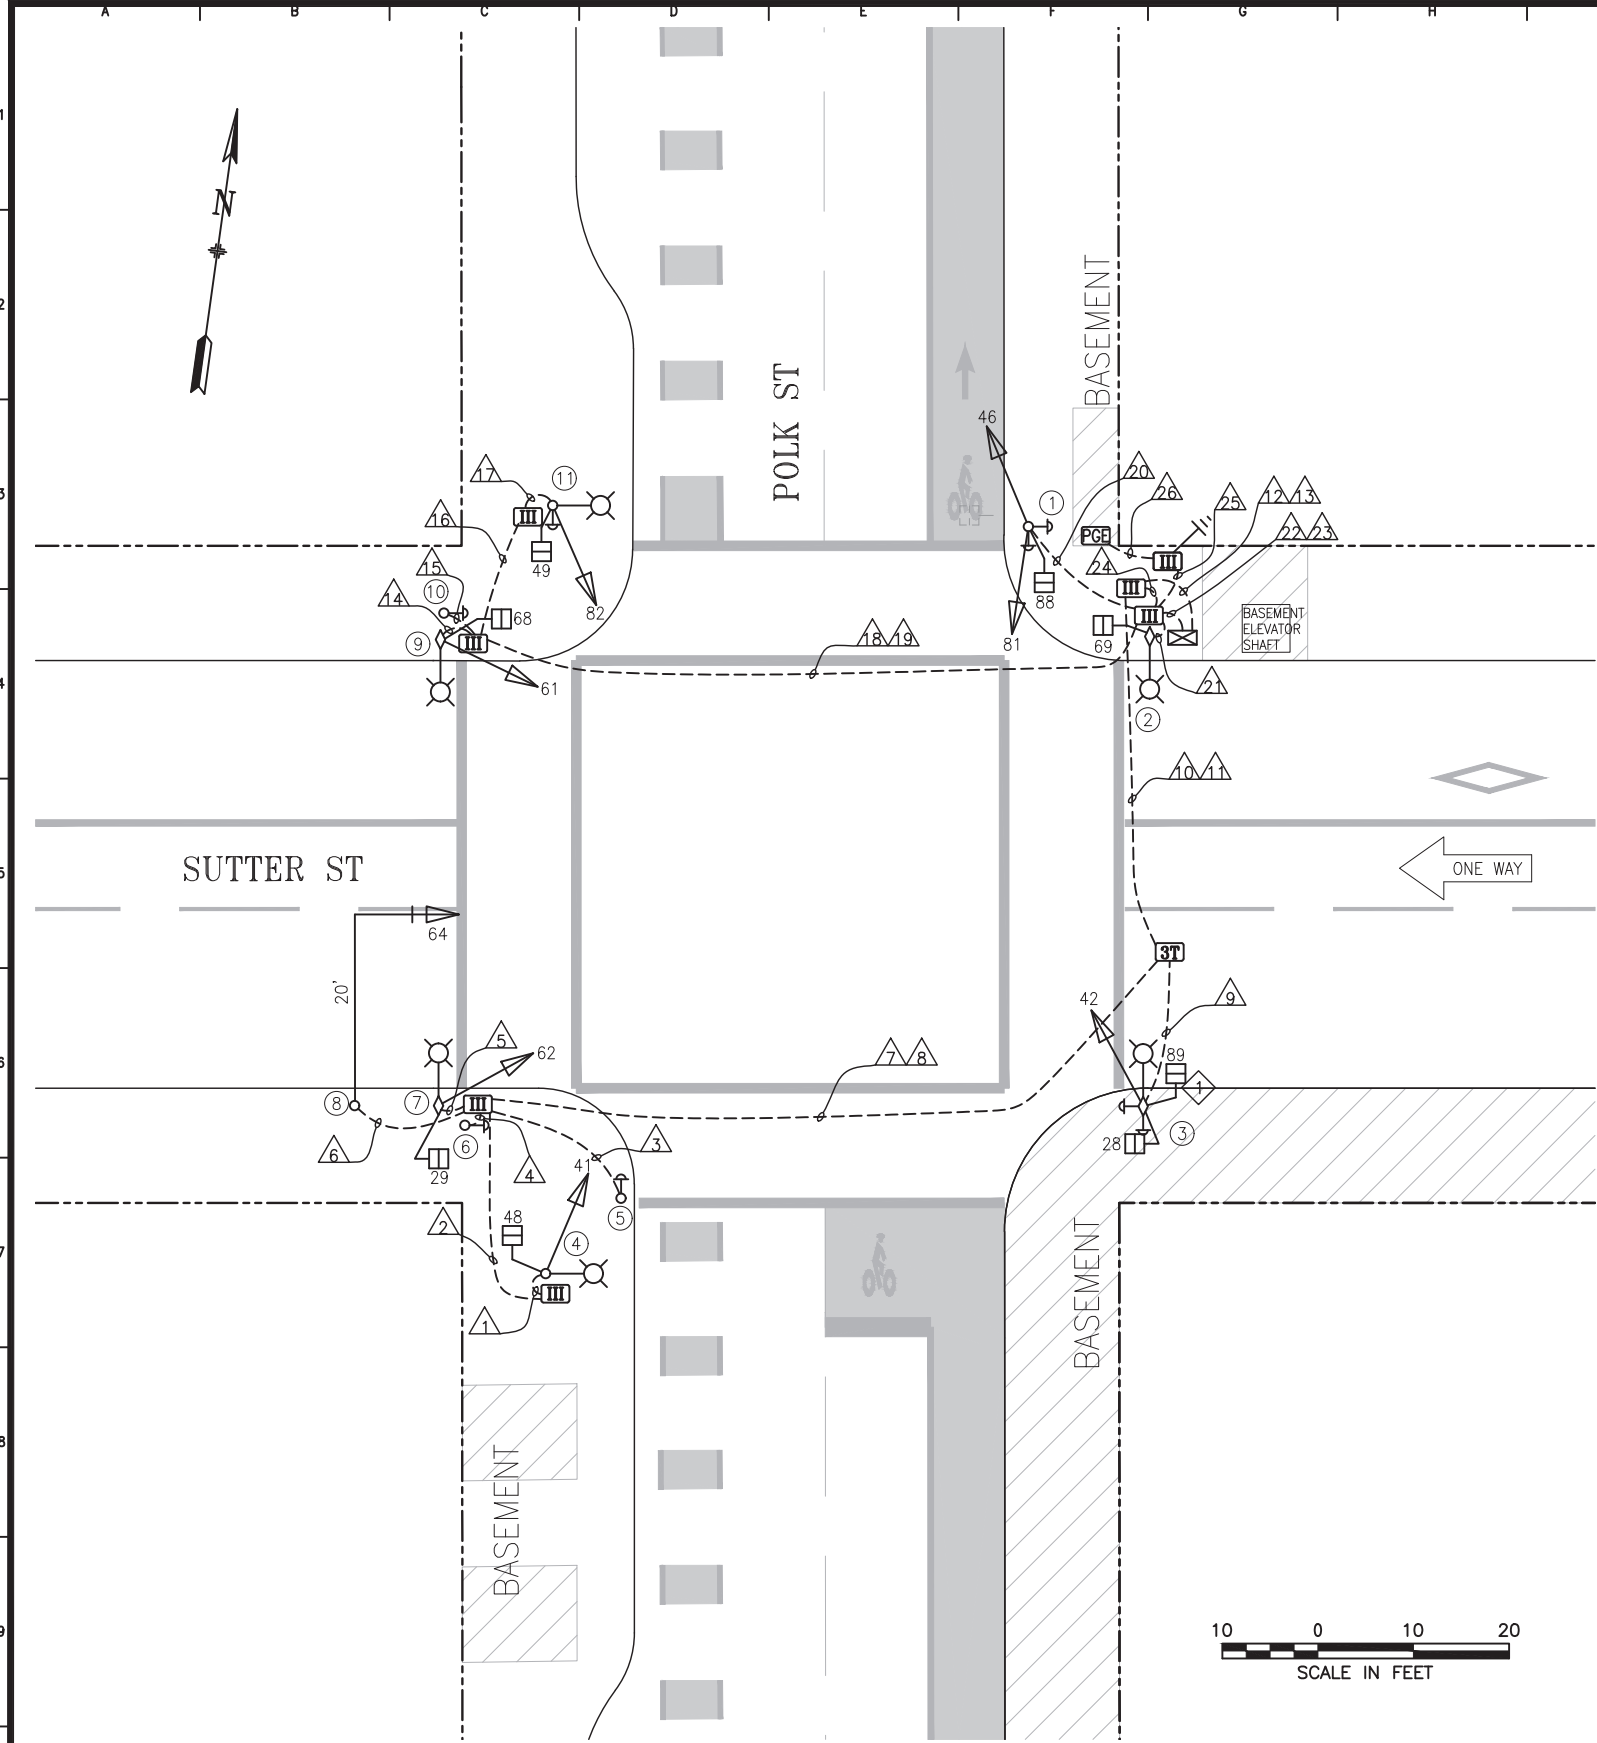

POLE AND EQUIPMENT SCHEDULE											
POLE No.	TYPE OF POLE	LUMINAIRE VOLTAGE/WATTAGE	VEHICLE SIGNAL					PEDESTRIAN SIGNAL			REMARKS
			No.	TYPE	MOUNTING	VISORS	LOUVERS	No.	TYPE	MOUNTING	
①	1-A (10')		46 81	3S12" 3S12"	SV-2-TA	T T		88	1S-COUNT	SP-1	APS-4W APS-4W
②	MUNI POLE W/ ORNAMENTAL SL							69	1S-COUNT	SP-1	
③	MUNI POLE W/ ORNAMENTAL SL		42	3S12"	SV-1-T	T		28 89	1S-COUNT 1S-COUNT	SP-2-T	APS-4W APS-4W
④	ORNAMENTAL STREET LIGHT		41	3S12"	SV-1-T	T		48	1S-COUNT	SP-1	
⑤	PPB POLE										APS-4W
⑥	PPB POLE										APS-4W
⑦	MUNI POLE W/ ORNAMENTAL SL		62	3S12"	SV-1-T	T		29	1S-COUNT	SP-1	
⑧	16-2-100 W/ 20' MAST ARM		64	3S12"	MAS	T					BACKPLATE
⑨	MUNI POLE W/ ORNAMENTAL SL		61	3S12"	SV-1-T	T		68	1S-COUNT	SP-1	
⑩	PPB POLE										APS-4W
⑪	ORNAMENTAL STREET LIGHT		82	3S12"	SV-1-T	T		49	1S-COUNT	SP-1	APS-4W

SHEET NOTES:

① EXTERNAL RISER INSTALLED ALONG FACE OF BASEMENT WALL AND 6-8" FROM EDGE OF POLE BASE PLATE. LB CONDULET AT POLE BASE. PACKED WITH GROUT. REFER TO DETAIL 1 BELOW.

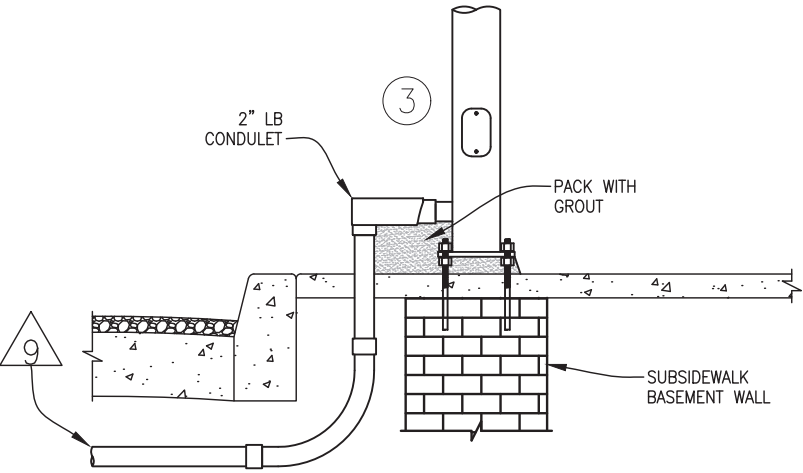

POLE 3 EXTERNAL CONDUIT DETAIL ①
NOT TO SCALE

NO.	DATE	DESCRIPTION	BY	APPROVED
0	7/18/18	UPGRADE BY 2126J; CONVERTED FROM AS-BUILTS	J.HORNOSTEL	G.DeLEON
TABLE OF REVISIONS CHECKOUT DRAWING THROUGH THE SID CUSTODIAN FOR THE LATEST REVISION				



SFMTA

DRAWN BY:	DATE:
J. HORNOSTEL	8/2021
CHECKED BY:	DATE:
G. DeLEON	8/2021

SCALE
AS SHOWN
SHEET OF SHEETS
01 OF 02

TRAFFIC SIGNAL INVENTORY DIAGRAM
POLK STREET AND SUTTER STREET

CNN NO:
25208000
REV NO:
0

