


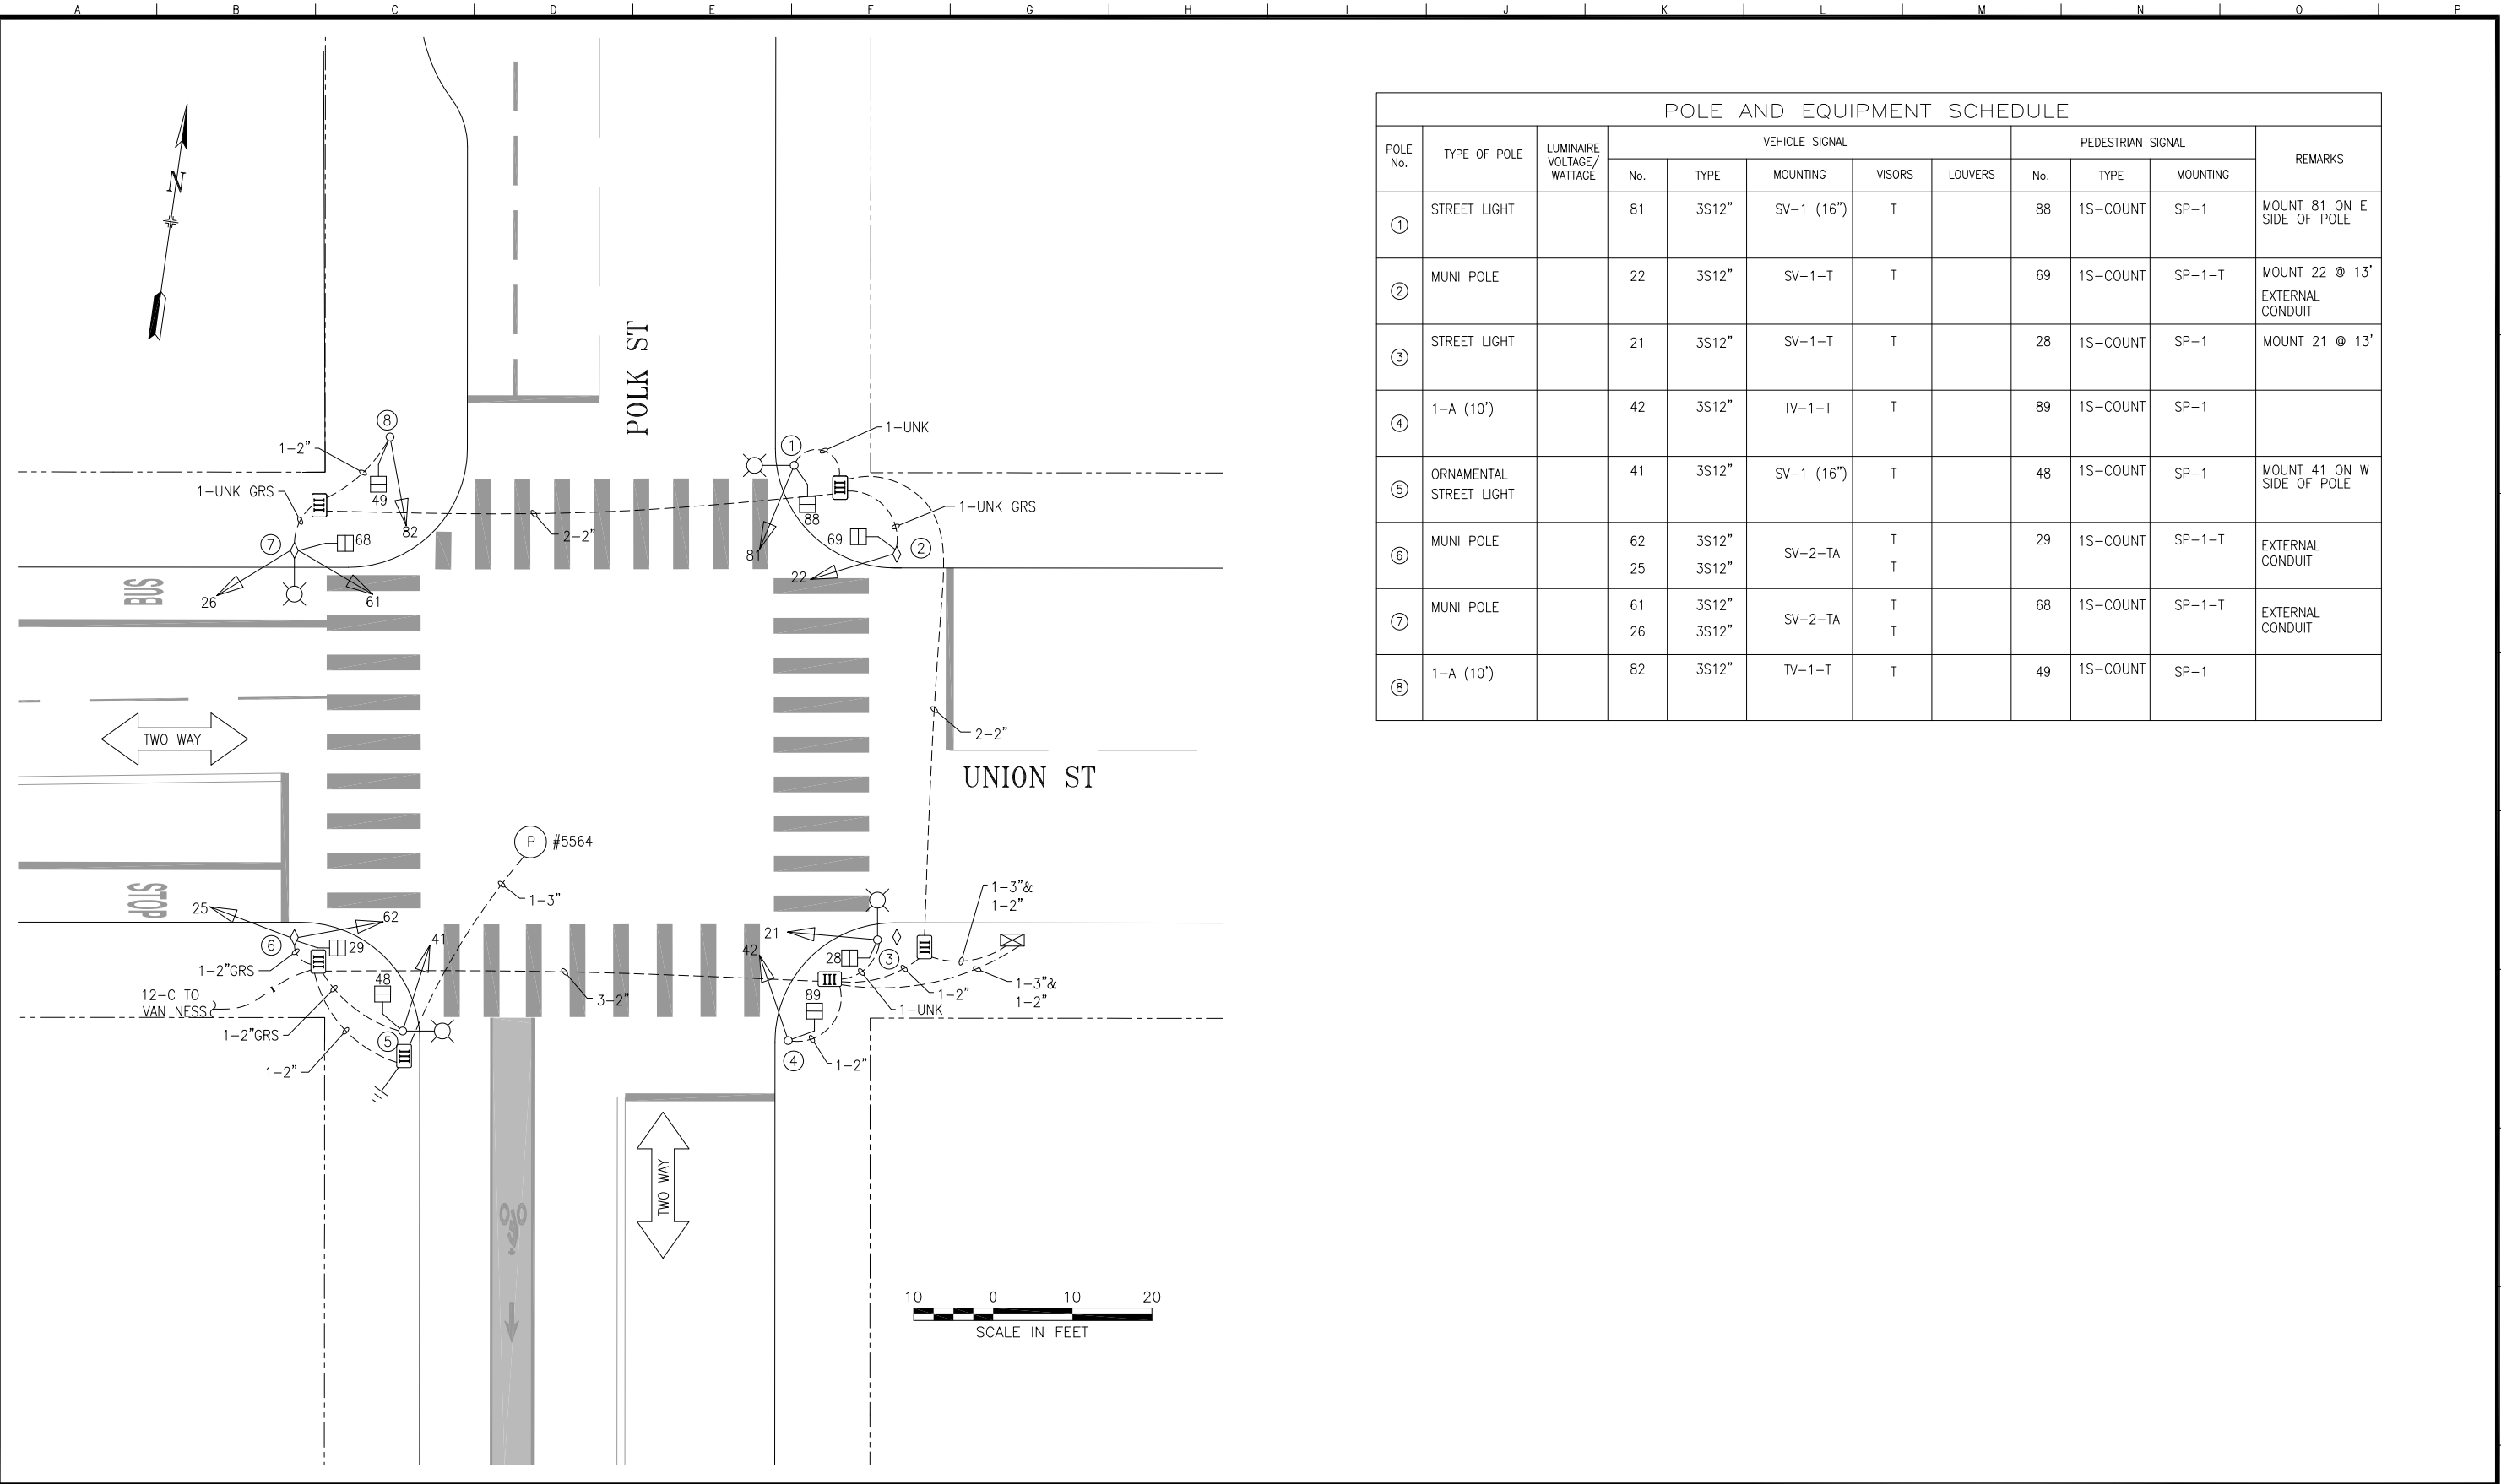

POLE AND EQUIPMENT SCHEDULE											
POLE No.	TYPE OF POLE	LUMINAIRE VOLTAGE/ WATTAGE	VEHICLE SIGNAL					PEDESTRIAN SIGNAL			REMARKS
			No.	TYPE	MOUNTING	VISORS	LOUVERS	No.	TYPE	MOUNTING	
①	STREET LIGHT		81	3S12"	SV-1 (16")	T		88	1S-COUNT	SP-1	MOUNT 81 ON E SIDE OF POLE
②	MUNI POLE		22	3S12"	SV-1-T	T		69	1S-COUNT	SP-1-T	MOUNT 22 @ 13' EXTERNAL CONDUIT
③	STREET LIGHT		21	3S12"	SV-1-T	T		28	1S-COUNT	SP-1	MOUNT 21 @ 13'
④	1-A (10')		42	3S12"	TV-1-T	T		89	1S-COUNT	SP-1	
⑤	ORNAMENTAL STREET LIGHT		41	3S12"	SV-1 (16")	T		48	1S-COUNT	SP-1	MOUNT 41 ON W SIDE OF POLE
⑥	MUNI POLE		62 25	3S12" 3S12"	SV-2-TA	T T		29	1S-COUNT	SP-1-T	EXTERNAL CONDUIT
⑦	MUNI POLE		61 26	3S12" 3S12"	SV-2-TA	T T		68	1S-COUNT	SP-1-T	EXTERNAL CONDUIT
⑧	1-A (10')		82	3S12"	TV-1-T	T		49	1S-COUNT	SP-1	

1	12/6/18	2126J PUNCH LIST INSPECTION-REPLACED POLE 5	JH	GD	
0	6/27/17	FULL UPGRADE BY 2586J; CONVERTED FROM AS-BUILTS	JH	GD	
NO.	DATE	DESCRIPTION	BY	APP.	

TABLE OF REVISIONS
CHECK WITH TRACING TO SEE IF YOU HAVE LATEST REVISION

REFERENCE INFORMATION
& FILE NO. OF SURVEYS

SAN FRANCISCO MUNICIPAL TRANSPORTATION AGENCY
CITY AND COUNTY OF SAN FRANCISCO

DRAWN:	DATE:
JH	4/2018
CHECKED:	DATE:
GD	4/2018

SCALE:
AS SHOWN
SHEET OF SHEETS
01 OF 01

TRAFFIC SIGNAL INVENTORY DIAGRAM
POLK STREET AND UNION STREET

CNN NO.
25563000
REV NO.

1