


PORTOLA, SANTA CLARA, & VICENTE

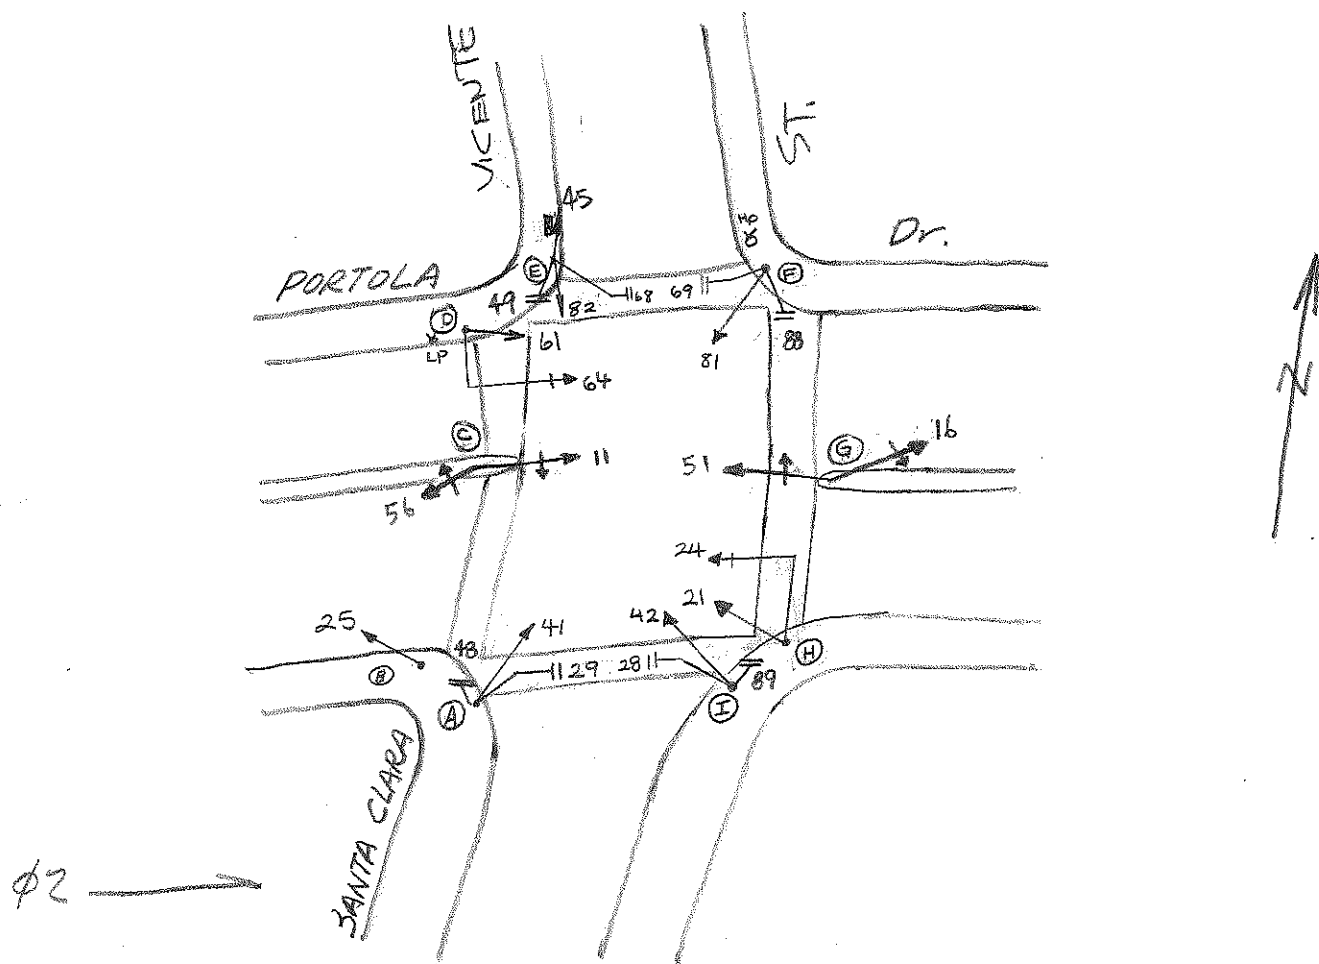

SRC COMPLETED ON 6/27/13

POLE	FUNC.	MAT'L	SIGNAL NO.	MAKE	NO. OF SECT.	SIZE	VISOR	B.P. OR LOUVERS	MOUN'T	PED SIGNAL NO.	LEGEND	MESSAGE		MAKE	MOUN'T
												ELEMENT	COLOR		
A	S	S	41	ICC	3	8"	FC 8"	NO	S	29	I	IS-COUNT	OR/WH	ICC	S
B	S	S	25	ICC	3	8"	FC 8"	NO	T	68	I	IS-COUNT	OR/WH	ICC	S
C	S	C	56	ICC	3	12" RYG	T 12"	NO	S	69	I	IS-COUNT	OR/WH	ICC	S
D	S	S	11	ICC	3	12" RYG	T 12"	BP	S	28	I	IS-COUNT	OR/WH	ICC	S
E	S	S	64	ICC	3	12"	T 12"	BP	A	48	I	IS-COUNT			S
F	S	S	61	ICC	3	8"	FC 12"	NO	S	49	I	IS-COUNT			S
G	S	C	82	ICC	3	8"	FC 8"	NO	T	88	I	IS-COUNT			S
H	S	S	45	ICC	3	8"	FC 8"	NO	T	89	I	IS-COUNT			S
I	S	S	81	ICC	3	8"	FC 8"	NO	T						
			51	ICC	3	12" RYG	T 12"	NO	S						
			16	ICC	3	12" RYG	T 12"	NO	S						
			24	ICC	3	12"	T 12"	BP	A						
			21	ICC	3	8"	FC 8"	NO	S						
			42	ICC	3	8"	FC 8"	NO	T						

CONTROLLER CABINET SIZE : ORDINARY BASE CABINET: YES

COMMENTS : SRC 2013-031 - ADD PED SIGNALS XING PORTOLA