


POLE AND EQUIPMENT SCHEDULE											
POLE No.	TYPE OF POLE	LUMINAIRE VOLTAGE/ WATTAGE	VEHICLE SIGNAL					PEDESTRIAN SIGNAL			REMARKS
			No.	TYPE	MOUNTING	VISORS	LOUVERS	No.	TYPE	MOUNTING	
①	1-A (13')		22 65	①	TOP-MOUNT						PEDESTRIAN PUSH BUTTON
②	CITY STANDARD STREETLIGHT		21 66	①	SIDE-MOUNT						PEDESTRIAN PUSH BUTTON
③	MUNI POLE		25 62	①	SIDE-MOUNT EXT. CONDUIT						PEDESTRIAN PUSH BUTTON
④	CITY STANDARD STREETLIGHT		26 61	②	SIDE-MOUNT						PEDESTRIAN PUSH BUTTON

SHEET NOTES:

- ① JSF TECHNOLOGIES AB-9407 AC POWER DUAL SIDED RECTANGULAR RAPID FLASH BEACON ASSEMBLY
- ② JSF TECHNOLOGIES AB-9207 HYBRID POWER DUAL SIDED RECTANGULAR RAPID FLASH BEACON ASSEMBLY

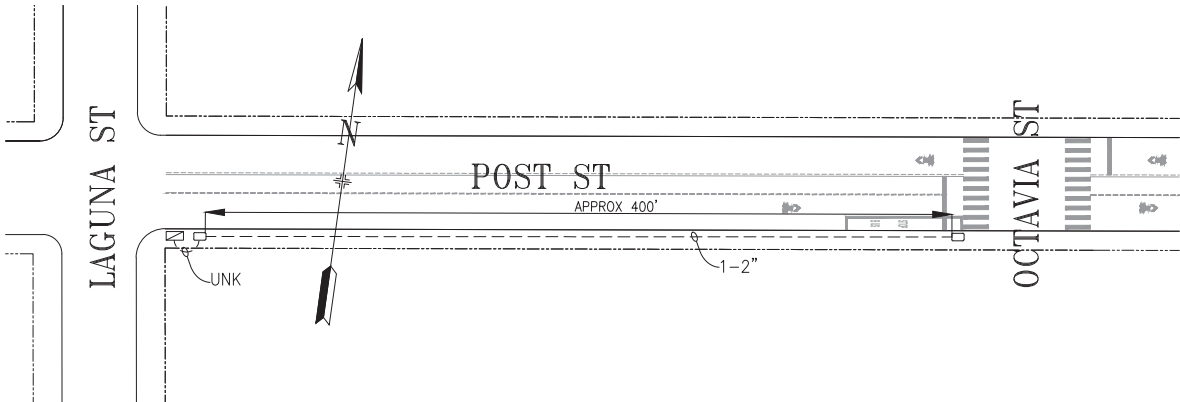

ELECTRICAL SERVICE PLAN DETAIL ①
NOT TO SCALE

				REFERENCE INFORMATION & FILE NO. OF SURVEYS			SAN FRANCISCO MUNICIPAL TRANSPORTATION AGENCY		DRAWN: DATE: JH 08/15		SCALE:	TRAFFIC SIGNAL INVENTORY DIAGRAM		CNN NO. 10643000			
TABLE OF REVISIONS				CHECK WITH TRACING TO SEE IF YOU HAVE LATEST REVISION			CITY AND COUNTY OF SAN FRANCISCO					POST STREET MIDBLOCK BETWEEN GOUGH STREET AND LAGUNA STREET		REV NO. 2			
2	9/9/21	ADD BEACONS 21 PER SRC 2021-234		JH	GD				CHECKED: DATE: MV 08/15	SHEET OF SHEETS 1 OF 1							
1	10/28/20	ADD BEACONS 26, 61, 62 PER SRC 2020-176		JH	GD												
0	11/21/14	ACTIVATED THRU 2246J; CONVERTED FROM CONTRACT PLANS		JH	MV												
NO.	DATE	DESCRIPTION		BY	APP.												