


AS-BUILT

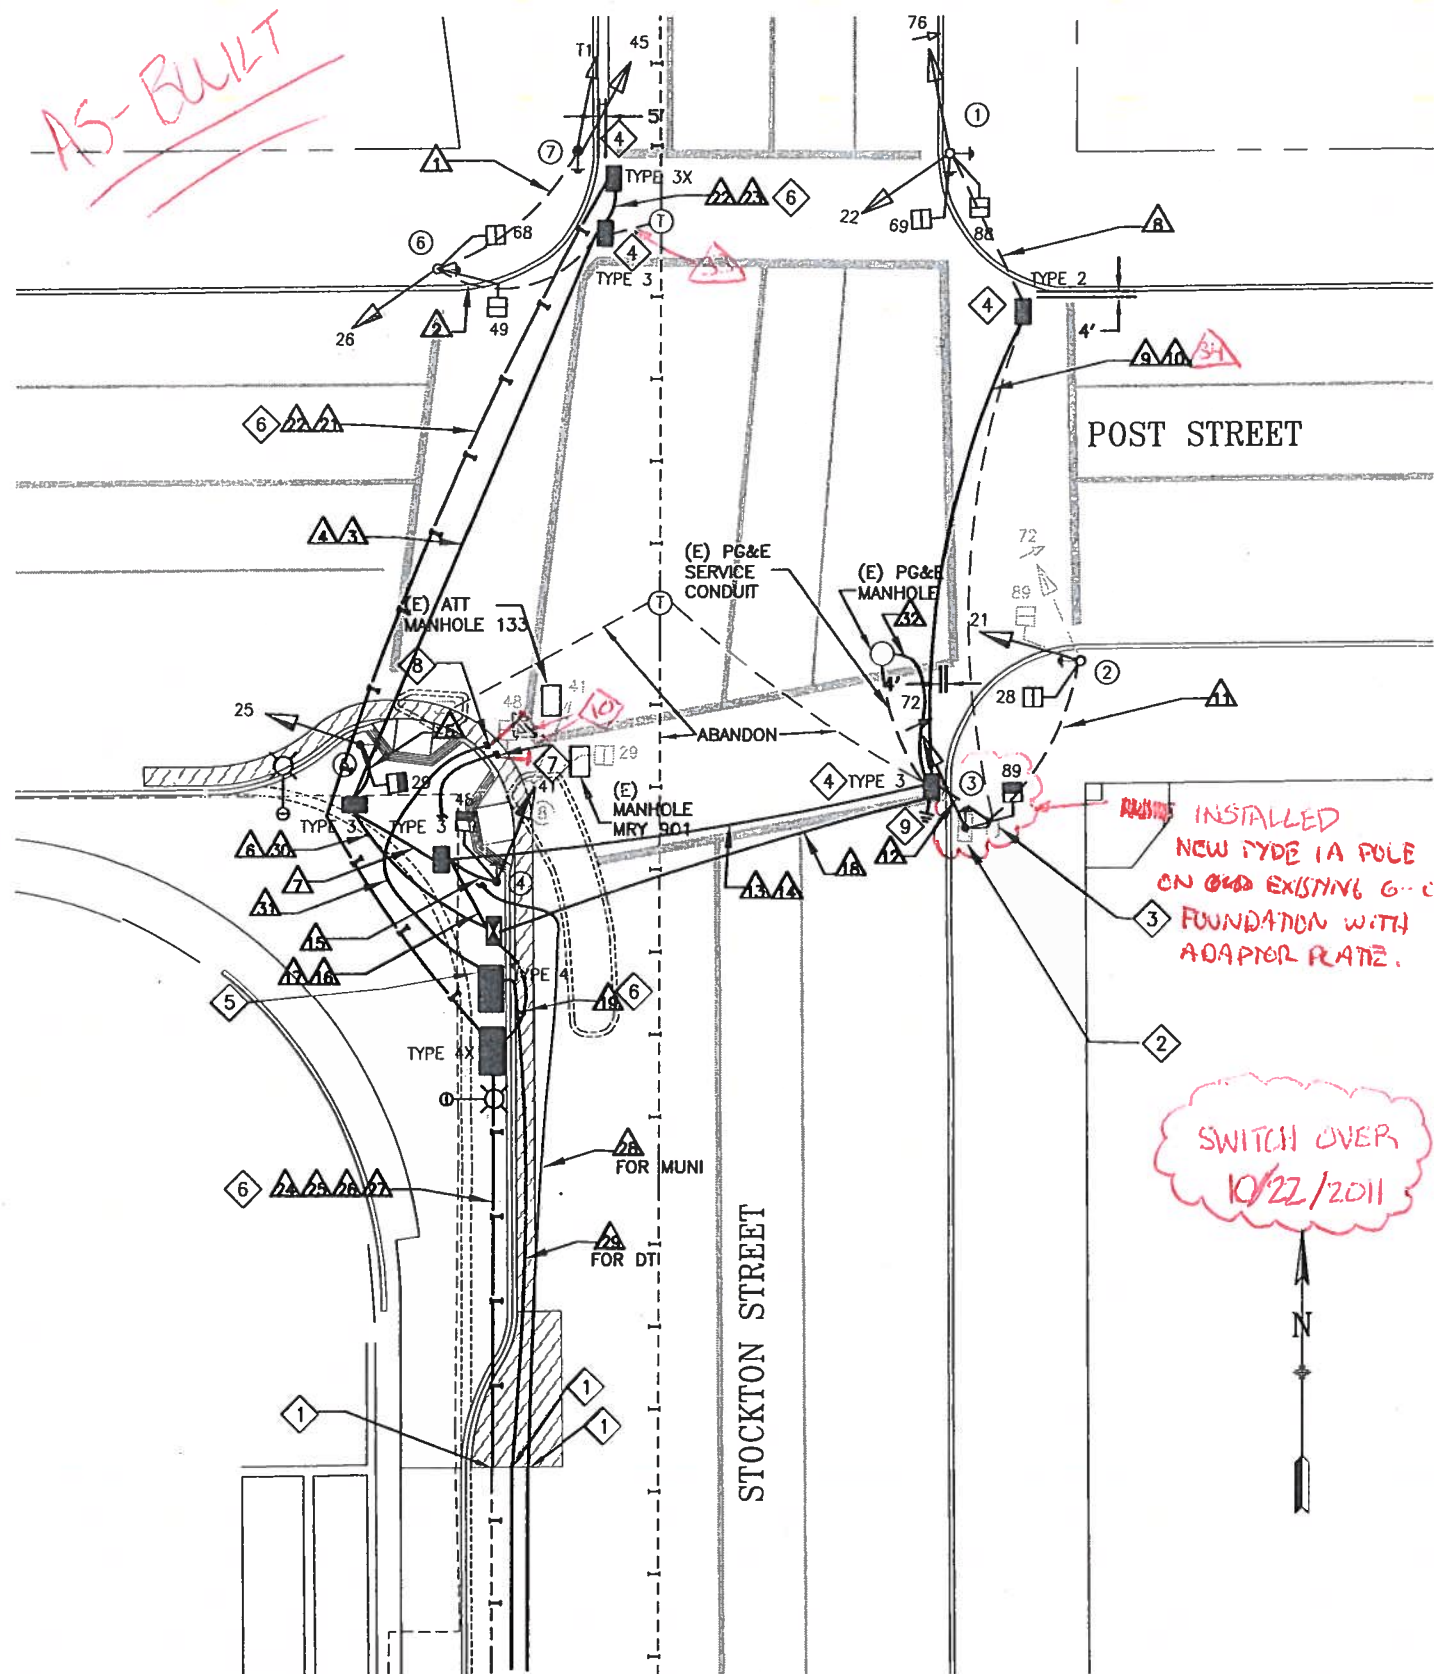

POLE AND EQUIPMENT SCHEDULE								CONTRACT WORK IN BOLD			
POLE No.	TYPE OF POLE	LUMINAIRE VOLTAGE/ WATTAGE	VEHICLE SIGNAL					PEDESTRIAN SIGNAL			REMARKS
			No.	TYPE	MOUNTING	VISORS	LOUVERS	No.	TYPE	MOUNTING	
①	1-A (10')		76 22	4S12" LA 3S12"	TV-2	T		88 69	1S-COUNT 1S-COUNT	SP-2	APS (2)
②	EX. ORNAMENTAL STREET LIGHT		21	3S12"	SV-1	T		28	1S-COUNT	SP-1	APS
③	1-A (10')		72	3S12" LA	TV-1	T		89	1S-COUNT	SP-1	APS
④	1-A (10')		41	3S12"	TV-1	T		48	1S-COUNT	SP-1	APS
⑤	1-A (10')		25	3S12"	TV-1	T		29	1S-COUNT	SP-1	APS
⑥	EX. ORNAMENTAL STREET LIGHT		26	3S12"	SV-1 TV-1	T		68 49	1S-COUNT 1S-COUNT	SP-2	APS
⑦	EX. MUNI POLE		45 T1	3S12" 2S8-X"	SV-1 SV-1	T					APS
⑧	EX. 1-A (10')										


SHEET NOTES:

- 1 JOIN INTERCONNECT WITH CENTRAL SUBWAY PROJECT AT SOUTHERN MOST END OF PROJECT LIMIT (APPROX. 70' FROM NORTHERN FACE OF CURB).
- 2 F/I ADAPTOR PLATE ON (E) G FOUNDATION. INSTALL TYPE 1A POLE ON ADAPTOR PLATE PER SFMTA DETAIL. MODIFY BASEMENT FOUNDATION PER STRUCTURAL DETAIL.
- 3 R/C (E) BASEMENT PULLBOX. F/I CONDUIT COUPLINGS TO CONNECT (E) CONDUITS.
- 4 F/I TRAFFIC RATED PULLBOX AND COVER.
- 5 F/I TYPE 4 PULLBOX FOR DT.
- 6 F/I TYPE HDPE CONDUIT.
- 7 CAP CONDUIT AT PROJECT LIMIT FOR FUTURE CONNECTION TO (E) MRY MANHOLE 901.
- 8 CAP CONDUIT AT PROJECT LIMIT FOR FUTURE CONNECTION TO (E) ATT MANHOLE 133.
- 9 F/I FUSES AND FUSE HOLDER PER SFPWSP 2007 FILE NO. 87203. PROVIDE CABLE TAG TO IDENTIFY THE SERVICE CONNECTION FROM PG&E.
- 10 THE DT CONDUIT AND THE MRY CONDUIT WERE LEFT 9 FT AND 6 FT FROM THE CATCH BASIN ON THE SW CORNER TOWARD THEIR RESPECTIVE MANHOLES.

FOR REFERENCE ONLY

NO.	DATE	DESCRIPTION	BY	APP.
TABLE OF REVISIONS				
THIS DRAWING WAS LAST MODIFIED: 10/11/11 11:42, BY: dwong				

REFERENCE INFORMATION
& FILE NO. OF SURVEYS

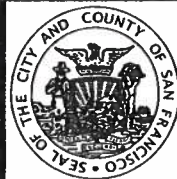

Infrastructure Division
DEPARTMENT OF PUBLIC WORKS
CITY AND COUNTY OF SAN FRANCISCO



DESIGNED: DATE: DW 5/27/11	APPROVED	SCALE: 1 : 10
DRAWN: DATE: CC 6/21/11	SECTION MANAGER DATE:	SHEET OF SHEETS 1 OF 1
CHECKED: DATE: 6/21/11	DEPUTY DIVISION MANAGER DATE:	
	DIVISION MANAGER DATE:	

CONTRACT NO. 1759J
DRAWING NO. E-2.0
FILE NO. XXXXX
REV. NO. XX

UNION SQUARE ACCESSIBILITY PROJECT
TRAFFIC SIGNAL MODIFICATION POST ST AND STOCKTON ST

FILE NAME: V:\1759J_Union_Square_Proj\Substation_Upgrade\2_Design\Working_Drawings\EEL\BOES_TBL_EEL.dwg
PLT TIME: 7/17/11 11:45am
Measurement Units are English - Feet
Scale: 1" = 10'-0"

CONDUIT AND WIRING SCHEDULE (FURNISH AND INSTALL CONDUIT AND WIRES)

[illegible][illegible]

REFERENCE INFORMATION
& FILE NO. OF SURVEYS



Infrastructure Division
DEPARTMENT OF PUBLIC WORKS
CITY AND COUNTY OF SAN FRANCISCO



DESIGNED:	DATE:
DW	5/27/11
DRAWN:	DATE:
CC	6/21/11
CHECKED:	DATE:
	6/21/11

APPROVED

 DIVISION MANAGER DATE: _____

 DIVISION MANAGER DATE: _____

 DIVISION MANAGER DATE: _____

SCALE:
1 : 10
SHEET OF SHEETS
1 OF 1

UNION SQUARE ACCESSIBILITY PROJECT

CONDUIT & WIRING SCHEDULE POST ST AND STOCKTON ST

CONTRACT NO.	1759J
DRAWING NO.	E-2.1
FILE NO.	XXXXX
REV. NO.	XX

[illegible]