


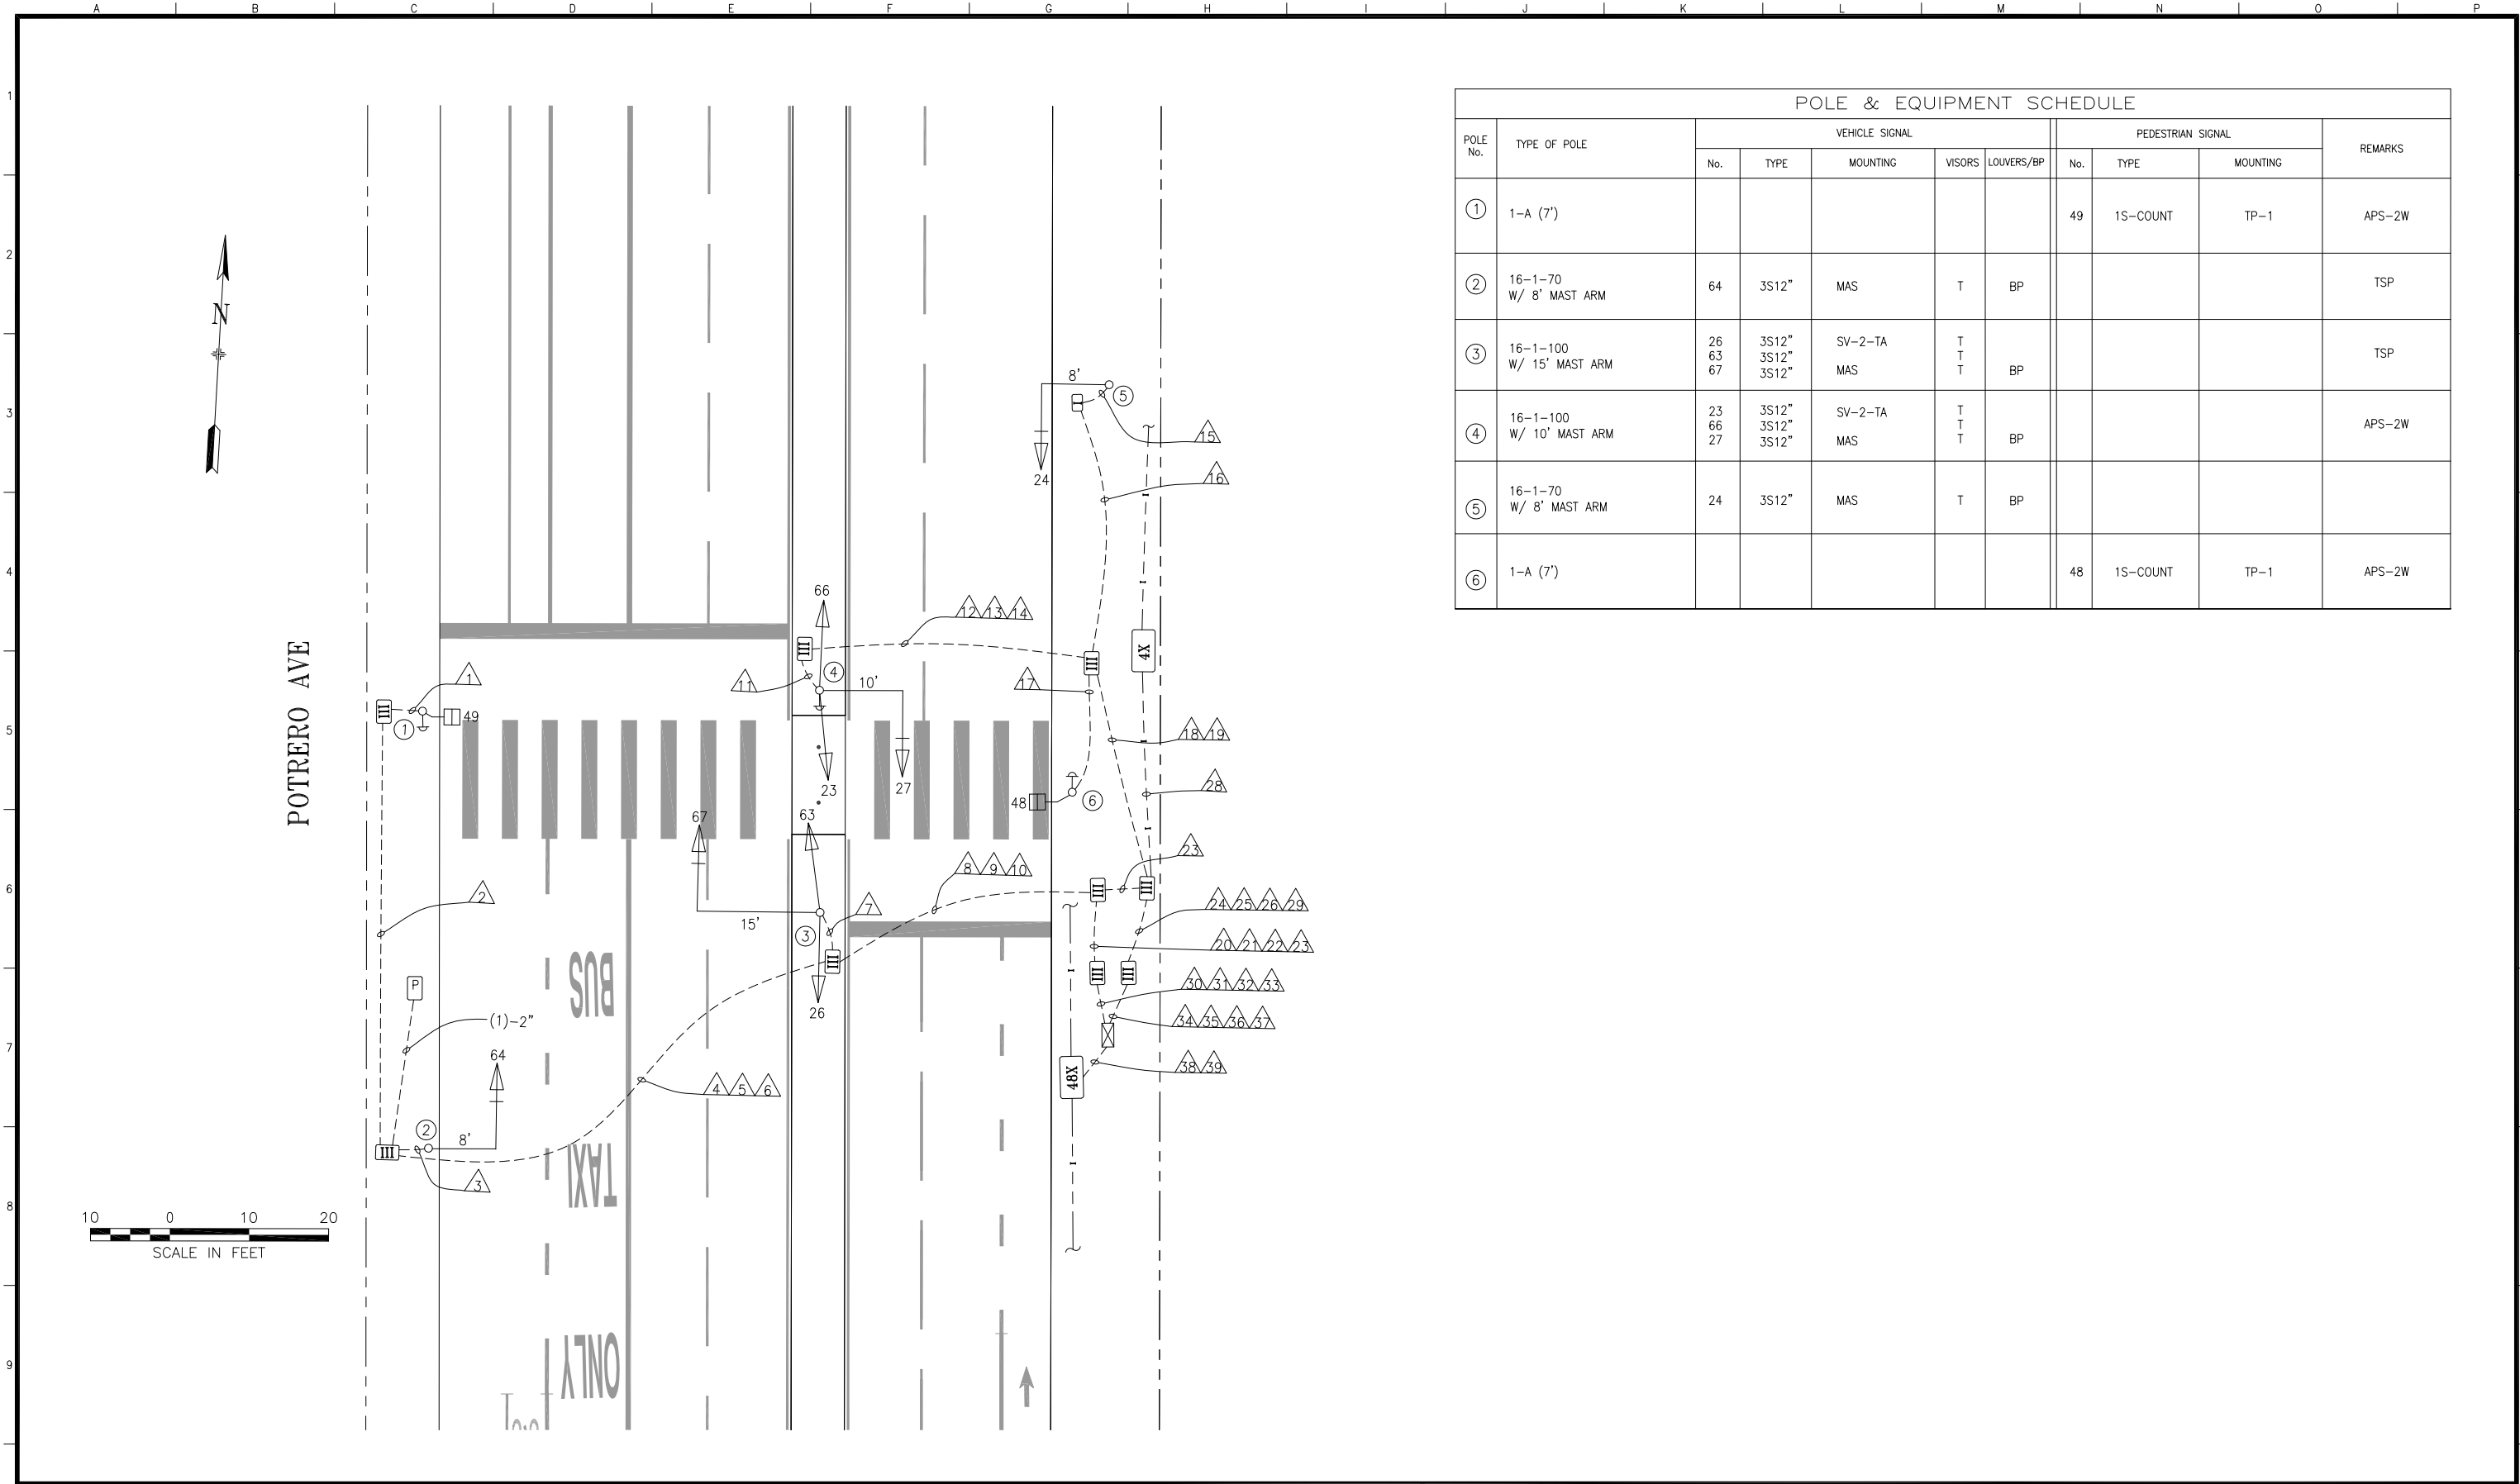

POLE & EQUIPMENT SCHEDULE										
POLE No.	TYPE OF POLE	VEHICLE SIGNAL					PEDESTRIAN SIGNAL			REMARKS
		No.	TYPE	MOUNTING	VISORS	LOUVERS/BP	No.	TYPE	MOUNTING	
①	1-A (7")						49	1S-COUNT	TP-1	APS-2W
②	16-1-70 W/ 8' MAST ARM	64	3S12"	MAS	T	BP				TSP
③	16-1-100 W/ 15' MAST ARM	26 63 67	3S12" 3S12" 3S12"	SV-2-TA MAS	T T T	BP				TSP
④	16-1-100 W/ 10' MAST ARM	23 66 27	3S12" 3S12" 3S12"	SV-2-TA MAS	T T T	BP				APS-2W
⑤	16-1-70 W/ 8' MAST ARM	24	3S12"	MAS	T	BP				
⑥	1-A (7")						48	1S-COUNT	TP-1	APS-2W

0	09/14/17	UPGRADED BY 2127J; CONVERTED FROM AS-BUILTS	Hfu	Lventura	
NO.	DATE	DESCRIPTION	BY	APP.	
TABLE OF REVISIONS					
CHECK WITH TRACING TO SEE IF YOU HAVE LATEST REVISION					

REFERENCE INFORMATION & FILE NO. OF SURVEYS



SAN FRANCISCO MUNICIPAL TRANSPORTATION AGENCY

CITY AND COUNTY OF SAN FRANCISCO

DRAWN:	DATE:
H.YU	07/2019
CHECKED:	DATE:
L.VENTURA	09/2020

SCALE:
AS SHOWN
SHEET OF SHEETS
1 OF 2

TRAFFIC SIGNAL INVENTORY DIAGRAM
POTRERO AVENUE MIDBLOCK BETWEEN 22ND AND 23RD STREETS

CNN NO.
10669201
REV NO.
0

