



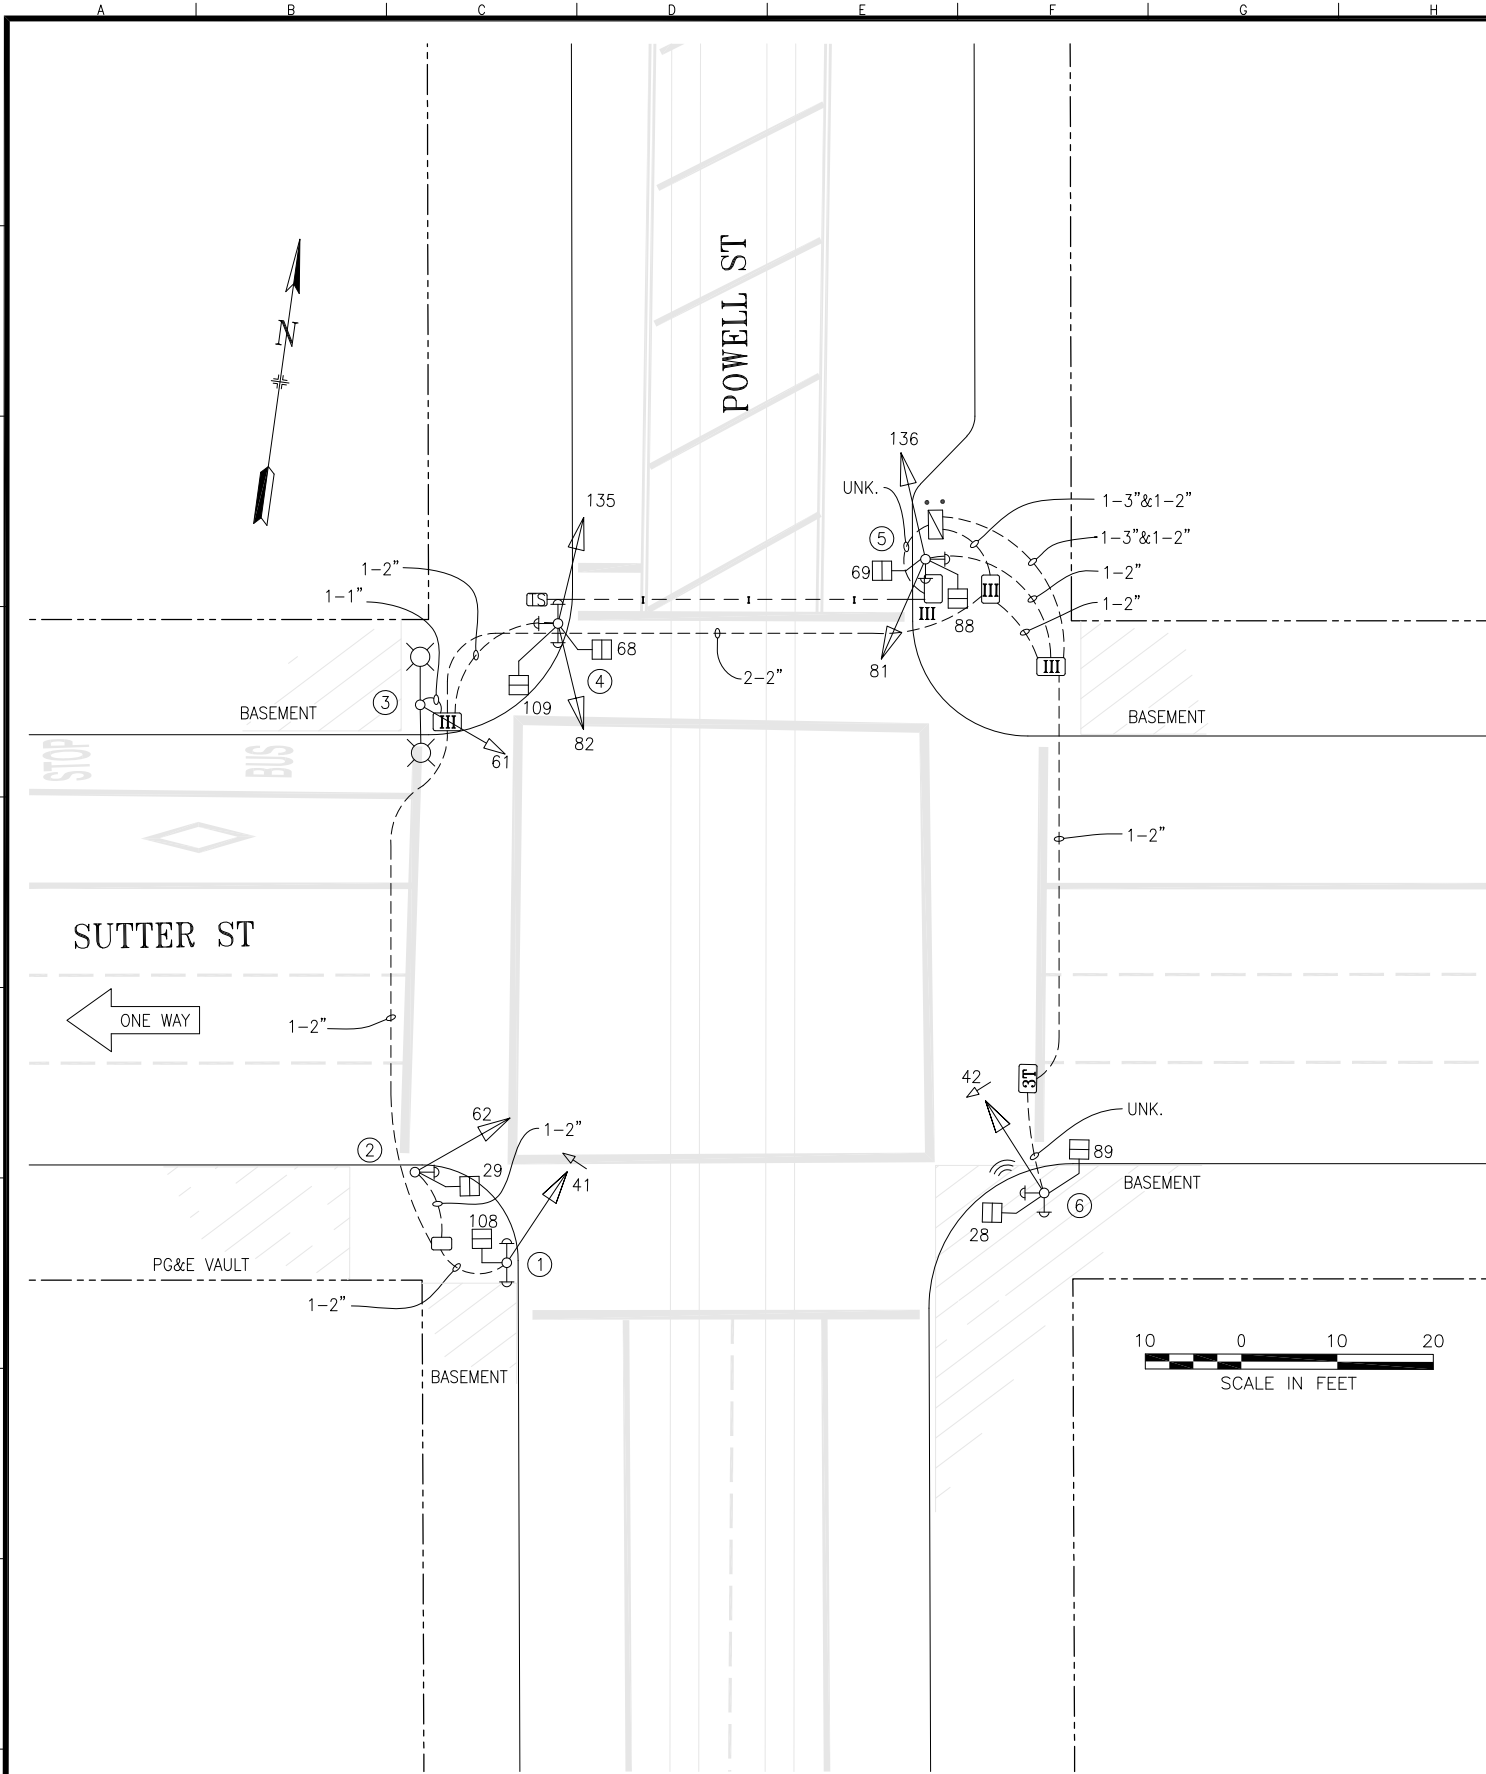

POLE AND EQUIPMENT SCHEDULE											
POLE No.	TYPE OF POLE	LUMINAIRE VOLTAGE/ WATTAGE	VEHICLE SIGNAL					PEDESTRIAN SIGNAL			REMARKS
			No.	TYPE	MOUNTING	VISORS	LOUVERS	No.	TYPE	MOUNTING	
①	1-A (15')		41	4S12"GRA	SV-1-T	T		108	1S-COUNT	SP-1	APS-3W x 2
②	1-A (10')		62	3S12"	TV-1-T	T		29	1S-COUNT	SP-1	APS-3W
③	ORNAMENTAL SL		61	3S8"	SV-1-T SEE DETAIL	T					
④	1-A (15')		135 82	2S12"LB 3S12"GVA	SV-2-TA	T T		109 68	1S-COUNT 1S-COUNT	SP-1 (22') SP-1-SF (12')	APS-3W x 3
⑤	1-A (15')		136 81	2S12"LB 3S12"GVA	SV-2-TA	T T		88 69	1S-COUNT 1S-COUNT	SP-1 SP-1	APS-3W x 2
⑥	10' POLE WITH PEDESTAL BASE		42	4S12"GRA	TV-1-T	T		28 89	1S-COUNT 1S-COUNT	SP-1 SP-1	TSP EQUIPMENT APS-3W x 2

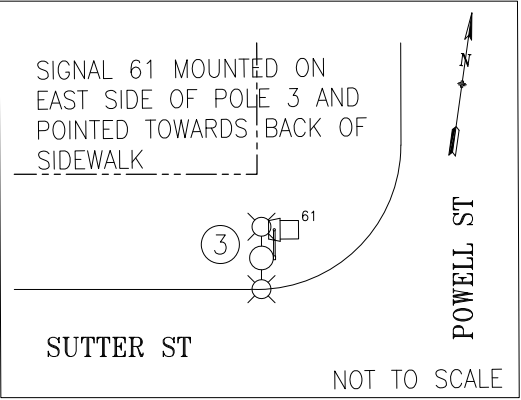

NO.	DATE	DESCRIPTION	BY	APPROVED
1	10/28/21	INSTALL APS (2021-053)	ELuu	GdeLeon
2	07/02/19	PER FIELD: ADD SIGNALS 135 & 136, REMOVE SIGNAL 45	ELuu	GdeLeon
3	09/22/14	UPGRADE ACTIVATED THRU 2108J; CONVERTED FROM CONTRACT PLANS	JHornbostel	MVelasco
4				

TABLE OF REVISIONS
CHECKOUT DRAWING THROUGH THE SID CUSTODIAN FOR THE LATEST REVISION



SFMTA

DRAWN BY: JH	DATE: 09/2015	SCALE: AS SHOWN	TRAFFIC SIGNAL INVENTORY DIAGRAM	CNN NO: 24909000
CHECKED BY: MV	DATE: 09/2015	SHEET OF SHEETS: 1 OF 1		POWELL STREET AND SUTTER STREET