


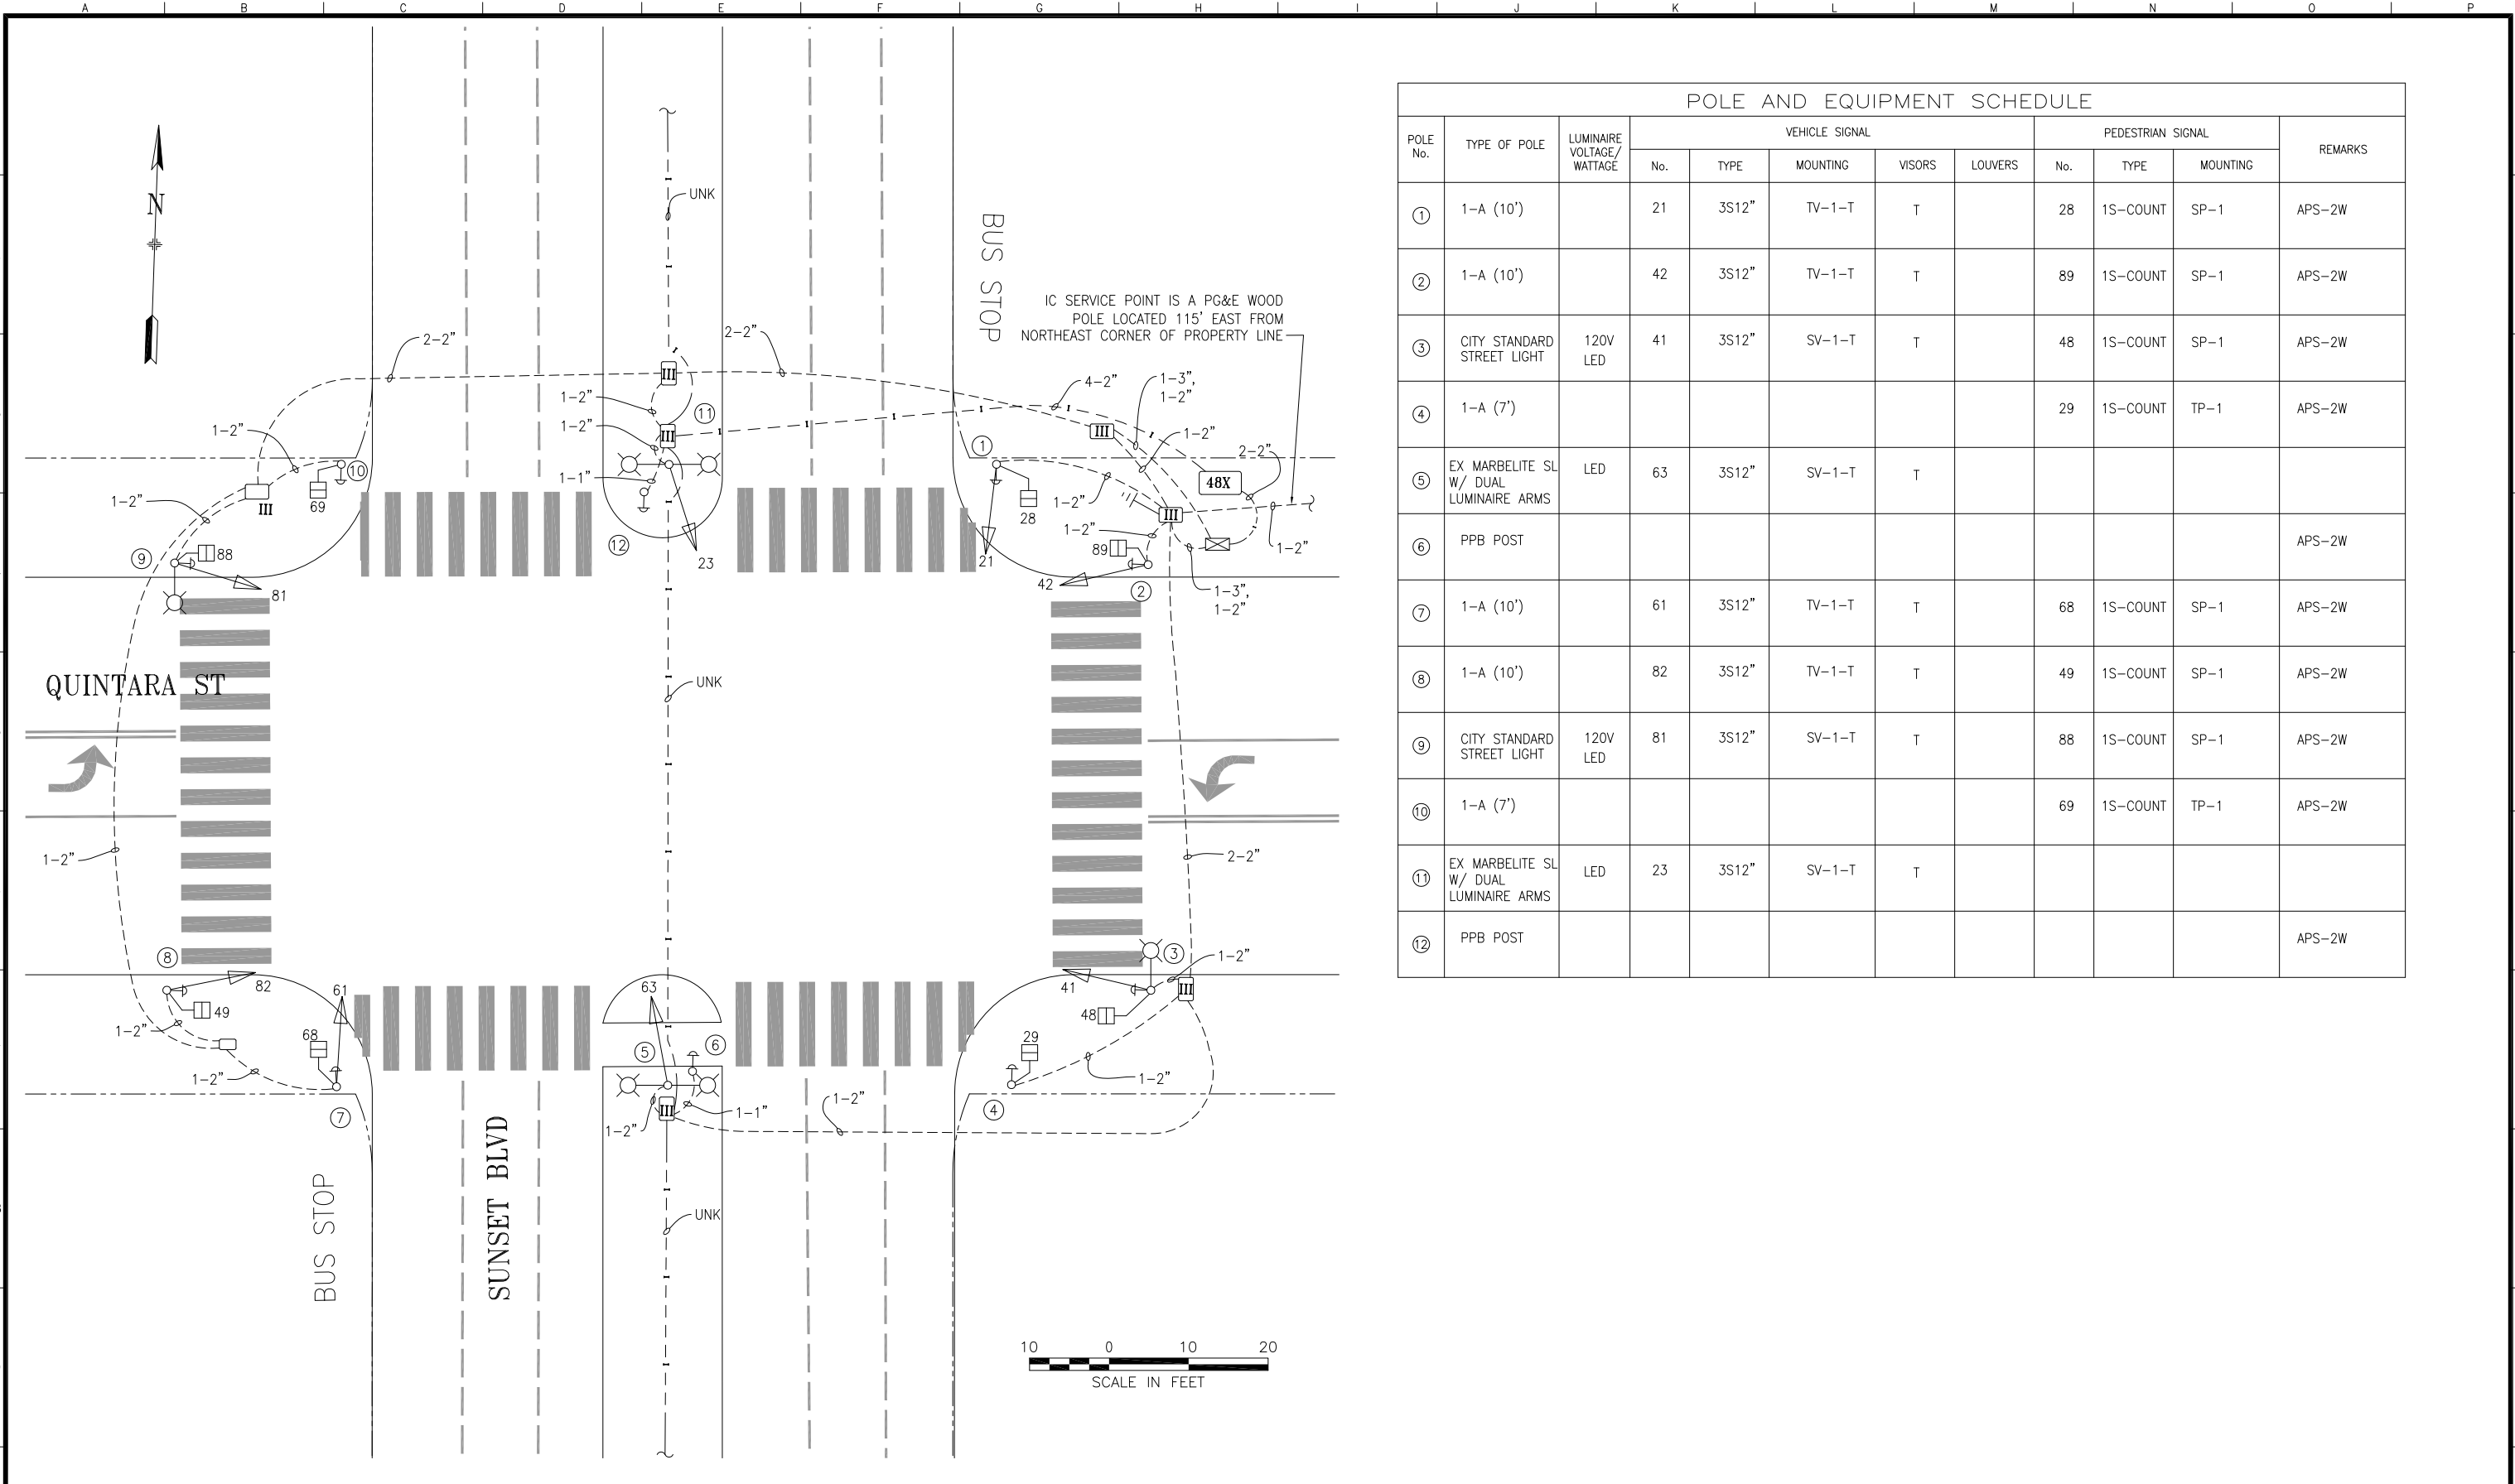

POLE AND EQUIPMENT SCHEDULE											
POLE No.	TYPE OF POLE	LUMINAIRE VOLTAGE/ WATTAGE	VEHICLE SIGNAL					PEDESTRIAN SIGNAL			REMARKS
			No.	TYPE	MOUNTING	VISORS	LOUVERS	No.	TYPE	MOUNTING	
①	1-A (10')		21	3S12"	TV-1-T	T		28	1S-COUNT	SP-1	APS-2W
②	1-A (10')		42	3S12"	TV-1-T	T		89	1S-COUNT	SP-1	APS-2W
③	CITY STANDARD STREET LIGHT	120V LED	41	3S12"	SV-1-T	T		48	1S-COUNT	SP-1	APS-2W
④	1-A (7')							29	1S-COUNT	TP-1	APS-2W
⑤	EX MARBELITE SL W/ DUAL LUMINAIRE ARMS	LED	63	3S12"	SV-1-T	T					
⑥	PPB POST										APS-2W
⑦	1-A (10')		61	3S12"	TV-1-T	T		68	1S-COUNT	SP-1	APS-2W
⑧	1-A (10')		82	3S12"	TV-1-T	T		49	1S-COUNT	SP-1	APS-2W
⑨	CITY STANDARD STREET LIGHT	120V LED	81	3S12"	SV-1-T	T		88	1S-COUNT	SP-1	APS-2W
⑩	1-A (7')							69	1S-COUNT	TP-1	APS-2W
⑪	EX MARBELITE SL W/ DUAL LUMINAIRE ARMS	LED	23	3S12"	SV-1-T	T					
⑫	PPB POST										APS-2W

1	7/19/17	NEW POLES 6 & 12 VIA 2821J; APS VIA SRC 2017-113	D'Yeung	GDeLeon
0	01/26/12	NEW SIGNAL ACTIVATED THROUGH CT 60	GH	GD
NO.	DATE	DESCRIPTION	BY	APP.

TABLE OF REVISIONS
CHECK WITH TRACING TO SEE IF YOU HAVE LATEST REVISION

REFERENCE INFORMATION
& FILE NO. OF SURVEYS



SAN FRANCISCO MUNICIPAL TRANSPORTATION AGENCY
CITY AND COUNTY OF SAN FRANCISCO

DRAWN:	DATE:
GD	12/2013
CHECKED:	DATE:
MV	12/2013

SCALE:
AS SHOWN
SHEET OF SHEETS
1 OF 1

TRAFFIC SIGNAL INVENTORY DIAGRAM
QUINTARA ST AND SUNSET BLVD

CNN NO.
23418000
REV NO.

1