


SACRAMENTO & SANSOME

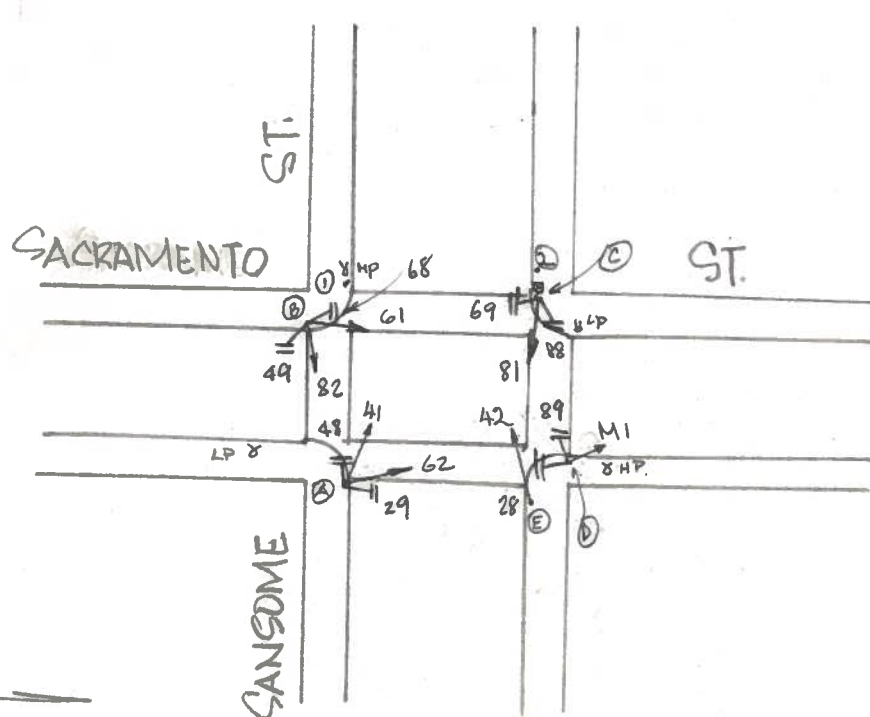

AS OF 10/22/2019

POLE	FUNC.	MAT'L	SIGNAL NO.	MAKE	NO. OF SECT.	SIZE	VISOR	B.P. OR LOUVERS	MOUNT	PED SIGNAL NO.	LEGEND	MESSAGE		MAKE	MOUNT
												ELEMENT	COLOR		
A	L	S	62	TCT	3	12"	T 12"	No	S	29	I	IS-I	W/OR	ICC	S
B	L	S	82	EL	3	12"	T 12"	No	S	48	I	IS-I	W/OR	ICC	S
C	S	S	61	EL	3	12"	T 12"	No	S	49	I	IS-I	W/OR	ICC	S
D	L	S	81	EL	3	12"	T 12"	No	S	68	I	IS-I	W/OR	ICC	S
E	S	S	41	TCT	3	12"	T 12"	No	S	69	I	IS-I	W/OR	ICC	S
			42	CH	3	12"	T 12"	No	T	88	I	IS-I	W/OR	ICC	S
1	M	S	M1	GA	2	8" Gx	C 8"	No	S	89	I	IS-I	W/OR	ICC	S
2	L	S								28	I	IS-I	W/OR	ICC	S

CONTROLLER CABINET SIZE : ORDINARY BASE CABINET: YES

COMMENTS : Per SRC 2018-417, upgraded signals 62, 82, 61, 81, 41, 42 TO 12". A.Kim