


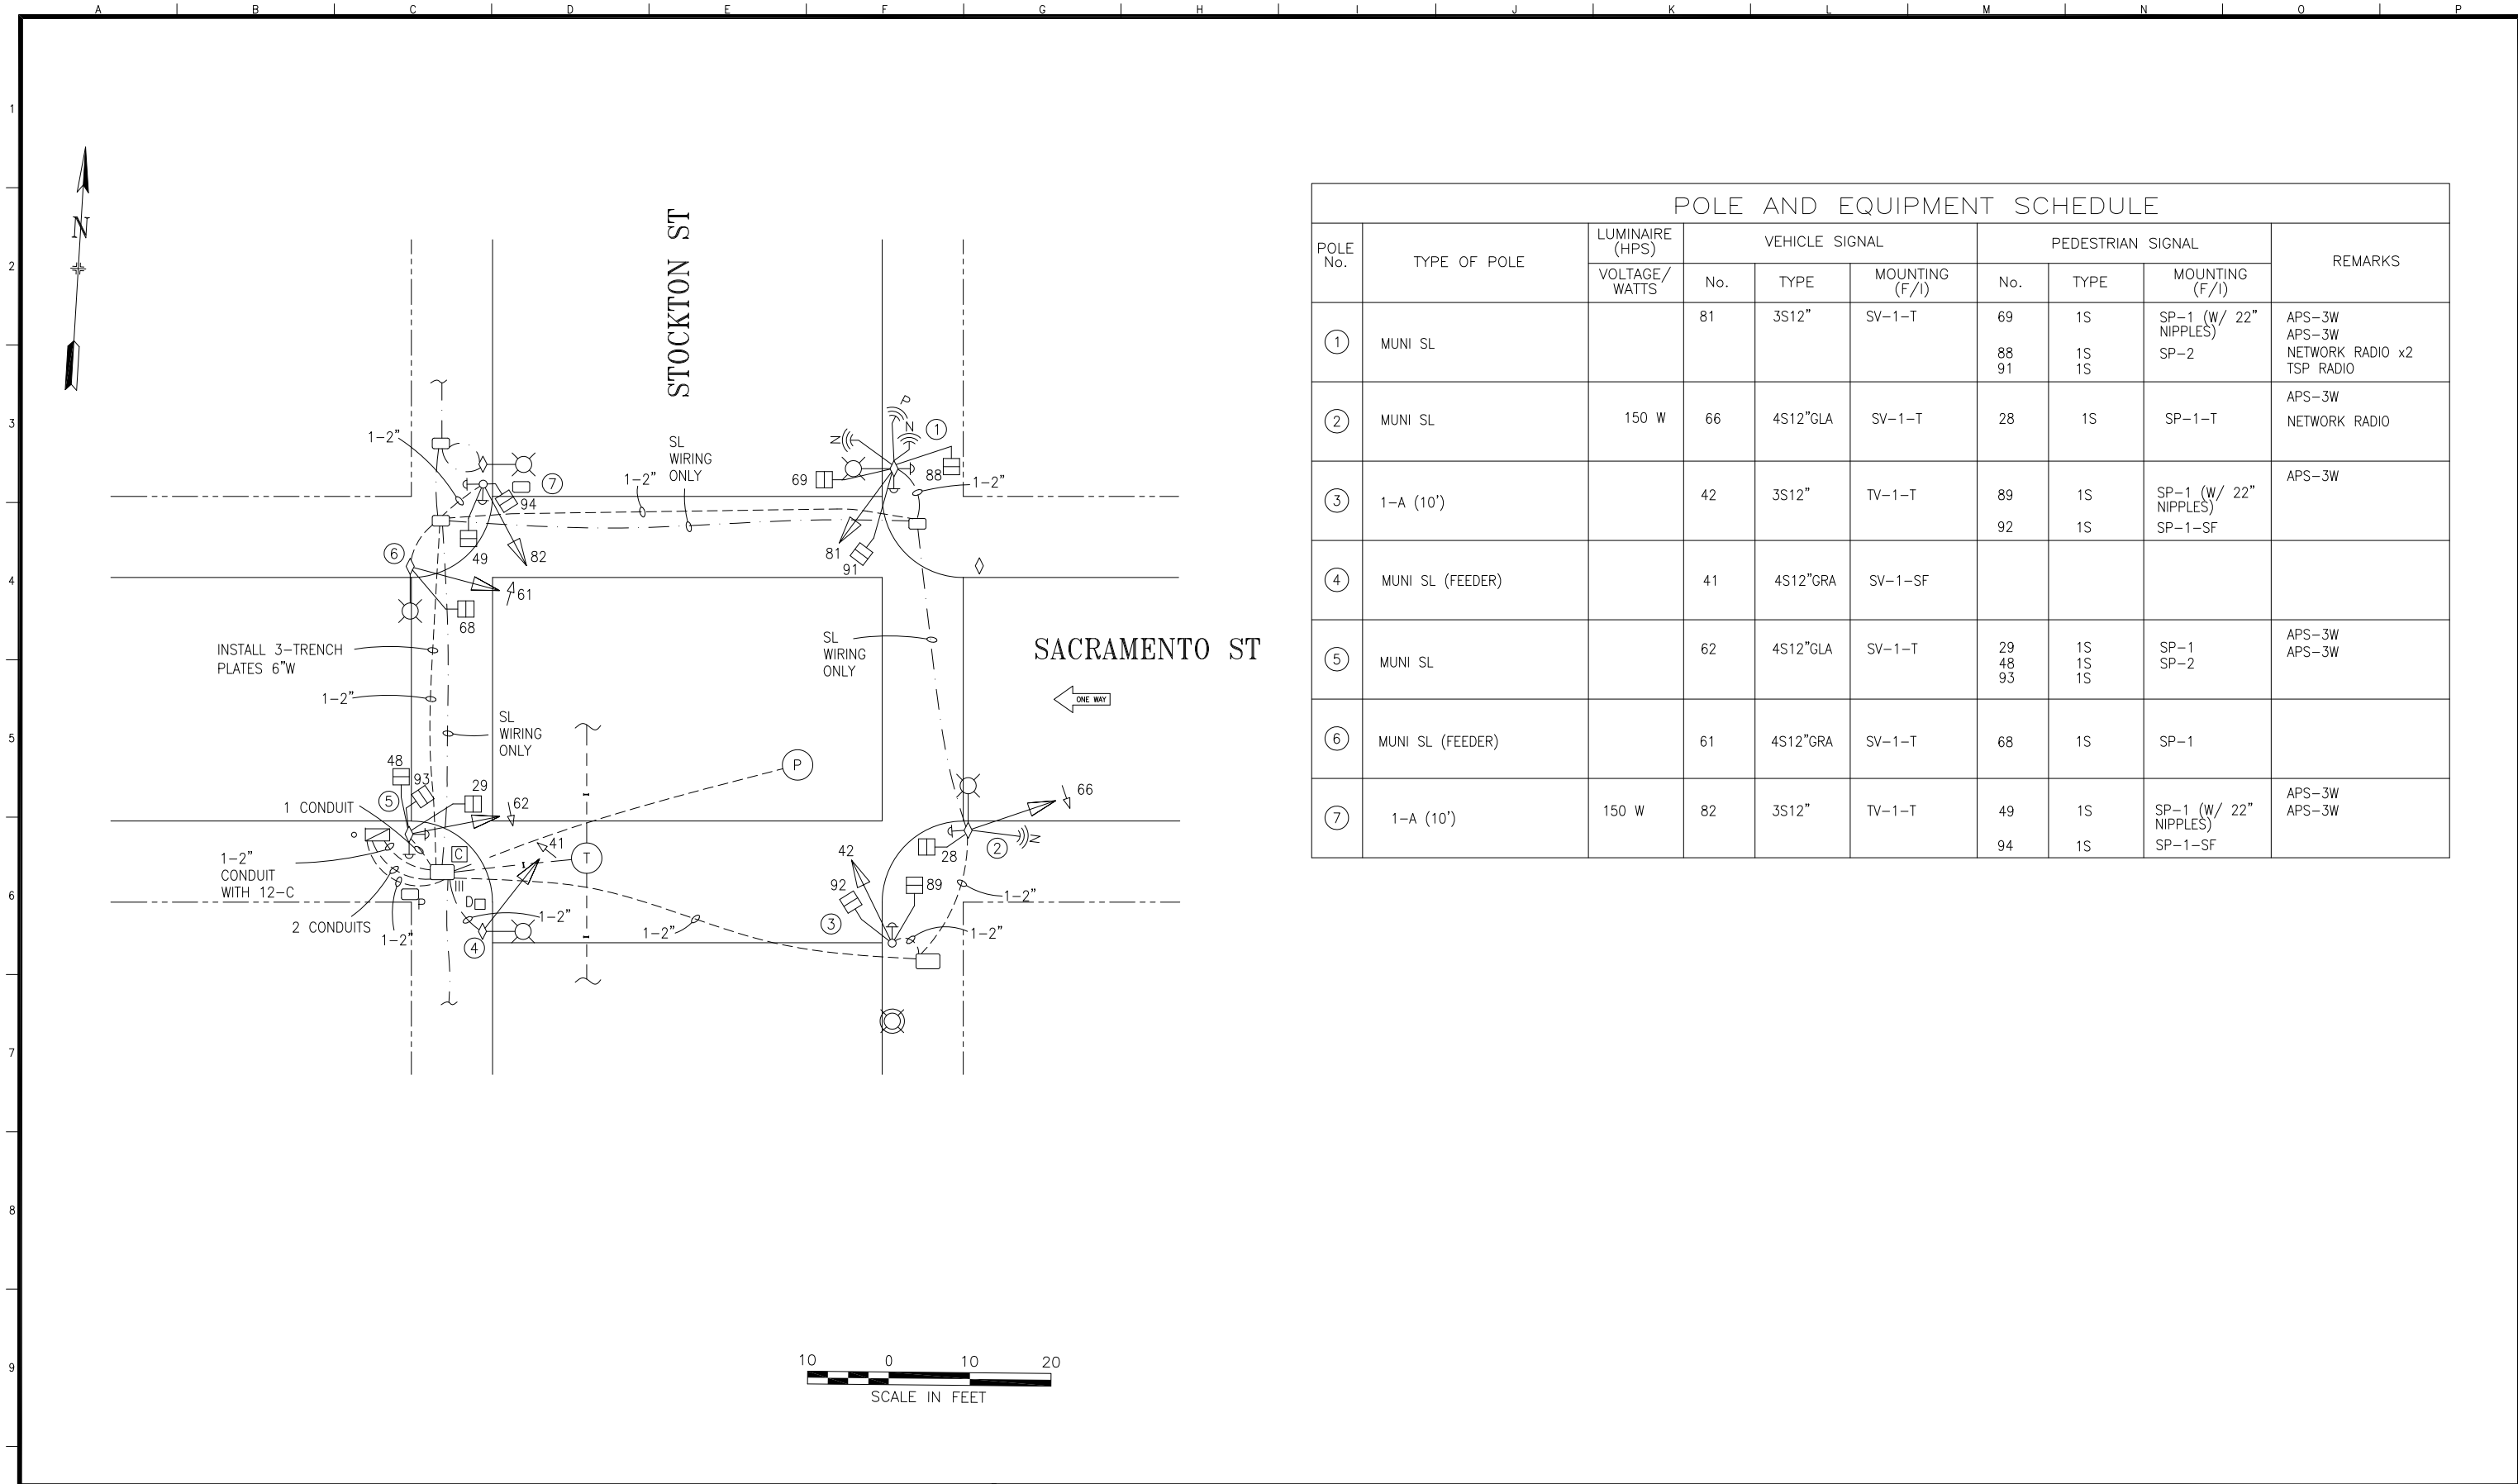

POLE AND EQUIPMENT SCHEDULE									
POLE No.	TYPE OF POLE	LUMINAIRE (HPS)	VEHICLE SIGNAL			PEDESTRIAN SIGNAL			REMARKS
		VOLTAGE/ WATTS	No.	TYPE	MOUNTING (F/I)	No.	TYPE	MOUNTING (F/I)	
①	MUNI SL		81	3S12"	SV-1-T	69	1S	SP-1 (W/ 22" NIPPLES)	APS-3W APS-3W NETWORK RADIO x2 TSP RADIO
②	MUNI SL	150 W	66	4S12"GLA	SV-1-T	28	1S	SP-1-T	APS-3W NETWORK RADIO
③	1-A (10')		42	3S12"	TV-1-T	89	1S	SP-1 (W/ 22" NIPPLES)	APS-3W
④	MUNI SL (FEEDER)		41	4S12"GRA	SV-1-SF				
⑤	MUNI SL		62	4S12"GLA	SV-1-T	29 48 93	1S 1S 1S	SP-1 SP-2	APS-3W APS-3W
⑥	MUNI SL (FEEDER)		61	4S12"GRA	SV-1-T	68	1S	SP-1	
⑦	1-A (10')	150 W	82	3S12"	TV-1-T	49	1S	SP-1 (W/ 22" NIPPLES)	APS-3W APS-3W
						94	1S	SP-1-SF	

3	5/5/23	ADD APS PER SRC 2022-199. NOTE TSP/NETWORK RADIOS PER FIELD	D. YEUNG	G. DE LEON
2	1/29/15	ADDED WBLT, WBRT, SBRT ARROWS, PED SCRAMBLE	J. R. SHAHAMIRI	B. WOO
1	10/9/14	CHANGED ALL 8" HEADS TO 12"	J. R. SHAHAMIRI	B. WOO
0	6/13/02	ACTIVATED SIGNAL UPGRADE THROUGH CT 26 (1987N); CONVERTED FROM AS-BUILTS.	G. DE LEON	M. VELASCO
NO.	DATE	DESCRIPTION	BY	APPROVED
TABLE OF REVISIONS CHECKOUT DRAWING THROUGH THE SID CUSTODIAN FOR THE LATEST REVISION				



SFMTA

DRAWN BY:	DATE:
G. DE LEON	09/2014
CHECKED BY:	DATE:
M. VELASCO	09/2014

SCALE
AS SHOWN
SHEET OF SHEETS
1 OF 1

TRAFFIC SIGNAL INVENTORY DIAGRAM	CNN NO: 24996000
SACRAMENTO AND STOCKTON STREETS	REV NO: 3