




NOTES:

1. CABINET FOUNDATION TYPE: 332
2. CABINET TYPE: CT-SF
3. SIGNALS WERE SWITCHED OVER ON 5/8/08

3	3/5/22	INSTALL NEW APS PER SRC 2021-308 & CALTRANS PROJECT	DYeung	GdeLeon
2	8/24/21	PER FIELD: UPGRADE 21-22-25,61,62,61 TO 12-INCH. RELOCATE 22,61,69,68 FROM POLE 1 TO UPGRADING 107 POLES 26,3. NO INDICATE ON 21,22,61, FC TO 1.1 USGS. FOR 21,22,24,25,61,61,61A, SPS-A TO 1.5. FOR 24,26 POLE 184 SHORTEN LUM ARM. NOTE WIRELESS SIGNALS, TPZ & PIZ. CAMERA, POLY 6 NOT USED. POLE 9 CONVERT TO T-4. WIRED LOOPS REMOVED BY PAVING. UPDATE CABINET SIZE	DYeung	GdeLeon
1	3/18/19	RELOCATED PPB FROM POLE 6 TO POLE 7 PER SRC 2019-054	CXLeung	MVelasco
0	5/8/08	SIGNALS TRANSFERRED TO CITY FROM CALTRANS (NEW HUMERUS, CONTROLLER, CABINET, PPB AND COUNTDOWNS)	DYeung	RJundal
NO.	DATE	DESCRIPTION	BY	APPROVED
TABLE OF REVISIONS				
CHECKOUT DRAWING THROUGH THE CUST DSIODANOR FOR THE LATEST REVISION				

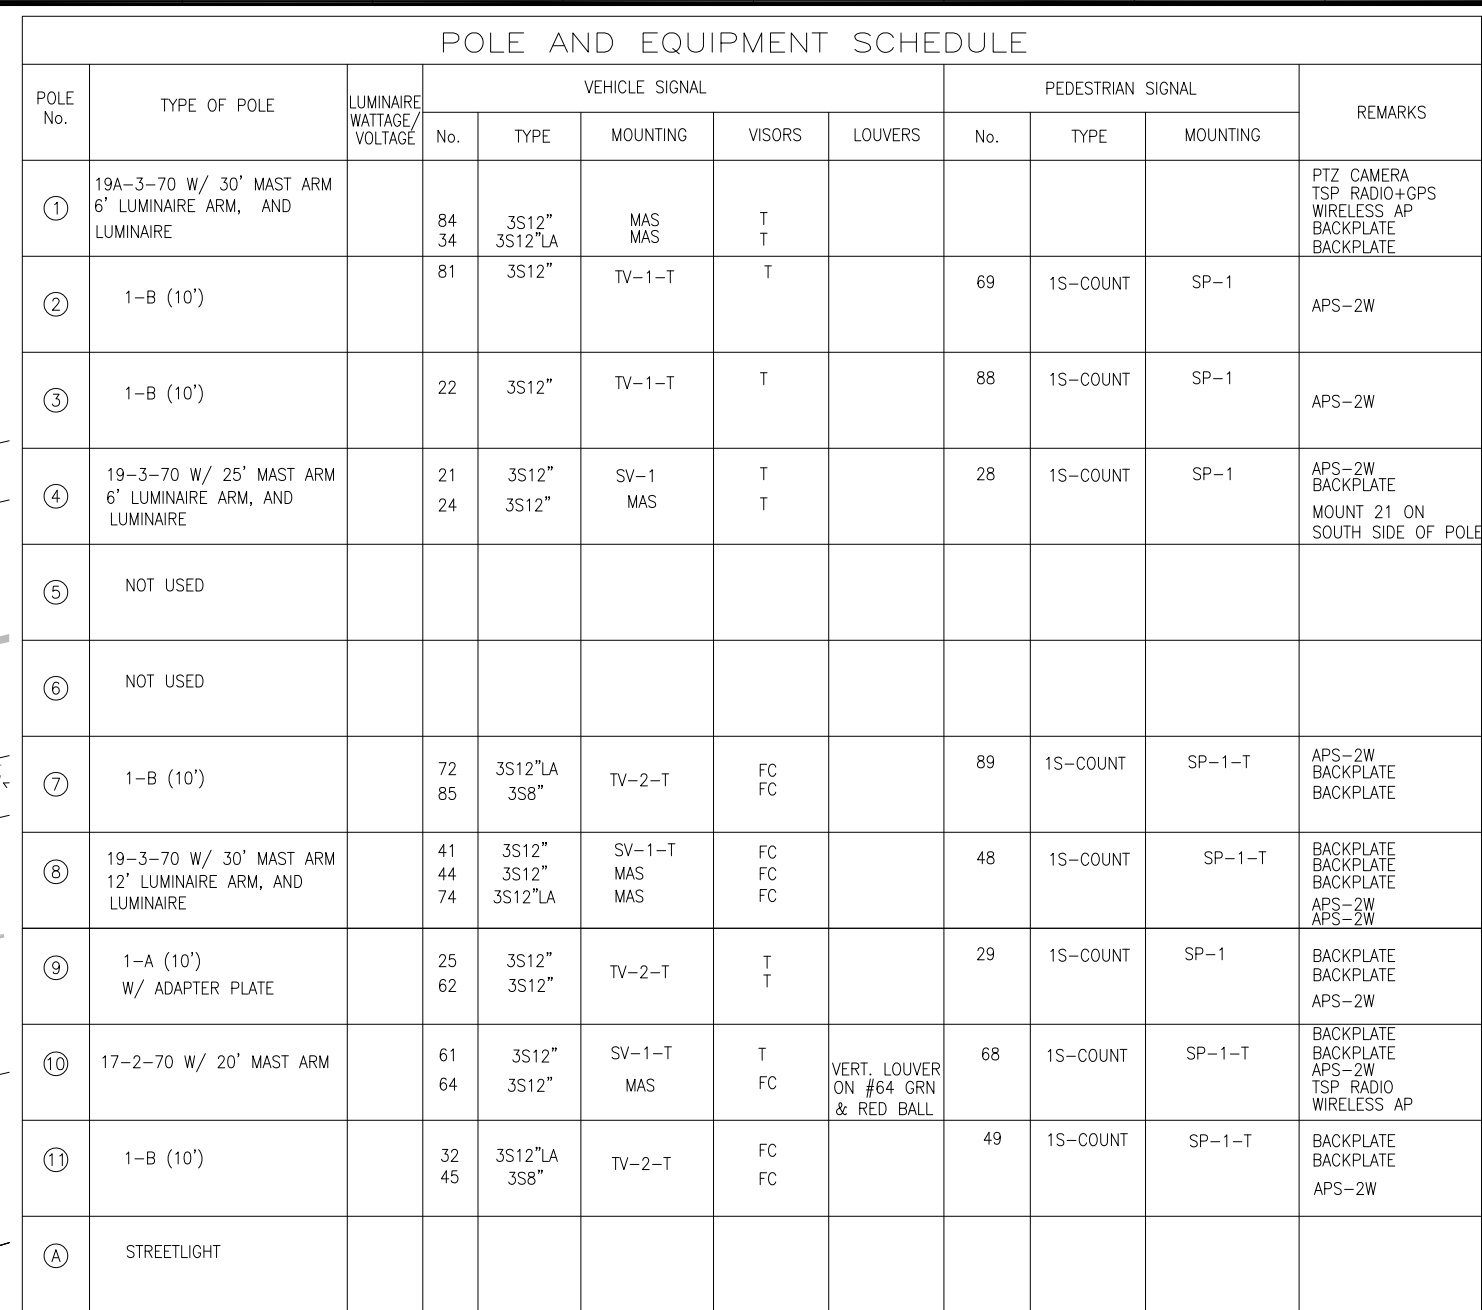

SFMTA

DRAWN BY: DY	DATE: 05/08
CHECKED BY: RJ	DATE: 05/08

SCALE
1" = 10'
SHEET OF SHEETS
1 OF 1

TRAFFIC SIGNAL INVENTORY DIAGRAM

SAN BRUNO AVE AND SILVER AVE

CNN NO:	20770000
REV NO:	3