


Z

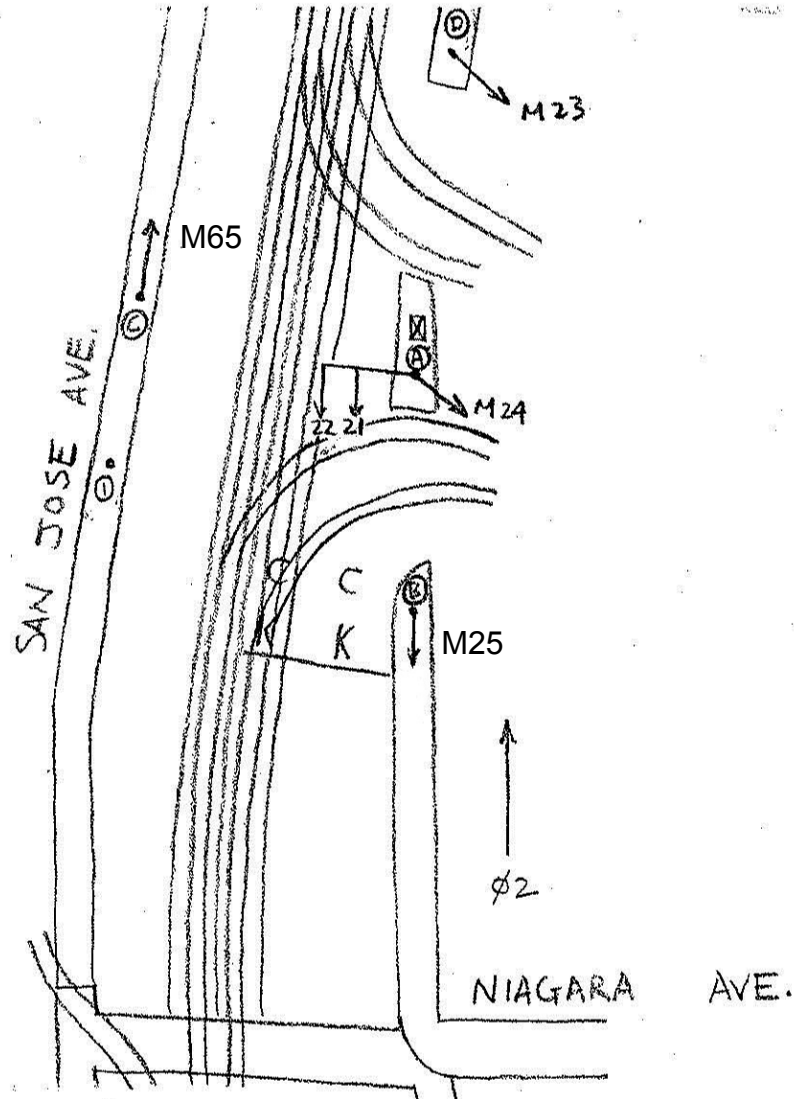

9/24/17

[illegible]

CONTROLLER CABINET SIZE : P BASE CABINET: _____

COMMENTS : Controller: Econolite Type "F". Signals M23 & M24 are Muni crossbuck signals. Converted Signals M25 & M65 from red/white "T" signals to red/white bar signals thru SRC 2017-224. Converted Signals 21 & 22 from 8 to 12 inches thru SRC 2014-237.

NOTE: MUNI track switch signal heads are not shown on this diagram.