


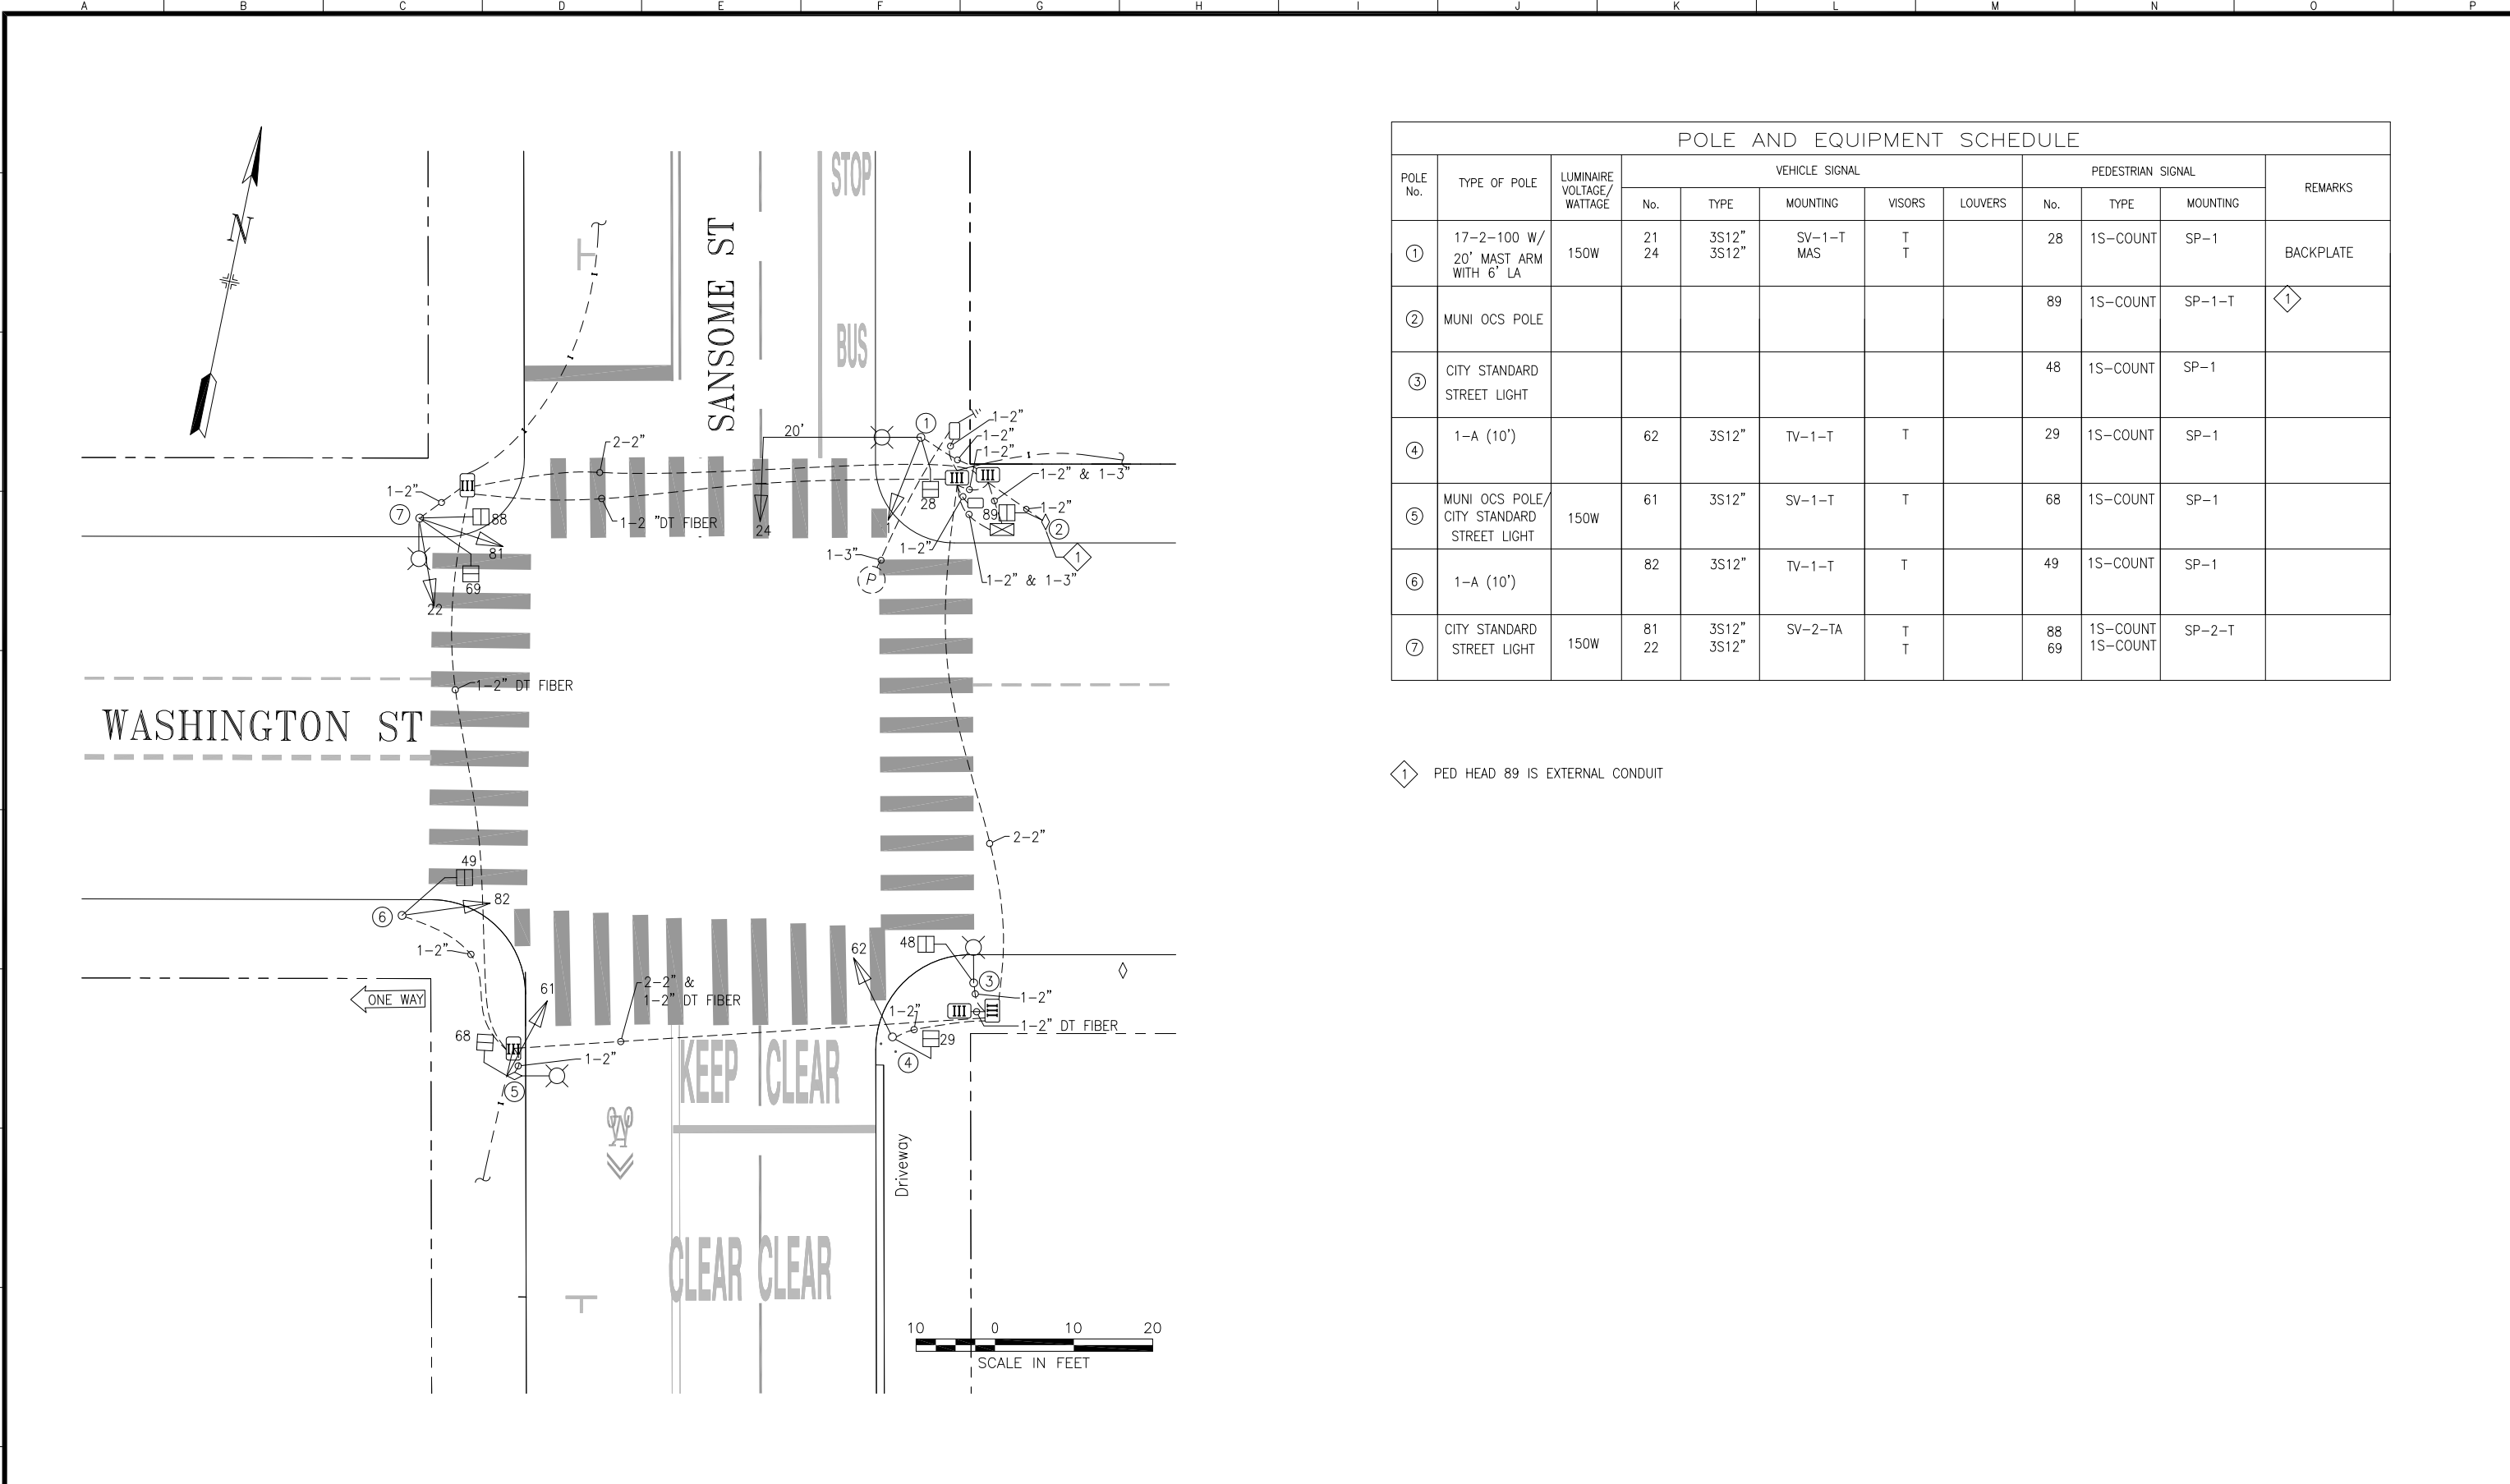

POLE AND EQUIPMENT SCHEDULE											
POLE No.	TYPE OF POLE	LUMINAIRE VOLTAGE/ WATTAGE	VEHICLE SIGNAL					PEDESTRIAN SIGNAL			REMARKS
			No.	TYPE	MOUNTING	VISORS	LOUVERS	No.	TYPE	MOUNTING	
①	17-2-100 W/ 20' MAST ARM WITH 6' LA	150W	21 24	3S12" 3S12"	SV-1-T MAS	T T		28	1S-COUNT	SP-1	BACKPLATE
②	MUNI OCS POLE							89	1S-COUNT	SP-1-T	①
③	CITY STANDARD STREET LIGHT							48	1S-COUNT	SP-1	
④	1-A (10')		62	3S12"	TV-1-T	T		29	1S-COUNT	SP-1	
⑤	MUNI OCS POLE/ CITY STANDARD STREET LIGHT	150W	61	3S12"	SV-1-T	T		68	1S-COUNT	SP-1	
⑥	1-A (10')		82	3S12"	TV-1-T	T		49	1S-COUNT	SP-1	
⑦	CITY STANDARD STREET LIGHT	150W	81 22	3S12" 3S12"	SV-2-TA	T T		88 69	1S-COUNT 1S-COUNT	SP-2-T	

① PED HEAD 89 IS EXTERNAL CONDUIT

0	5/26/16	ACTIVATED BY CONTRACT 2567J; CONVERTED BY AS-BUILTS	IRT	MV	
NO.	DATE	DESCRIPTION	BY	APP.	

TABLE OF REVISIONS
CHECK WITH TRACING TO SEE IF YOU HAVE LATEST REVISION

REFERENCE INFORMATION
& FILE NO. OF SURVEYS



SAN FRANCISCO MUNICIPAL TRANSPORTATION AGENCY
CITY AND COUNTY OF SAN FRANCISCO

DRAWN:	DATE:
IRT	11/15/17
CHECKED:	DATE:
MV	11/15/17

SCALE:
AS SHOWN

SHEET OF SHEETS

TRAFFIC SIGNAL INVENTORY DIAGRAM

SANSOME STREET AND WASHINGTON STREET

CNN NO.
24711000

REV NO.
0