


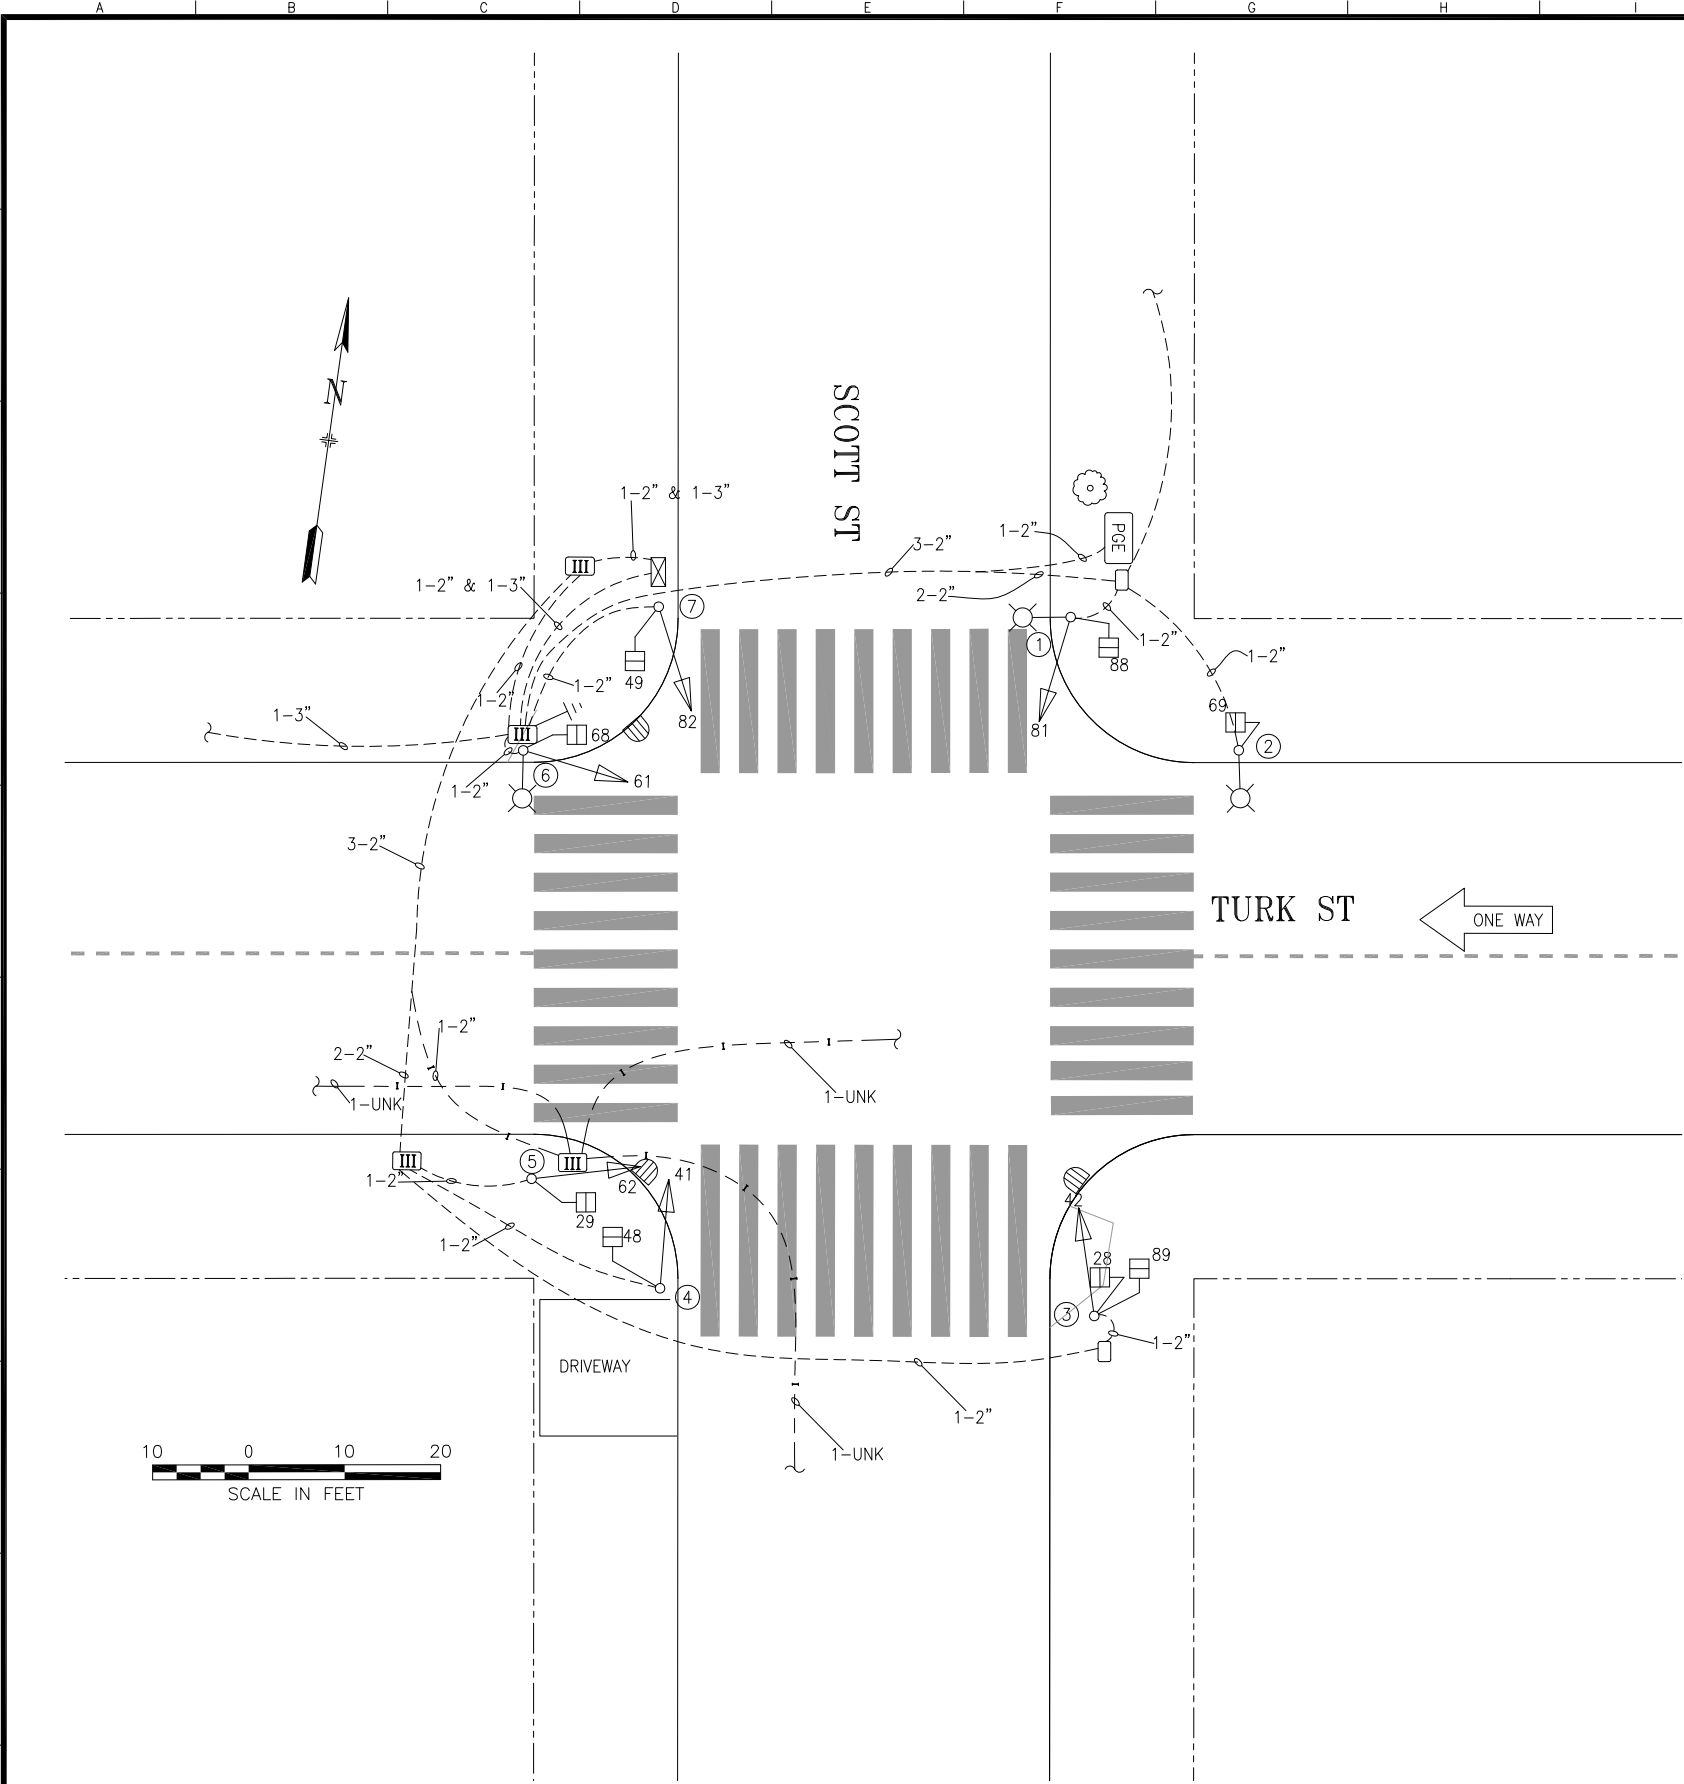

POLE AND EQUIPMENT SCHEDULE										
POLE No.	TYPE OF POLE	LUMINAIRE VOLTAGE/WATTAGE	VEHICLE SIGNAL					PEDESTRIAN SIGNAL		
			No.	TYPE	MOUNTING	VISORS	LOUVERS	No.	TYPE	MOUNTING
①	MARBLELITE STREET LIGHT		81	3S12"	SV-1-T	T		88	1S-COUNT	SP-1
②	CITY STANDARD STREET LIGHT							69	1S-COUNT	SP-1
③	1-A (10')		42	3S12"	TV-1-T	T		28 89	1S-COUNT 1S-COUNT	SP-1-SF (12") SP-1 (22")
④	1-A (10')		41	3S12"	TV-1-T	T		48	1S-COUNT	SP-1
⑤	1-A (13')		62	3S12"	TV-1-T	T		29	1S-COUNT	SP-1
⑥	MARBLELITE STREET LIGHT		61	3S12"	SV-1-T	T		68	1S-COUNT	SP-1
⑦	1-A (10')		82	3S12"	TV-1-T	T		49	1S-COUNT	SP-1
										MOUNT 61 AT 13'

0	5/2/14	ACTIVATED THRU 21424; CONVERTED FROM AS-BUILTS	JH	GD						
NO.	DATE	DESCRIPTION	BY	APP.						
TABLE OF REVISIONS										
CHECK WITH TRACING TO SEE IF YOU HAVE LATEST REVISION										

REFERENCE INFORMATION & FILE NO. OF SURVEYS



SAN FRANCISCO MUNICIPAL TRANSPORTATION AGENCY
CITY AND COUNTY OF SAN FRANCISCO

DRAWN: JH	DATE: 06/2016
CHECKED: GD	DATE: 3/2013

SCALE: AS SHOWN
SHEET OF SHEETS 1 OF 1

TRAFFIC SIGNAL INVENTORY DIAGRAM
SCOTT STREET AND TURK STREET

CNN NO. 26074000
REV NO. 0