


Switch Over: 06-12-2002

PHASE DIAGRAM

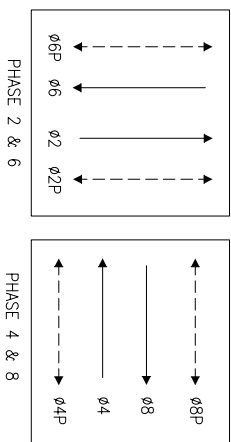


PHASE SEQUENCE



G		Y	R		STOCKTON ST
R		G		Y	VALLEJO ST
WM	FRH				PED XING VALLEJO
RH		WM	FRH		PED XING STOCKTON

DETAIL NOTES:

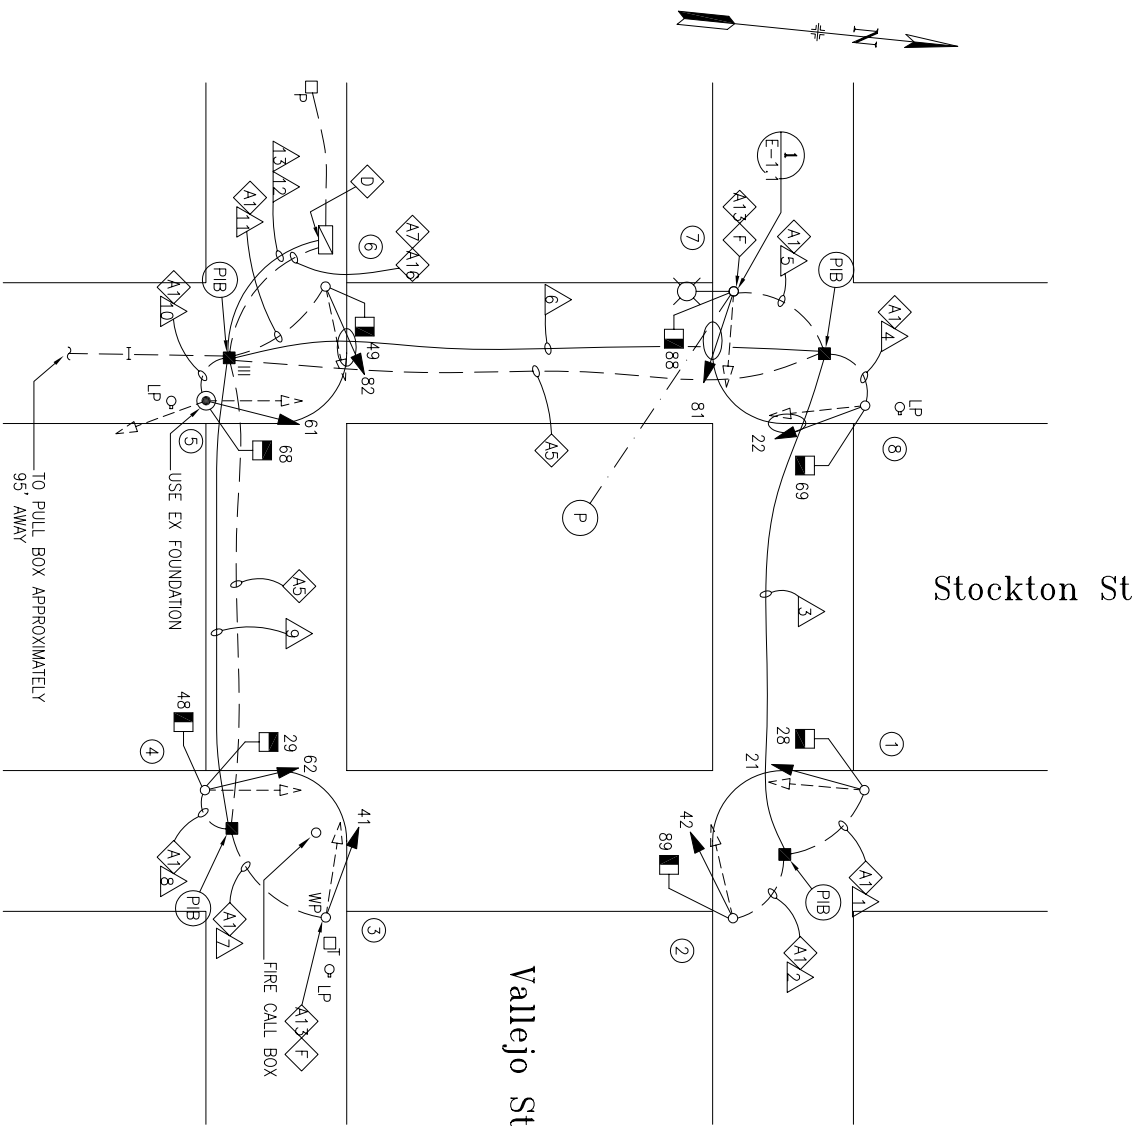- | | |
|-----|---|
| A17 | EX CONDUIT AND WIRING. R/C EX WIRING. F/I NEW WIRING AS NOTED. |
| A45 | EX CONDUIT AND WIRING. R/C EX WIRING. CUT CONDUIT FLUSH TO PULL BOX WALL OR 12" DEPTH. CAP OR DUCT SEAL ENDS. |
| A17 | EX CONDUIT AND WIRING. R/C EX WIRING EXCEPT 12/C. |
| A13 | R/C EX EXTERNAL CONDUIT. EX STUB UP TO REMAIN. F/I NEW EXTERNAL CONDUIT. |
| A16 | EX CONDUIT AND 12/C TO REMAIN |
| D | CHIP EX FOUNDATION CAREFULLY TO BRING CONDUIT INTO BASE OF STANDARD OR CONTROLLER CABINET AND REPAIR AFTER INSTALLATION. SIGNALS SHALL USE NEW EXTERNAL CONDUIT. SURFACE MOUNTED CONDUIT SHALL BE INSTALLED ON THE SIDE OPPOSITE THE ROADWAY OR INTERSECTION. |
| F | |





AS BUILT

REFERENCE INFORMATION & FILE NO. OF SURVEYS		 BUREAU OF ENGINEERING DEPARTMENT OF PUBLIC WORKS CITY AND COUNTY OF SAN FRANCISCO 		SPECIFICATION NO. 1987N	
NO.				DRAWING NO. E-4.0	
0				FILE NO. 74.255	
4/2000				REV. NO. 0	
NO.					
TABLE OF REVISIONS DISCRIPTION		DESIGNED: DATE: BC 6/2000	APPROVED:	SCALE: 1"=10'-0"	CONTRACT 26 VARIOUS LOCATIONS TRAFFIC SIGNAL MODIFICATIONS VALLEJO AND STOCKTON STREETS TRAFFIC SIGNAL WORK
NO.	DATE	DRAWN: DATE: BC 6/2000	DIVISION MANAGER DATE:	SHEET OF SHEETS 10 OF 37	
CHECK WITH TRACING TO SEE IF YOU HAVE LATEST REVISION		CHECKED: DATE: NKS 6/2000	CITY ENGINEER		

[illegible]

POLE AND EQUIPMENT SCHEDULE										
POLE No.	TYPE OF POLE	LUMINAIRE	VEHICLE SIGNAL			PEDESTRIAN SIGNAL			REMARKS	
		(HPS) VOLTAGE/ WATTS	No.	TYPE	MOUNTING (F'/I)	No.	TYPE	MOUNTING (F'/I)		
①	EX 1-A (10')		21	3S8"	TV-1		89	1S-IN	SP-1	
②	EX 1-A (10')		42	3S8"	TV-1		28	1S-IN	SP-1	
③	EX WOOD POLE		41	3S8"	SV-1-T					EXTERNAL RISER
④	EX 1-A (10')		62	3S8"	TV-1		29 48	1S-IN 1S-IN	SP-1 SP-1	
⑤	1-A (10')		61	3S8"	TV-1		68	1S-IN	SP-1	USE EX FOUNDATION
⑥	EX 1-A (10')		82	3S8"	TV-1		49	1S-IN	SP-1	
⑦	EX SL		81	3S8"	SV-1-T		88	1S-IN	SP-1-T	EXTERNAL RISER
⑧	EX 1-A (10')		22	3S8"	TV-1		69	1S-IN	SP-1	

AS BUILT

NO. 0 DATE 4/2000		TABLE OF REVISIONS DESCRIPTION BY APP.		CHECK WITH TRACING TO SEE IF YOU HAVE LATEST REVISION		REFERENCE INFORMATION & FILE NO. OF SURVEYS	
<div style="display: flex; justify-content: space-between; align-items: center;"> <div style="text-align: center;">  <p>BUREAU OF ENGINEERING DEPARTMENT OF PUBLIC WORKS CITY AND COUNTY OF SAN FRANCISCO</p> </div> <div style="text-align: center;">  </div> </div>							
DESIGNED: BC	DATE: 6/2000	APPROVED:	SCALE: NONE	CONTRACT 26 VARIOUS LOCATIONS		SPECIFICATION NO. 1987N	
DRAWN: BC	DATE: 6/2000	SECTION MANAGER DATE:	SHEET OF SHEETS 11 OF 37	TRAFFIC SIGNAL MODIFICATIONS		DRAWING NO. E-4.1	
CHECKED: NKS	DATE: 6/2000	DIVISION MANAGER DATE:		VALLEJO AND STOCKTON STREETS SCHEDULE		FILE NO. 74.256	
CITY ENGINEER			DATE:			REV. NO. 0	