



Switch Over: 06-13-2003

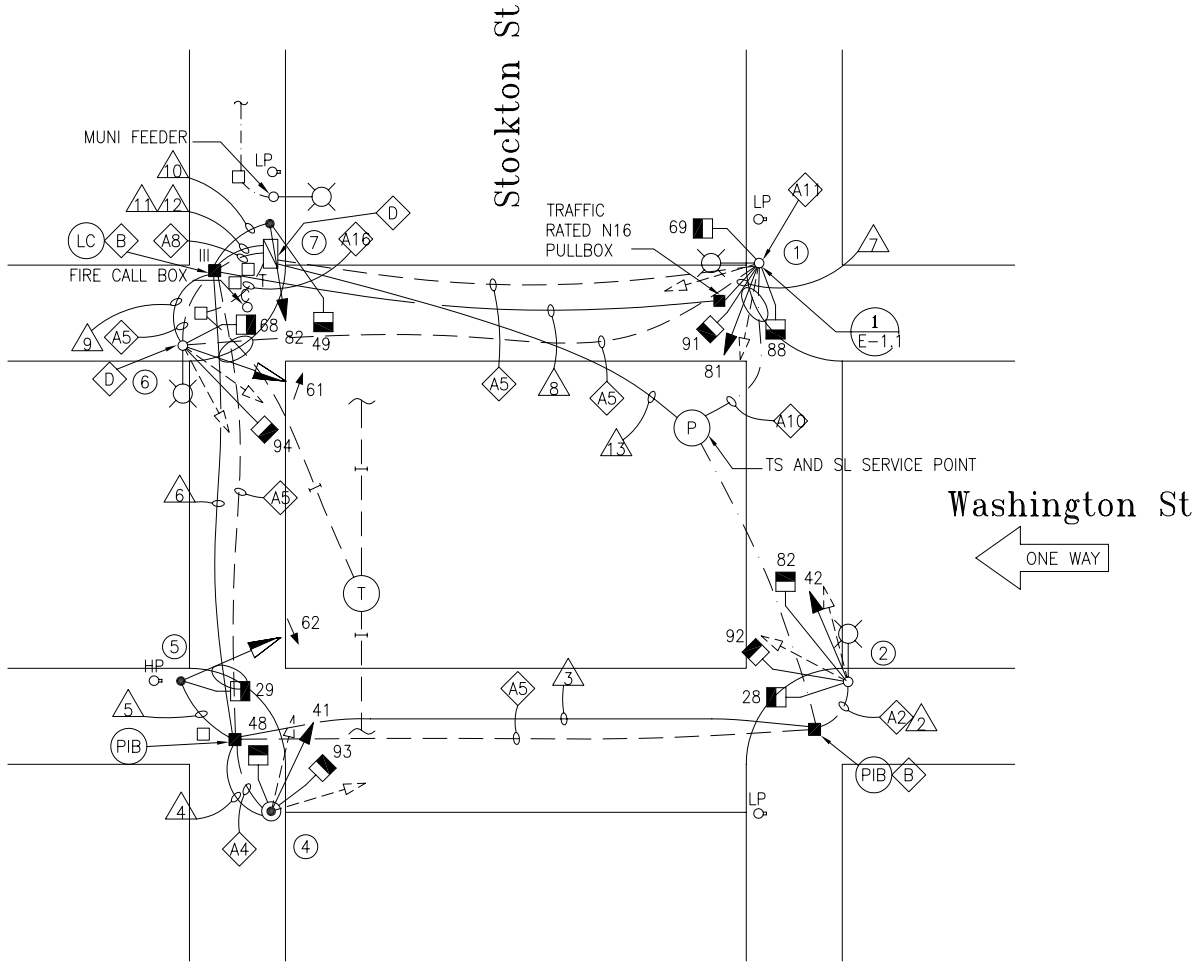

PHASE DIAGRAM

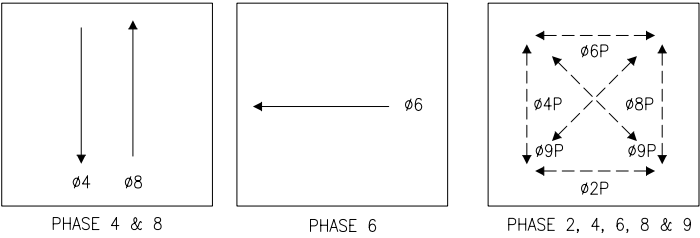

PHASE SEQUENCE

G	Y	R		STOCKTON ST
R	G+GLA+GRA	Y	R	WASHINGTON ST
RH		WM	FRH	PED XING STOCKTON AND WASHINGTON

DETAIL NOTES:

- A1 EX CONDUIT AND WIRING. R/C EX WIRING. F/I NEW WIRING AS NOTED.
- A2 EX CONDUIT AND WIRING. R/C EX TS WIRING. EX SL WIRING TO REMAIN. F/I NEW WIRING AS NOTED.
- A4 EX CONDUIT AND WIRING. R/C EX WIRING AND CONDUIT. REPAIR SIDEWALK TO MATCH EX.
- A5 EX CONDUIT AND WIRING. R/C EX WIRING. CUT CONDUIT FLUSH TO PULL BOX WALL OR 12" DEPTH, CAP OR DUCT SEAL END(S).
- A10 EX CONDUIT AND WIRING. R/C EX WIRING. ABANDON CONDUIT IN PLACE.
- A1 R/C EX SL AND/OR TS CONDUIT AND WIRING. F/I NEW EXTERNAL CONDUIT AND WIRING AS SHOWN.
- A16 EX CONDUIT AND 12/C TO REMAIN.
- B SPLICE NEW WIRING TO EX SL WIRING TO MAINTAIN SL CIRCUIT.
- D CHIP EX FOUNDATION CAREFULLY TO BRING CONDUIT(S) INTO BASE OF STANDARD OR CONTROLLER CABINET AND REPAIR AFTER INSTALLATION.


AS BUILT

3/02		PCO#8		BC	
4/30/01		ADDED DIAGONAL PED SIGNALS		BC	GL
4/2000		ISSUED FOR BID		BC	NKS
NO.	DATE	DESCRIPTION		BY	APP.
TABLE OF REVISIONS					
CHECK WITH TRACING TO SEE IF YOU HAVE LATEST REVISION					

REFERENCE INFORMATION & FILE NO. OF SURVEYS
--



BUREAU OF ENGINEERING
DEPARTMENT OF PUBLIC WORKS
CITY AND COUNTY OF SAN FRANCISCO

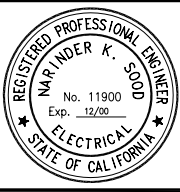

DESIGNED:	DATE:	APPROVED	
BC	6/2000	SECTION MANAGER	DATE:
DRAWN:	DATE:	DIVISION MANAGER	DATE:
BC	6/2000		
CHECKED:	DATE:	CITY ENGINEER	DATE:
NKS	6/2000		

SCALE:
1"=10'-0"
SHEET OF SHEETS
18 OF 37

CONTRACT 26 VARIOUS LOCATIONS
TRAFFIC SIGNAL MODIFICATIONS
WASHINGTON AND STOCKTON STREETS TRAFFIC SIGNAL WORK

SPECIFICATION NO. 1987N
DRAWING NO. E-8.0
FILE NO. 74,263
REV. NO. 2

[illegible]

POLE AND EQUIPMENT SCHEDULE									
POLE No.	TYPE OF POLE	LUMINAIRE (HPS)	VEHICLE SIGNAL			PEDESTRIAN SIGNAL			REMARKS
		VOLTAGE/WATTS	No.	TYPE	MOUNTING (F/I)	No.	TYPE	MOUNTING (F/I)	
①	EX MUNI SL		81	3S8"	SV-1-T	69 88 91	1S-IN 1S-IN 1S-IN	SP-1 (12") SP-2-T-SF	
②	EX SL		42	3S8"	SV-1-T	82 92 28	1S-IN 1S-IN 1S-IN	SP-1 (12") SP-2-T-SF	
③	NOT USED								
④	1-A (10')		41	3S8"	TV-1	48 93	1S-IN 1S-IN	SP-1 (22") SP-1-SF (12")	
⑤	1-A (10')		62	4S12"-GLA	TV-1-T	29	1S-IN	SP-1	
⑥	EX SL		61	4S12"-GRA	SV-1-T	68 94	1S-IN 1S-IN	SP-1 (22") SP-1-SF (12")	
⑦	1-A (10')		82	3S8"	TV-1	49	1S-IN	SP-1	

AS BUILT

[illegible]

T:\E-FILES\Goff\Records\Signal_Inventories\Bulls\DWG\CT26(1987N)\1987N_EEP8-FWG, Layout1, 9/24/2004 11:23:47 AM: XREF1
 C:\WINNT\OS\15/2000 FONTS\USA1.TTF:ROMANS, ROMANT
 PLOT SCALE: