


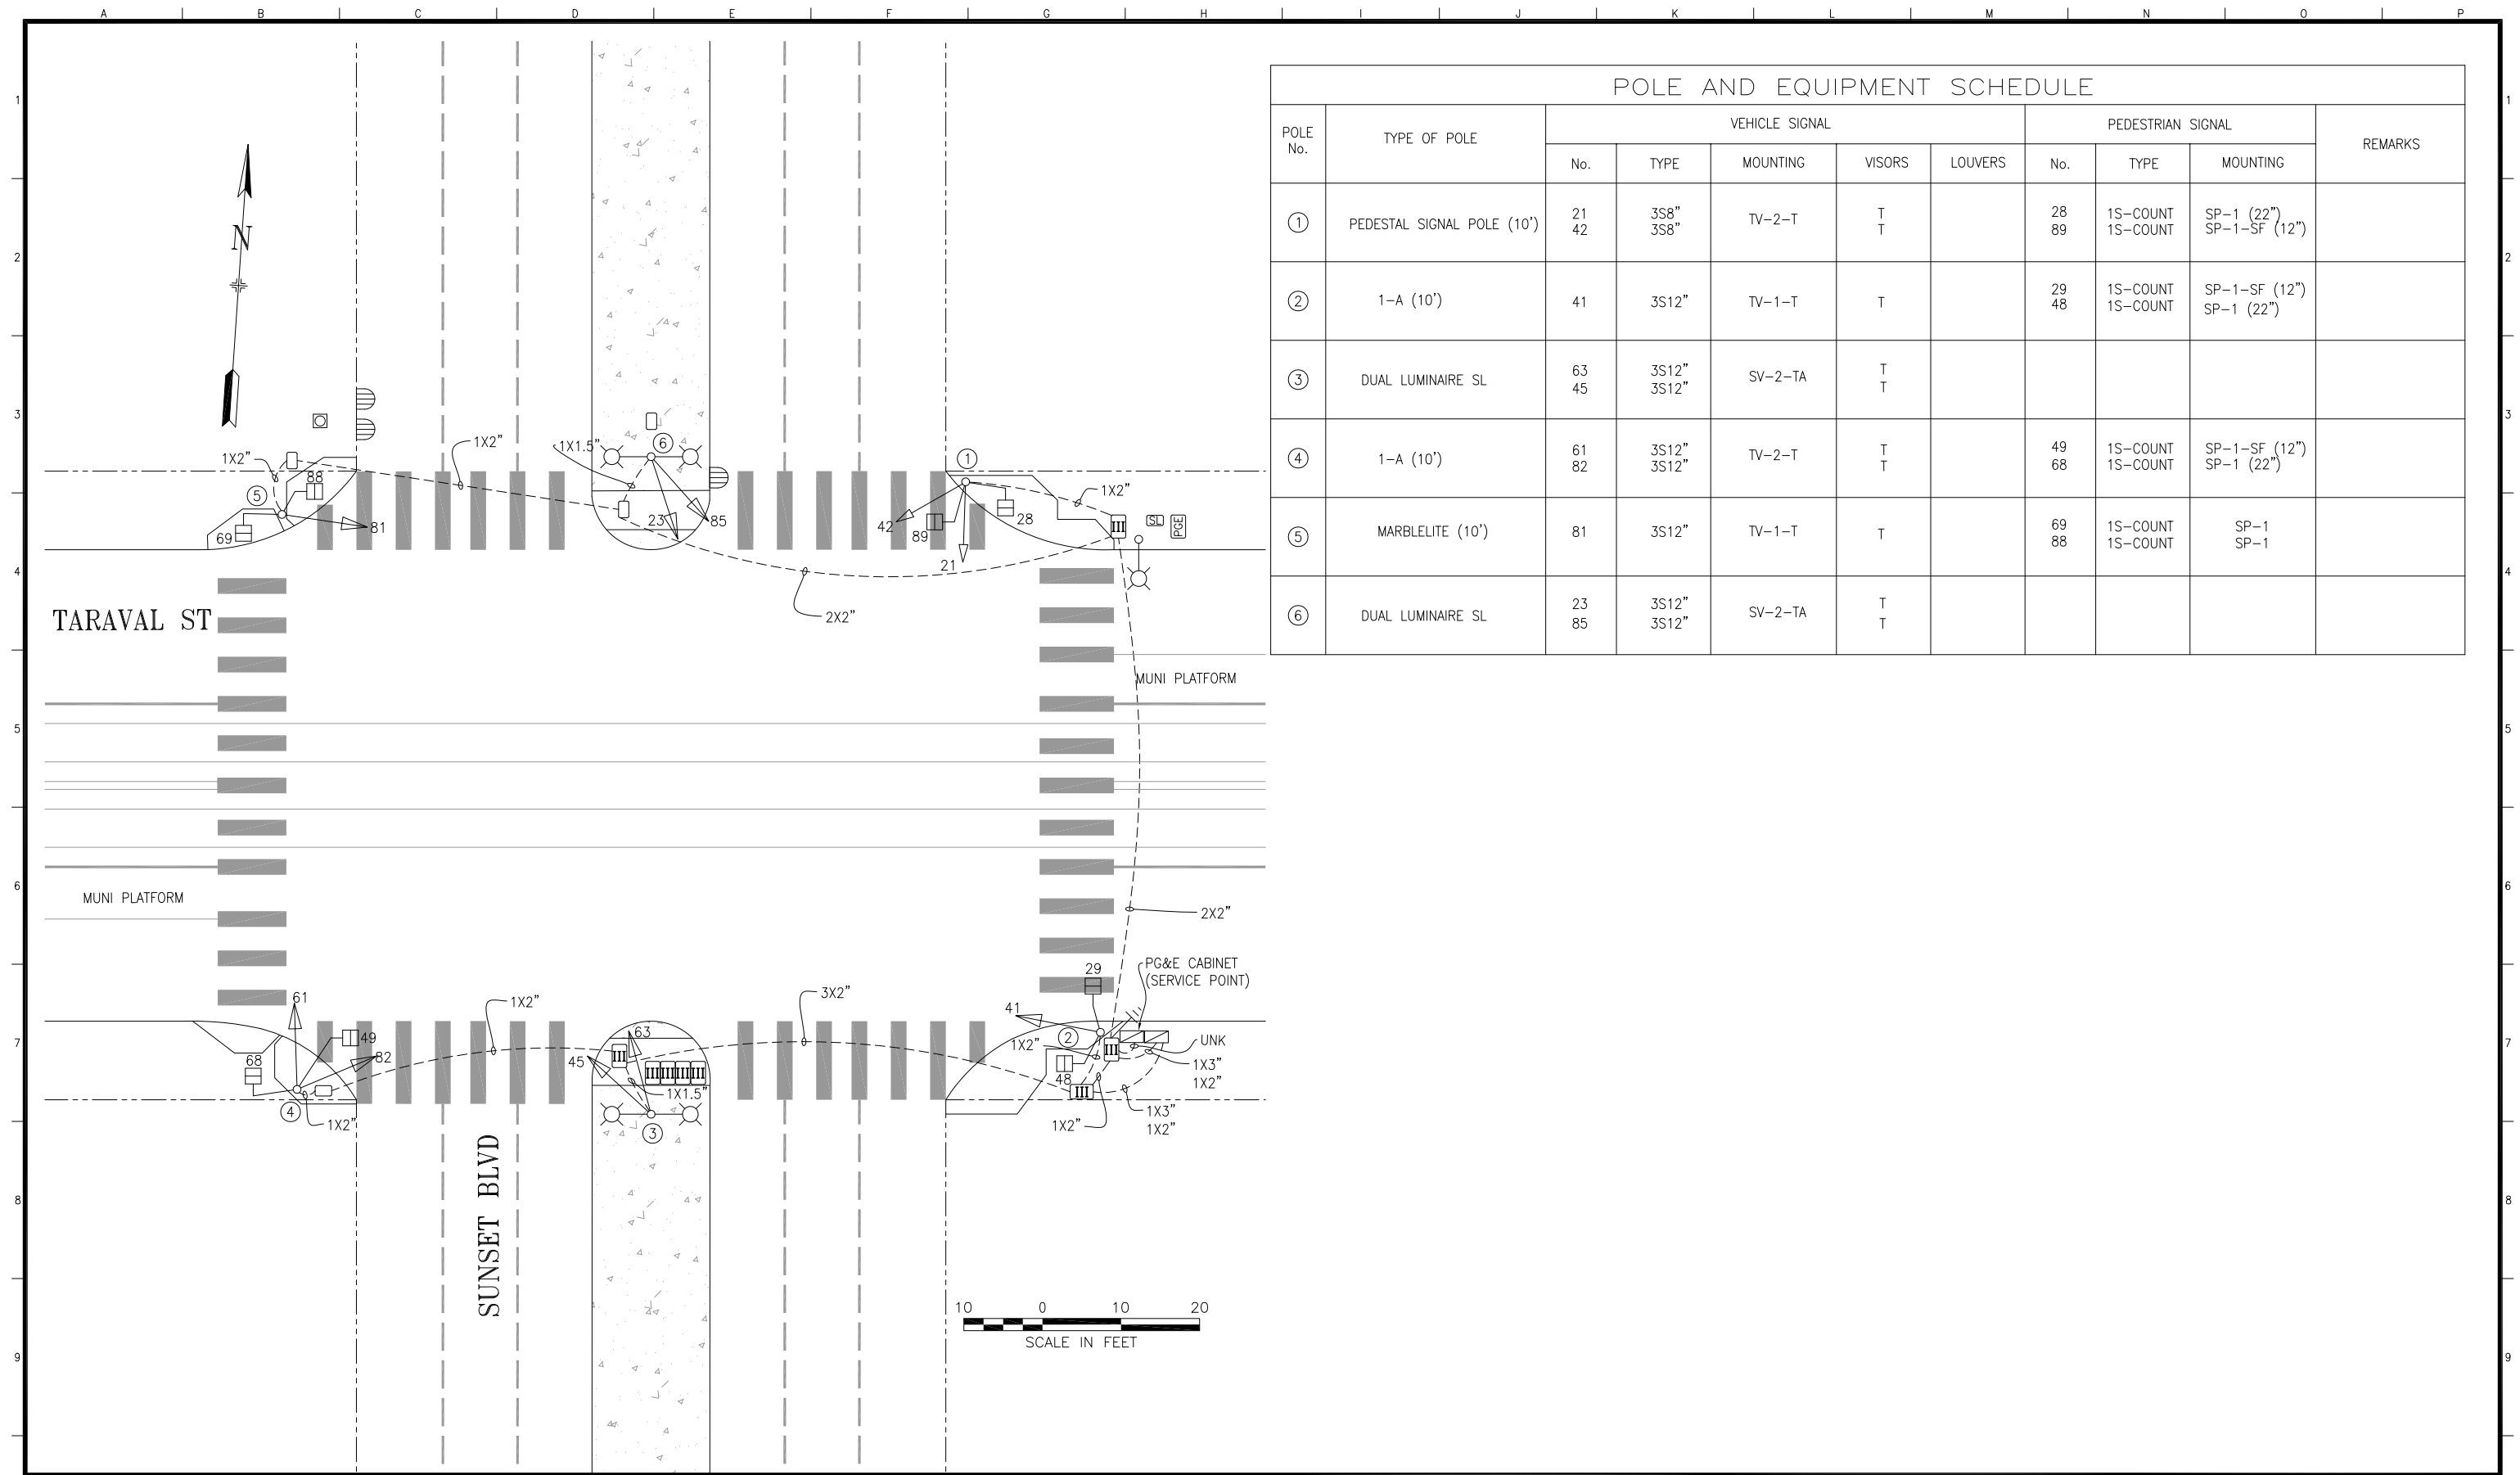

POLE AND EQUIPMENT SCHEDULE										
POLE No.	TYPE OF POLE	VEHICLE SIGNAL					PEDESTRIAN SIGNAL			REMARKS
		No.	TYPE	MOUNTING	VISORS	LOUVERS	No.	TYPE	MOUNTING	
①	PEDESTAL SIGNAL POLE (10')	21 42	3S8" 3S8"	TV-2-T	T T		28 89	1S-COUNT 1S-COUNT	SP-1 (22") SP-1-SF (12")	
②	1-A (10')	41	3S12"	TV-1-T	T		29 48	1S-COUNT 1S-COUNT	SP-1-SF (12") SP-1 (22")	
③	DUAL LUMINAIRE SL	63 45	3S12" 3S12"	SV-2-TA	T T					
④	1-A (10')	61 82	3S12" 3S12"	TV-2-T	T T		49 68	1S-COUNT 1S-COUNT	SP-1-SF (12") SP-1 (22")	
⑤	MARBLELITE (10')	81	3S12"	TV-1-T	T		69 88	1S-COUNT 1S-COUNT	SP-1 SP-1	
⑥	DUAL LUMINAIRE SL	23 85	3S12" 3S12"	SV-2-TA	T T					

[illegible]

REFERENCE INFORMATION
& FILE NO. OF SURVEYS



SAN FRANCISCO MUNICIPAL TRANSPORTATION AGENCY
CITY AND COUNTY OF SAN FRANCISCO

DRAWN:	DATE:
AS	9/2015
CHECKED:	DATE:
MV	9/2015

SCALE:

AS SHOWN

SHEET OF SHEETS

1 OF 1

TRAFFIC SIGNAL INVENTORY DIAGRAM

SUNSET BOULEVARD AND TARAVAL STREET

CNN NO

23384000

REV NO.