


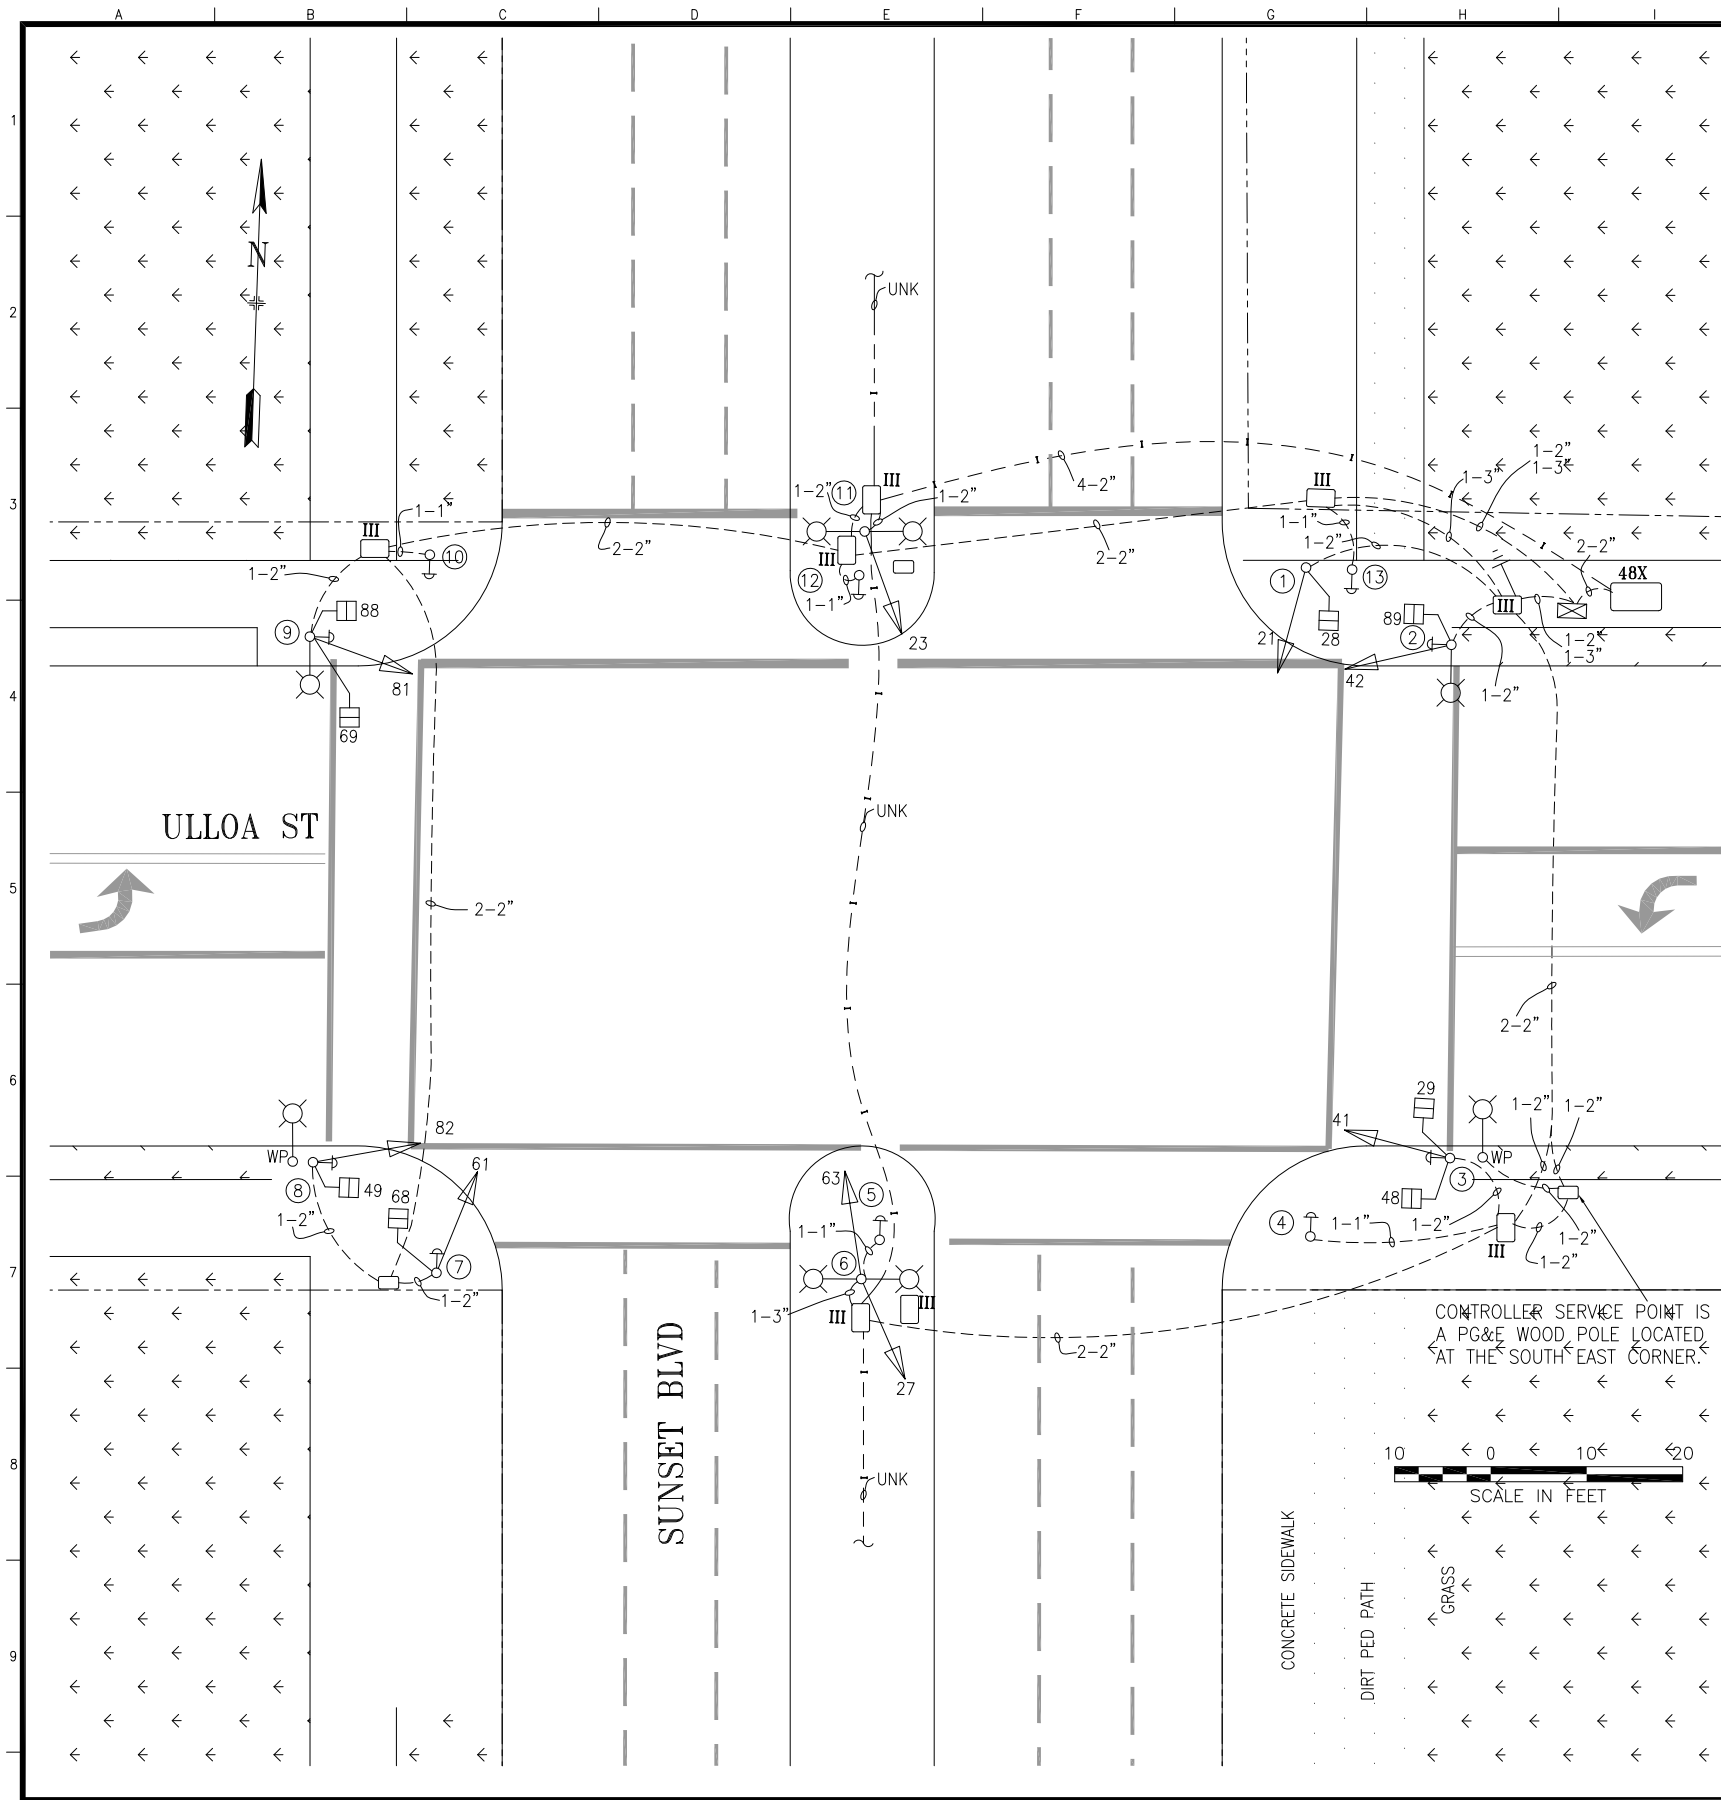

POLE AND EQUIPMENT SCHEDULE											
POLE No.	TYPE OF POLE	LUMINAIRE VOLTAGE/ WATTAGE	VEHICLE SIGNAL					PEDESTRIAN SIGNAL			REMARKS
			No.	TYPE	MOUNTING	VISORS	LOUVERS	No.	TYPE	MOUNTING	
①	1-A (13')		21	3S12"	TV-1-T	T		28	1S-COUNT	SP-1 (22")	MOUNT 21 ON CURB SIDE OF POLE
②	CITY STANDARD STREET LIGHT	120V/ 150W	42	3S12"	SV-1-T	T		89	1S-COUNT	SP-1	APS-2W
③	1-A (10')		41	3S12"	TV-1-T	T		29 48	1S-COUNT 1S-COUNT	SP-1-SF (12") SP-1 (22")	APS-2W
④	PPB POST										APS-2W
⑤	PPB POST										APS-2W
⑥	EX MARBELITE SL W/ DUAL LUMINAIRE ARMS		27 63	3S12" 3S12"	SV-2-TA	T T					
⑦	1-A (10')		61	3S12"	TV-1-T	T		68	1S-COUNT	SP-1 (22")	MOUNT 61 ON CURB SIDE OF POLE APS-2W
⑧	1-A (10')		82	3S12"	TV-1-T	T		49	1S-COUNT	SP-1	APS-2W
⑨	CITY STANDARD STREET LIGHT	120V/ 150W	81	3S12"	SV-1-T	T		69 88	1S-COUNT 1S-COUNT	SP-1-SF (12") SP-1 (22")	APS-2W
⑩	PPB POST										APS-2W
⑪	EX MARBELITE SL W/ DUAL LUMINAIRE ARMS		23	3S12"	SV-1-T	T					MOUNT 23 AT 13'
⑫	PPB POST										APS-2W
⑬	PPB POST										APS-2W

TABLE OF REVISIONS		CHECK WITH TRACING TO SEE IF YOU HAVE LATEST REVISION	
NO.	DATE	DESCRIPTION	BY APP.
1	7/18/17	ADD ALL 5 PPB POSTS VIA 2821J. ADD APS VIA SRC 2017-113	DYeung/GDeLeon
0	12/19/13	ACTIVATED NEW SIGNALS THROUGH 2109J	SS GD

REFERENCE INFORMATION & FILE NO. OF SURVEYS	



SAN FRANCISCO MUNICIPAL TRANSPORTATION AGENCY

CITY AND COUNTY OF SAN FRANCISCO

DRAWN:	DATE:
SS	07/14
CHECKED:	DATE:
GD	07/14

SCALE:
AS SHOWN
SHEET OF SHEETS
1 OF 1

TRAFFIC SIGNAL INVENTORY DIAGRAM
SUNSET BOULEVARD AND ULLOA STREET

CNN NO.
23383000
REV NO.
1