



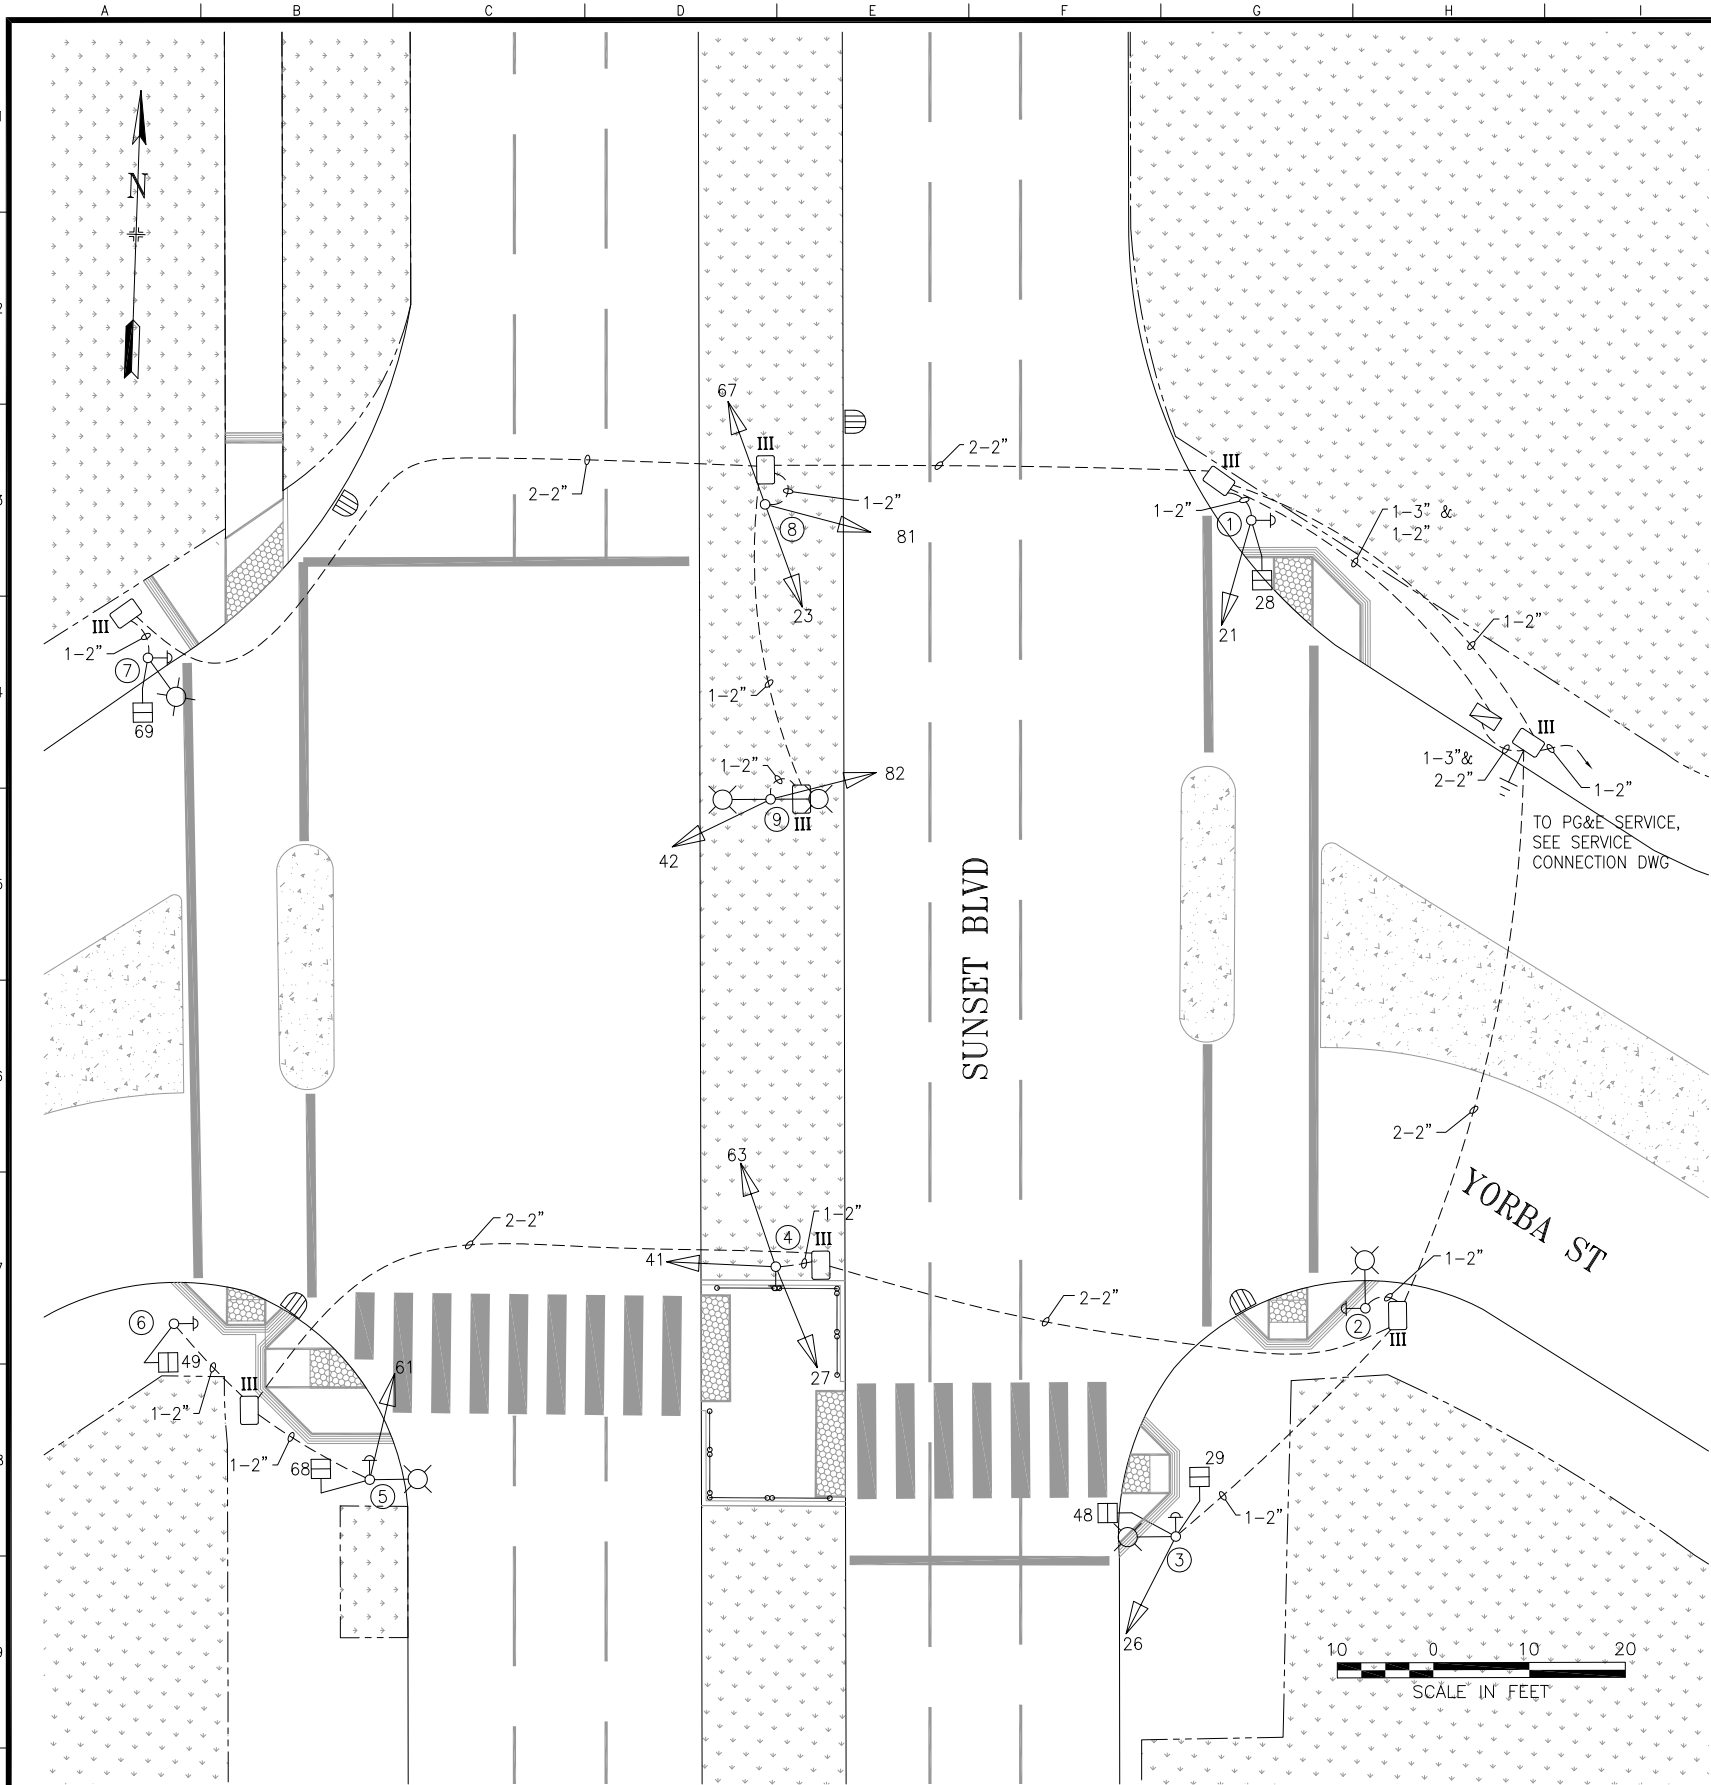

POLE AND EQUIPMENT SCHEDULE											
POLE No.	TYPE OF POLE	LUMINAIRE VOLTAGE/ WATTAGE	VEHICLE SIGNAL					PEDESTRIAN SIGNAL			REMARKS
			No.	TYPE	MOUNTING	VISORS	LOUVERS	No.	TYPE	MOUNTING	
①	1-A (10')		21	3S12"	TV-1-T	T		28	1S-COUNT	SP-1	APS PPB
②	CITY STANDARD STREET LIGHT										APS PPB
③	CITY STANDARD STREET LIGHT		26	3S12"	SV-1-T	T		29 48	1S-COUNT 1S-COUNT	SP-1 (22") SP-1 (22")	APS PPB
④	1-A (15')		27 41 63	3S12" 3S12"FY 3S12"	SV-3-T	T T T					APS PPB
⑤	CITY STANDARD STREET LIGHT		61	3S12"	SV-1-T	T		68	1S-COUNT	SP-1	APS PPB
⑥	1-A (7')							49	1S-COUNT	TP-1-T	APS PPB
⑦	CITY STANDARD STREET LIGHT							69	1S-COUNT	SP-1	APS PPB
⑧	1-A (15')		23 81 67	3S12" 3S12" 3S12"	SV-3-T	T T T					
⑨	EX. MARBELITE STREET LIGHT		42 82	3S12"FY 3S12"	SV-2-T	T T					

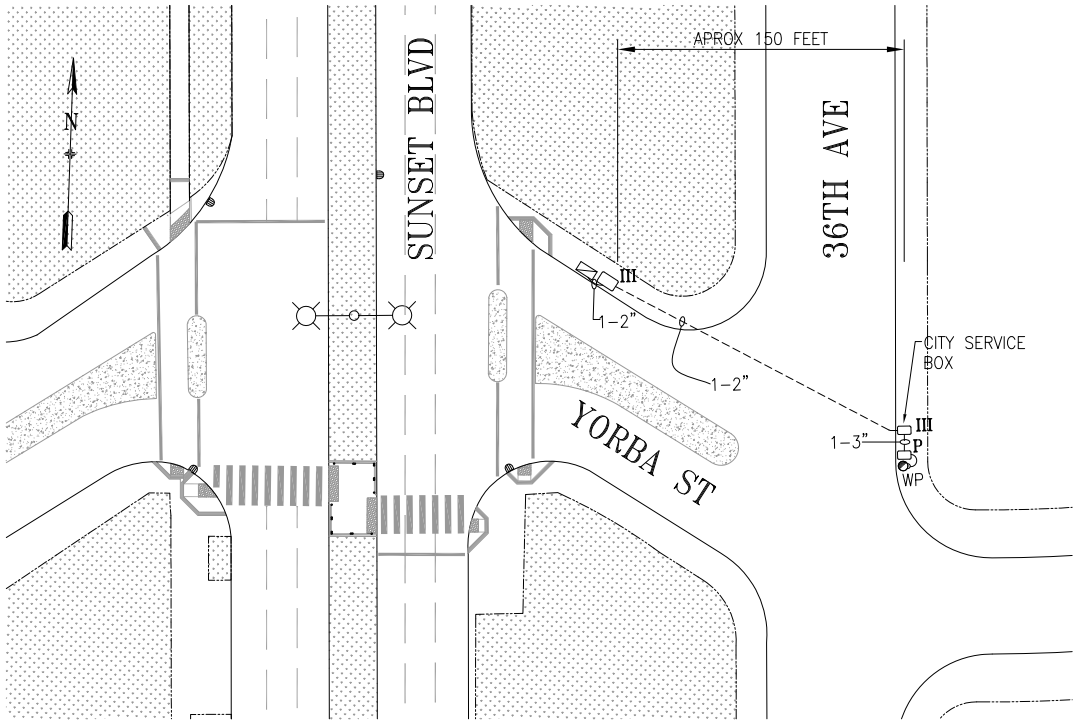

SERVICE CONNECTION WIRING DETAIL ①
NOT TO SCALE

NO.	DATE	DESCRIPTION	BY	APP.
0	7/28/14	ACTIVATED BY 2142J; CONVERTED FROM AS-BUILTS	JH	GD
TABLE OF REVISIONS CHECK WITH TRACING TO SEE IF YOU HAVE LATEST REVISION				

REFERENCE INFORMATION
& FILE NO. OF SURVEYS



SAN FRANCISCO MUNICIPAL TRANSPORTATION AGENCY
CITY AND COUNTY OF SAN FRANCISCO

DRAWN:	DATE:
JH	8/2017
CHECKED:	DATE:
GD	8/2017

SCALE:
AS SHOWN
SHEET OF SHEETS
01 OF 01

TRAFFIC SIGNAL INVENTORY DIAGRAM

SUNSET BOULEVARD AND YORBA STREET

CNN NO.
23366000
REV NO.
0