


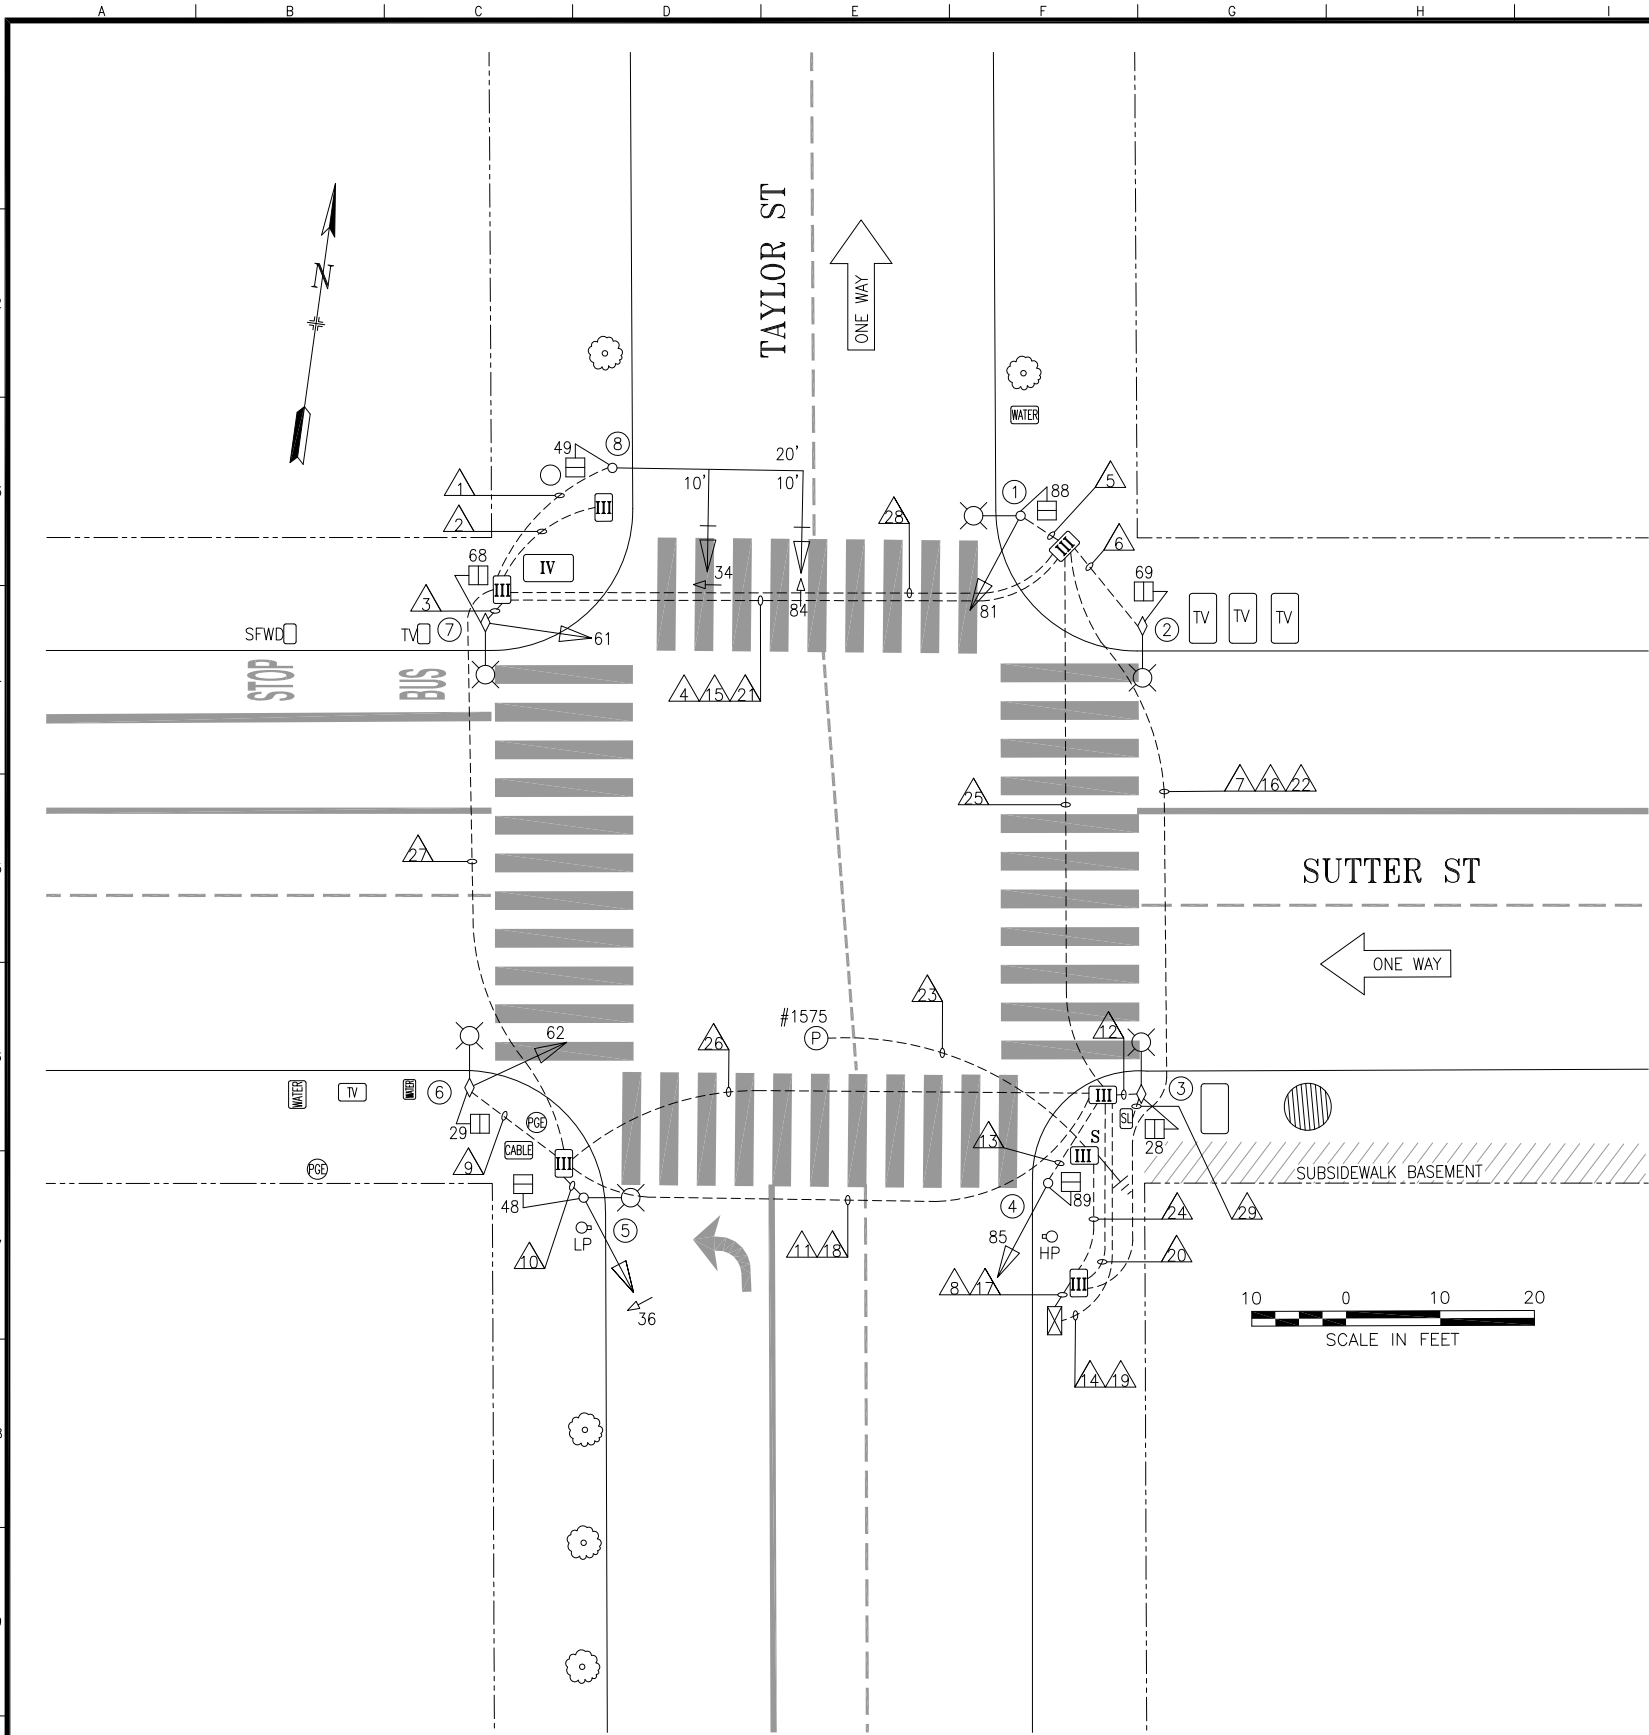

POLE AND EQUIPMENT SCHEDULE											
POLE No.	TYPE OF POLE	LUMINAIRE VOLTAGE/ WATTAGE	VEHICLE SIGNAL					PEDESTRIAN SIGNAL			REMARKS
			No.	TYPE	MOUNTING	VISORS	LOUVERS/BP	No.	TYPE	MOUNTING	
①	CITY STANDARD STREETLIGHT		81	3S12"	SV-1-T	T		88	1S-COUNT	SP-1	81 MOUNTED AT 13'
②	MUNI POLE W/ ORNAMENTAL SL							69	1S-COUNT	SP-1	
③	MUNI POLE W/ ORNAMENTAL SL							28	1S-COUNT	SP-1	
④	1-A (10')		85	3S12"	TV-1-T	T		89	1S-COUNT	SP-1	
⑤	CITY STANDARD STREETLIGHT		36	3S12"LA	SV-1-T	T		48	1S-COUNT	SP-1	
⑥	MUNI POLE W/ ORNAMENTAL SL		62	3S12"	SV-1-T	T		29	1S-COUNT	SP-1	
⑦	MUNI POLE W/ ORNAMENTAL SL		61	3S12"	SV-1-T	T		68	1S-COUNT	SP-1	
⑧	16-3-100 W/ 20' MA		34 84	3S12"LA 3S12"GSA	MAS MAS	T T	BP BP	49	1S-COUNT	SP-1	

0	03/23/17	SIGNAL UPGRADE BY 2595J, CONVERTED FROM AS BUILT		D YOUNG	G DELEON
NO.	DATE	DESCRIPTION		BY	APP.
TABLE OF REVISIONS					
CHECK WITH TRACING TO SEE IF YOU HAVE LATEST REVISION					

REFERENCE INFORMATION & FILE NO. OF SURVEYS



SAN FRANCISCO MUNICIPAL TRANSPORTATION AGENCY

CITY AND COUNTY OF SAN FRANCISCO

DRAWN:	DATE:
D YOUNG	10/2019
CHECKED:	DATE:
G DELEON	10/2019

SCALE:
AS SHOWN
SHEET OF SHEETS
1 OF 2

TRAFFIC SIGNAL INVENTORY DIAGRAM
SUTTER STREET AND TAYLOR STREET

CNN NO.
24958000
REV NO.
0

