


EXISTING EQUIPMENT


5/25/21 Traffic Signal Switchover
9:30am Dark, 9:39am Emergency Flash, 9:49am 3-color. APS
not installed yet.

Staff
Ken Kwong (TE), Manito Velasco (TE), Glenn Wilson (CP&C),
Phong Nguyen (Signal Shop), Dennis Verhalen (Signal Shop),
Cameron Peters (Phoenix), Wilson Lew (Phoenix), Christian
Ponio (Walsh)

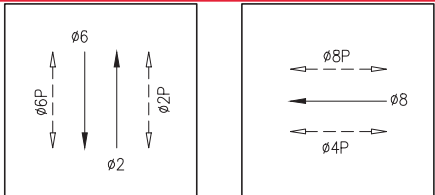

PHASE DIAGRAM

FOR ORIGINAL SIGNATURES, SEE ET-114.0, REV 0

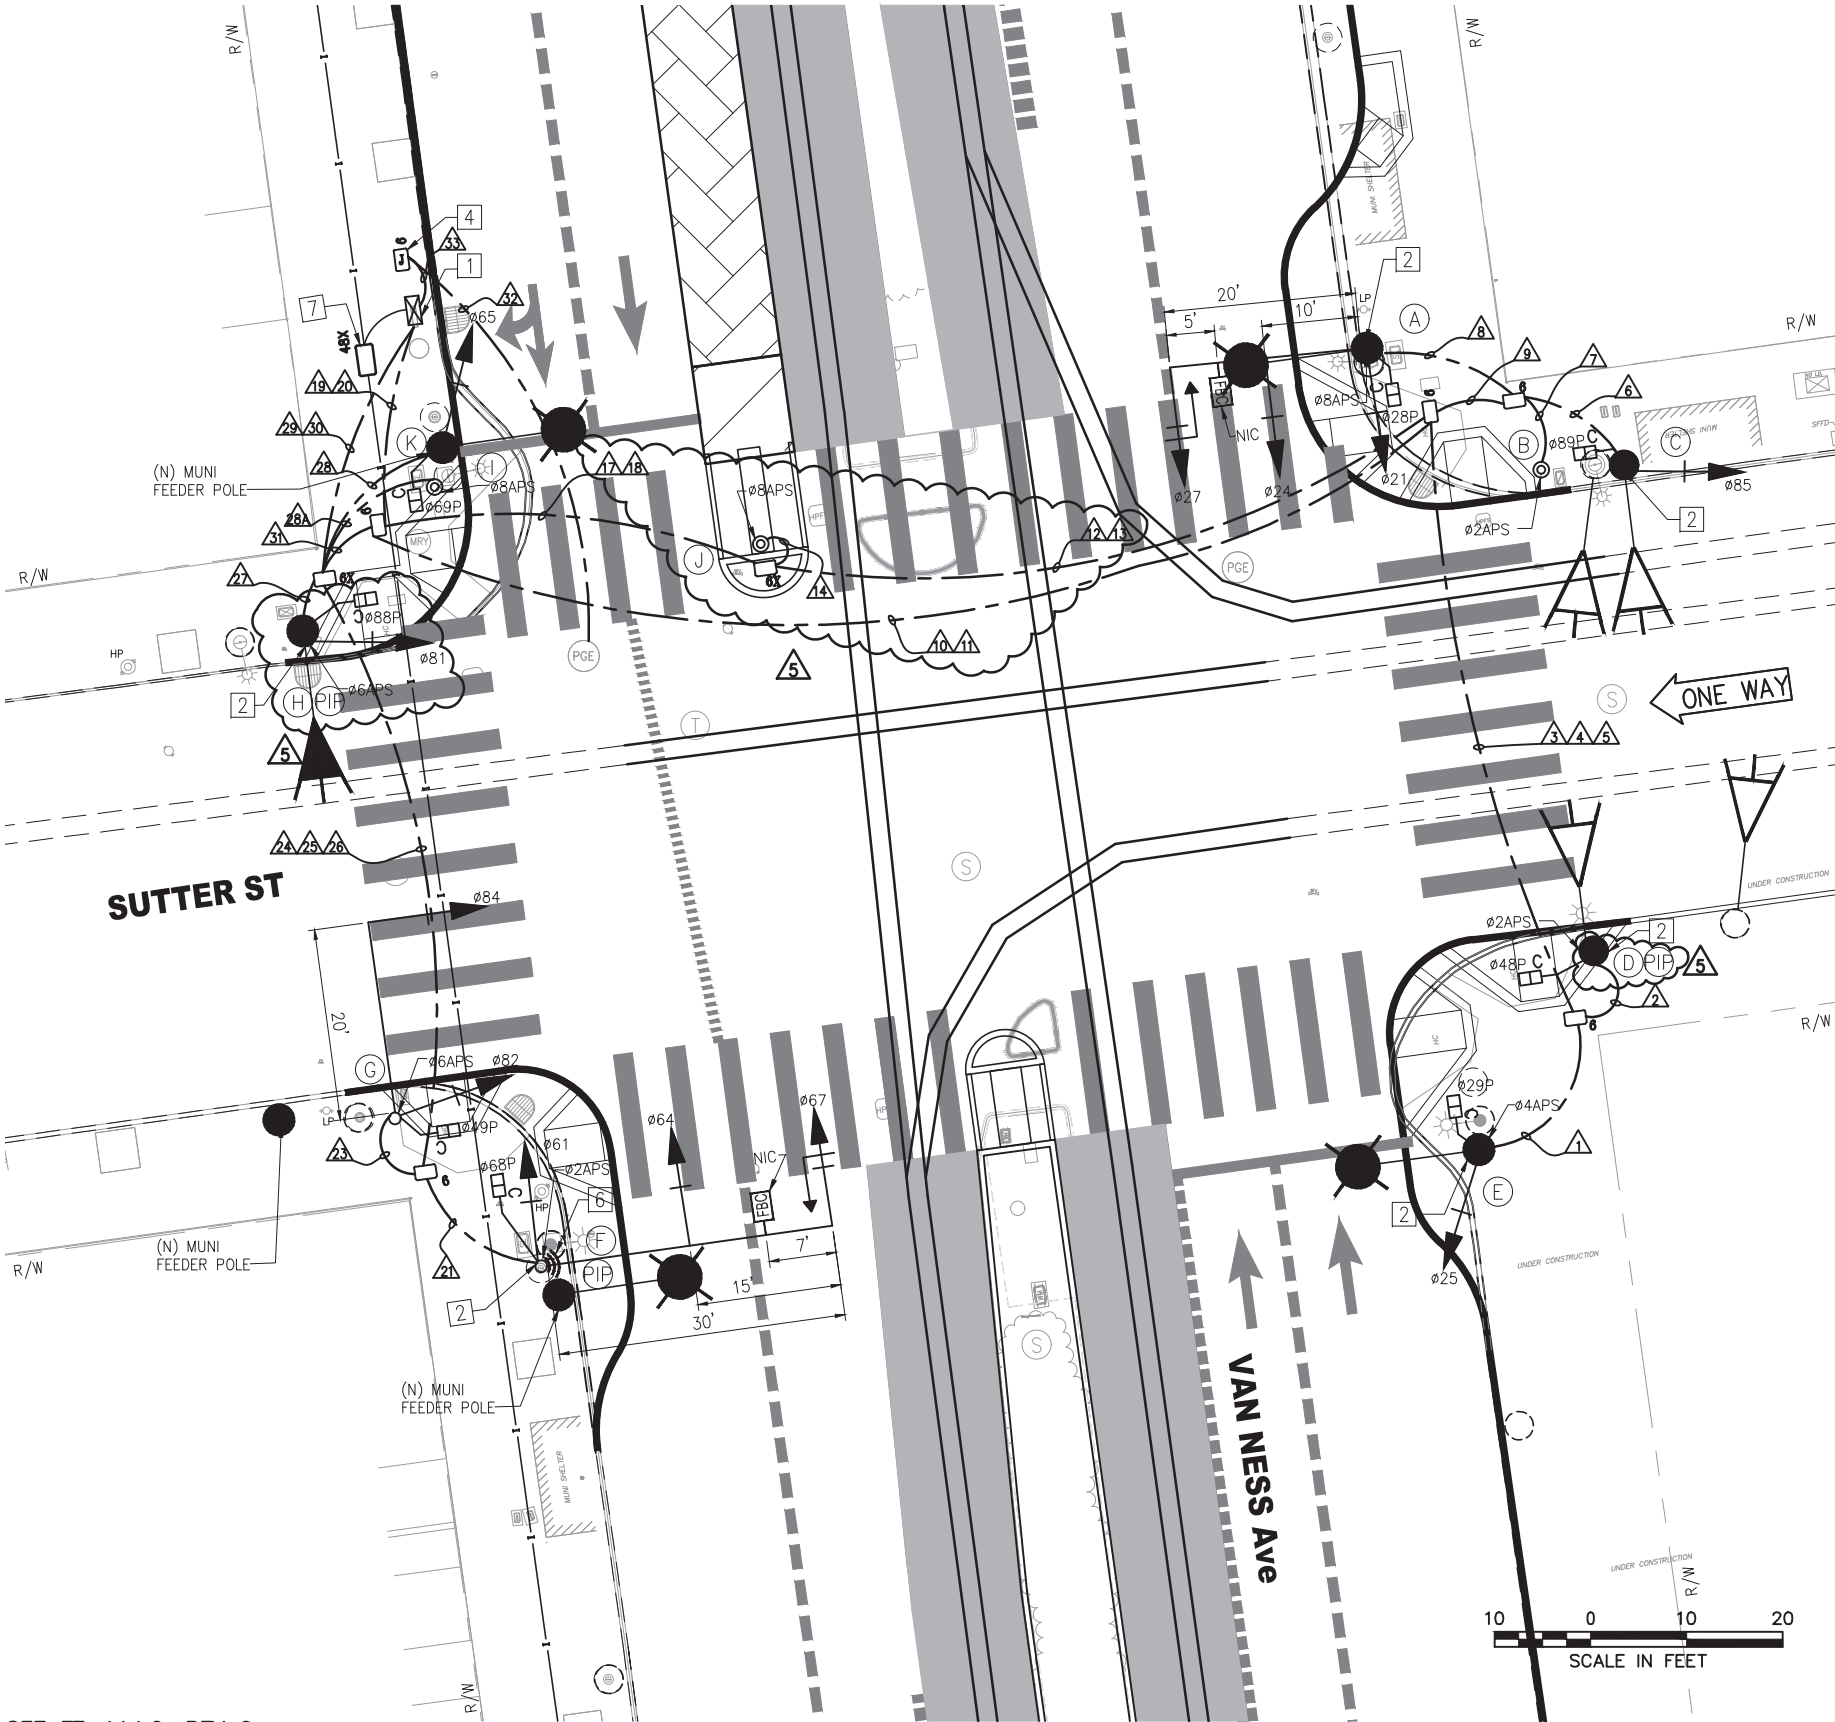

5	11/10/20	CONFORMED SET: UPDATED W/ RFI #932, FM#342 & 348	KK	MV	CL
4	7/18/19	LATEST DRAWING	KK	MV	CL
3	12/11/18	RFI #559: POLE H IS A STAND-ALONE TYPE 1-A POLE.	KK	MV	CL
2	NOT USED	PIP POLE F PER POLE LAYOUT			
1	03/2018	ADDED FBC SIGNS ON POLES A AND F; MOVED APS TO POLE F, ADDED TYPE 6X PULLBOXES	KK	MV	CL
NO.	DATE	DESCRIPTION	REVISED	CHECKED	APPROVED
REVISIONS					

DESIGNED	K. KWONG
DRAWN	K. KWONG
CHECKED	R. ZAMORA/G. LIU
REVIEWED	C. LIU
RECOMMENDED	P. WILSON
APPROVED	R. OLEA
DATE	12/4/2015



CITY AND COUNTY OF SAN FRANCISCO
MUNICIPAL TRANSPORTATION AGENCY

APPROVED

for the DIRECTOR OF TRANSPORTATION

MUNI BUS RAPID TRANSIT SYSTEM
VAN NESS CORRIDOR TRANSIT IMPROVEMENT PROJECT

SUTTER STREET
TRAFFIC SIGNAL WORK

1289

ET-114.0

ET-204

REVISION

5

F:\T.E. FILES\Spgo\Projects\Van Ness BR\Signal Design\CADD\ CPTB401ETBS - 100% Rev. 3-3-21.dwg KKWONG Tue Mar 09,2021 - 12:15 pm

POLE AND EQUIPMENT SCHEDULE													
POLE NO.	POLE STANDARD			VEHICLE SIGNAL					PEDESTRIAN SIGNAL			HPS LUMINAIRE (WATTS)	SPECIAL REQUIREMENTS
	TYPE	SIG. MA (FEET)	OCS SL	No.	TYPE	MOUNTING	VISORS	LOUVERS	No.	TYPE	MOUNTING		
(A)	SIGNAL, SL & OCS COMBO POLE	20	1304 132	21 24 27	3S12" 3S12" 3S12"GUA	SV-1-T MAS MAS	T T T		28	1S-COUNT	SP-1	-	STRAIGHT HORIZONTAL SIGNAL MA MOUNT AT 21' HIGH SEE ST PLANS FOR POLE DETAILS APS ④ TENON FOR FUTURE FBC MIDWAY BETWEEN MAS SIGNALS
(B)	PPBP POLE	-		-	-	-	-		-	-	-	-	APS ④
(C)	SIGNAL, SL & OCS COMBO POLE	-	1288	85	3S12"	SV-1-T	T		89	1S-COUNT	SP-1	-	
(D)	SIGNAL, SL & OCS COMBO POLE	-		-	-	-	-		48	1S-COUNT	SP-1	-	APS ④ PIP - INSTALL NEW POLE IN PLACE OF EXISTING POLE
(E)	SIGNAL, SL & OCS COMBO POLE	-	1242 128	25	3S12"	SV-1-T	T		29	1S-COUNT	SP-1	-	APS ④
(F)	SPECIAL MAST ARM POLE (18-4-100)	30		61 64 67	3S12" 3S12" 3S12"GUA	SV-1-T MAS MAS	T T T		68	1S-COUNT	SP-1	-	STRAIGHT HORIZONTAL SIGNAL MA MOUNT AT 21' HIGH APS ④ ② TSP ② ⑤ TENON FOR FUTURE FBC MIDWAY BETWEEN MAS SIGNALS PIP - INSTALL NEW POLE IN PLACE OF EXISTING POLE
(G)	16-2-100	20		82 84	3S12" 3S12"	SV-1-T MAS	T T		49	1S-COUNT	SP-1	-	SIGNAL 82 MOUNT AT 13' HIGH APS ④
(H)	SIGNAL, SL & OCS COMBO POLE	-	1300A	81	3S12"	SV-1-T	T		88	1S-COUNT	SP-1	-	PIP - INSTALL NEW POLE IN PLACE OF EXISTING POLE MOUNT SIGNAL 81 AT 13' HIGH APS ④
(I)	SIGNAL, SL & OCS COMBO POLE (FEEDER)	-	1301B 131	65	3S12"	SV-1-T	T		69	1S-COUNT	SP-1-T	-	EXTERNAL CONDUIT
(J)	PPBP POLE	-		-	-	-	-		-	-	-	-	APS ④
(K)	PPBP POLE	-		-	-	-	-		-	-	-	-	APS ④

MOUNT SIGNAL 27 BETWEEN YELLOW AND GREEN ⑤

⑤

MOUNT SIGNAL 67 BETWEEN YELLOW AND GREEN ⑤

*OTHER REQUIREMENTS ARE COVERED BY NOTES, LEGEND, SPECIAL PROVISIONS, AND STANDARD SPECIFICATIONS.
FOR TYPE OF STANDARD, VEHICLE AND PEDESTRIAN SIGNAL MOUNTING, SEE CALTRANS STANDARD PLANS OR DETAIL DRAWINGS.

- ④ INSTALL APS WIRING AS SHOWN IN CONDUIT AND WIRING SCHEDULE. CITY FORCES TO INSTALL CITY FURNISHED APS UNIT.
② INSTALL CITY FURNISHED TSP WIRING FROM TS OR COMBINED POLES WITH 3 FEET OF SLACK TO TS CABINET.
③ INSTALL CITY FURNISHED TRAFFIC CAMERA AND CONTRACTOR FURNISHED WIRING.
④ FOR STREETLIGHT WORK, SEE SL-SERIES PLANS.

CONFORMED SET AND UPDATED WITH RFI#908, #998 &

FOR ORIGINAL SIGNATURES, SEE ET-114.1, REV 0

5	11/10/20	FM#342, #348	KK	MV	CL
4	7/18/19	LATEST DRAWING	KK	MV	CL
3	12/11/18	RFI #559: POLE H IS A STAND-ALONE TYPE 1-A POLE. PIP POLE F PER POLE LAYOUT	KK	MV	CL
2	NOT USED	NOT USED			
1	03/2018	UPDATED POLE STANDARD AND SPECIAL REQUIREMENT; UPDATED POLES A & F, AND RELOCATED APS ON POLE F: ADDED FBC TENON NOTE	KK	MV	CL
NO.	DATE	DESCRIPTION	REVISED	CHECKED	APPROVED
REVISIONS					

DESIGNED	K. KWONG
DRAWN	K. KWONG
CHECKED	R. ZAMORA/C. LUU
REVIEWED	C. LUU
RECOMMENDED	P. WILSON
APPROVED	R. OLEA
DATE	12/4/2015



CITY AND COUNTY OF SAN FRANCISCO
MUNICIPAL TRANSPORTATION AGENCY

APPROVED

for the DIRECTOR OF TRANSPORTATION

MUNI BUS RAPID TRANSIT SYSTEM
VAN NESS CORRIDOR TRANSIT IMPROVEMENT PROJECT

SUTTER STREET
CONDUCTOR POLE AND EQUIPMENT SCHEDULES

1289

ET-114.1

ET-204

REVISION

5

3

3

for the DIRECTOR OF TRANSPORTATION

3