


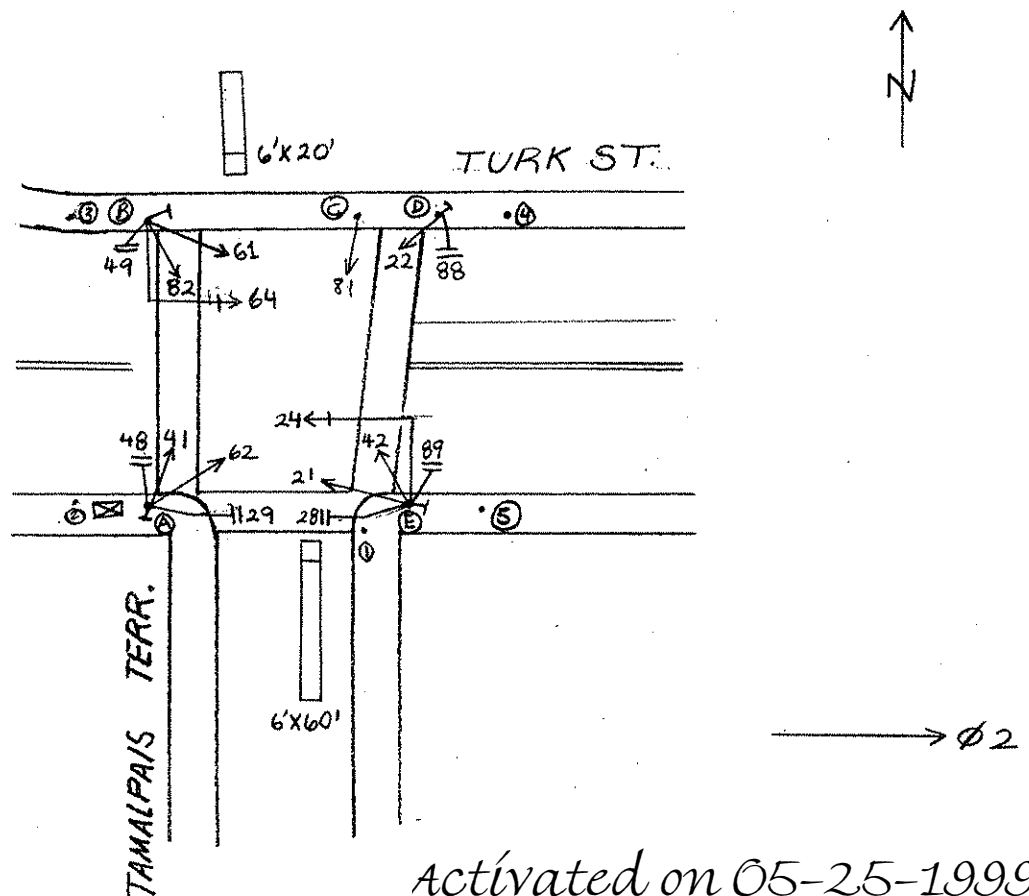

Activated on 05-25-1999

Field Check 12-22-99

POLE	FUNC.	MAT'L	SIGNAL NO.	MAKE	NO. OF SECT.	SIZE	VISOR	B.P. OR LOUVERS	MOUN'T	PED SIGNAL NO.	LEGEND	MESSAGE		MAKE	MOUN'T
												ELEMENT	COLOR		
A	S	S	62	TCT	3	8"	T 8"	NO	T	29	I	1 S-I	WH/OR	ICC	S
B	S	S	41	TCT	1	12"	T 12"	NO	T	48	I	1 S-I	WH/OR	ICC	S
C	S	S	82	TCT	3	8"	T 8"	NO	S	49	I	1 S-I	WH/OR	ICC	S
D	S	S	64	TCT	3	12"	T 8"	BP	MAS	88	I	1 S-I	WH/OR	ICC	S
E	S	S	61	TCT	3	8"	T 8"	NO	S	89	I	1 S-I	WH/OR	ICC	S
			81	TCT	3	8"	T 8"	NO	T	28	I	1 S-I	WH/OR	ICC	S
			22	TCT	3	8"	T 8"	NO	T						
1	*	S	42	TCT	1	12"	T 12"	NO	S						
2	M/L	S	24	TCT	3	12"	T 8"	BP	MAS						
3	M	S	21	TCT	3	8"	T 8"	NO	S						
4	M	S													
5	M/L	S													

CONTROLLER CABINET SIZE : Ordinary BASE CABINET: Yes

COMMENTS: New Signal per Contract 51

* Fire Alarm