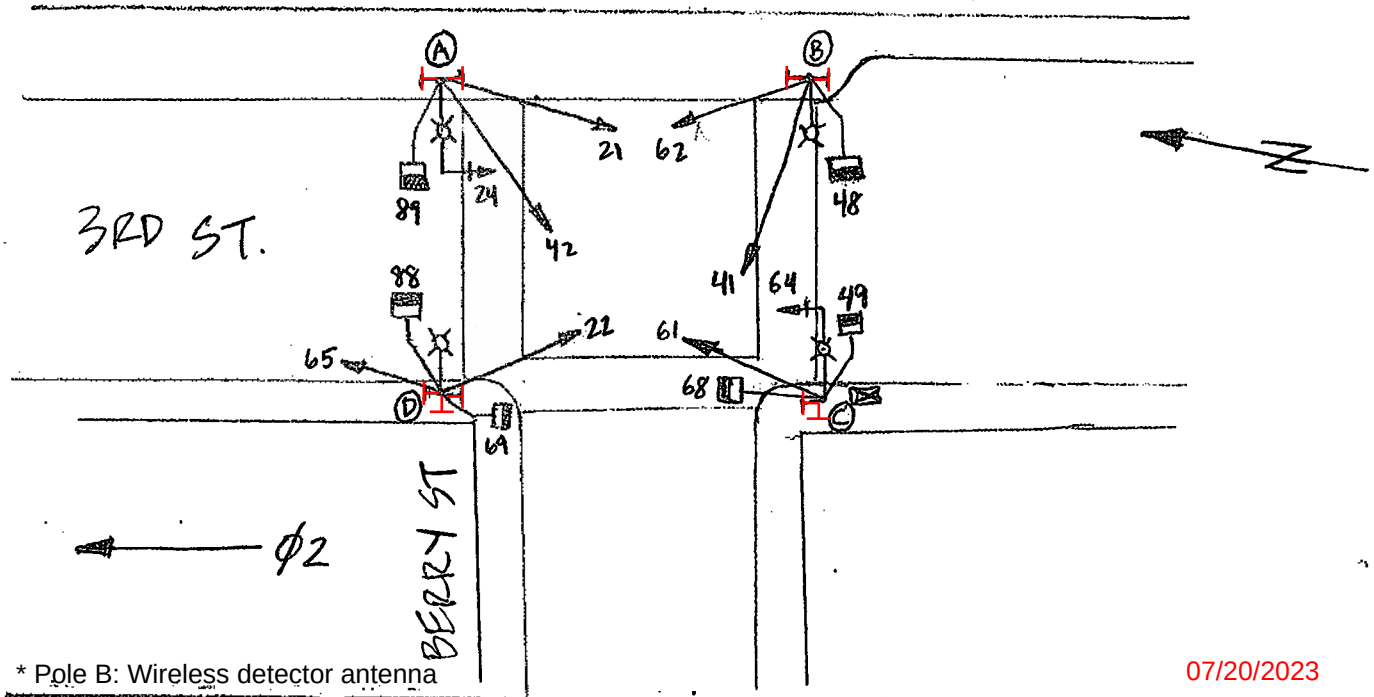

* Pole B: Wireless detector antenna

07/20/2023

POLE	FUNC	MATL	SIGNAL NO	MAKE	NO. OF SECT.	SIZE	VISOR	BP OR LOUVER	MOUNTING	PED SIGNAL NO.	LEGEND	ELEMENT	COLOR	MAKE	MOUNTING
A	L	S	24	TCT	3	12"	T	BP	MAS	88		1S	COUNT		S
B*	L	S	42	TCT	3	12"	T	—	S	89		1S	COUNT		S
C	L	S	21	TCT	3	12"	T	—	S	48		1S	COUNT		S
D	L	S	62	TCT	3	12"	T	—	S	69		1S	COUNT		S
			41	TCT	3	12"	T	—	S	48		1S	COUNT		S
			64	TCT	3	12"	T	BP	MAS	49		1S	COUNT		S
			61	TCT	3	12"	T	—	S						
			22	TCT	3	12"	T	—	S						
			65	TCT	3	12"	T	—	S						

INSTALL APS (SRC 2023-028) E.LUU
PER FIELD: REMOVED LOOP DETECTORS FOR EB BERRY