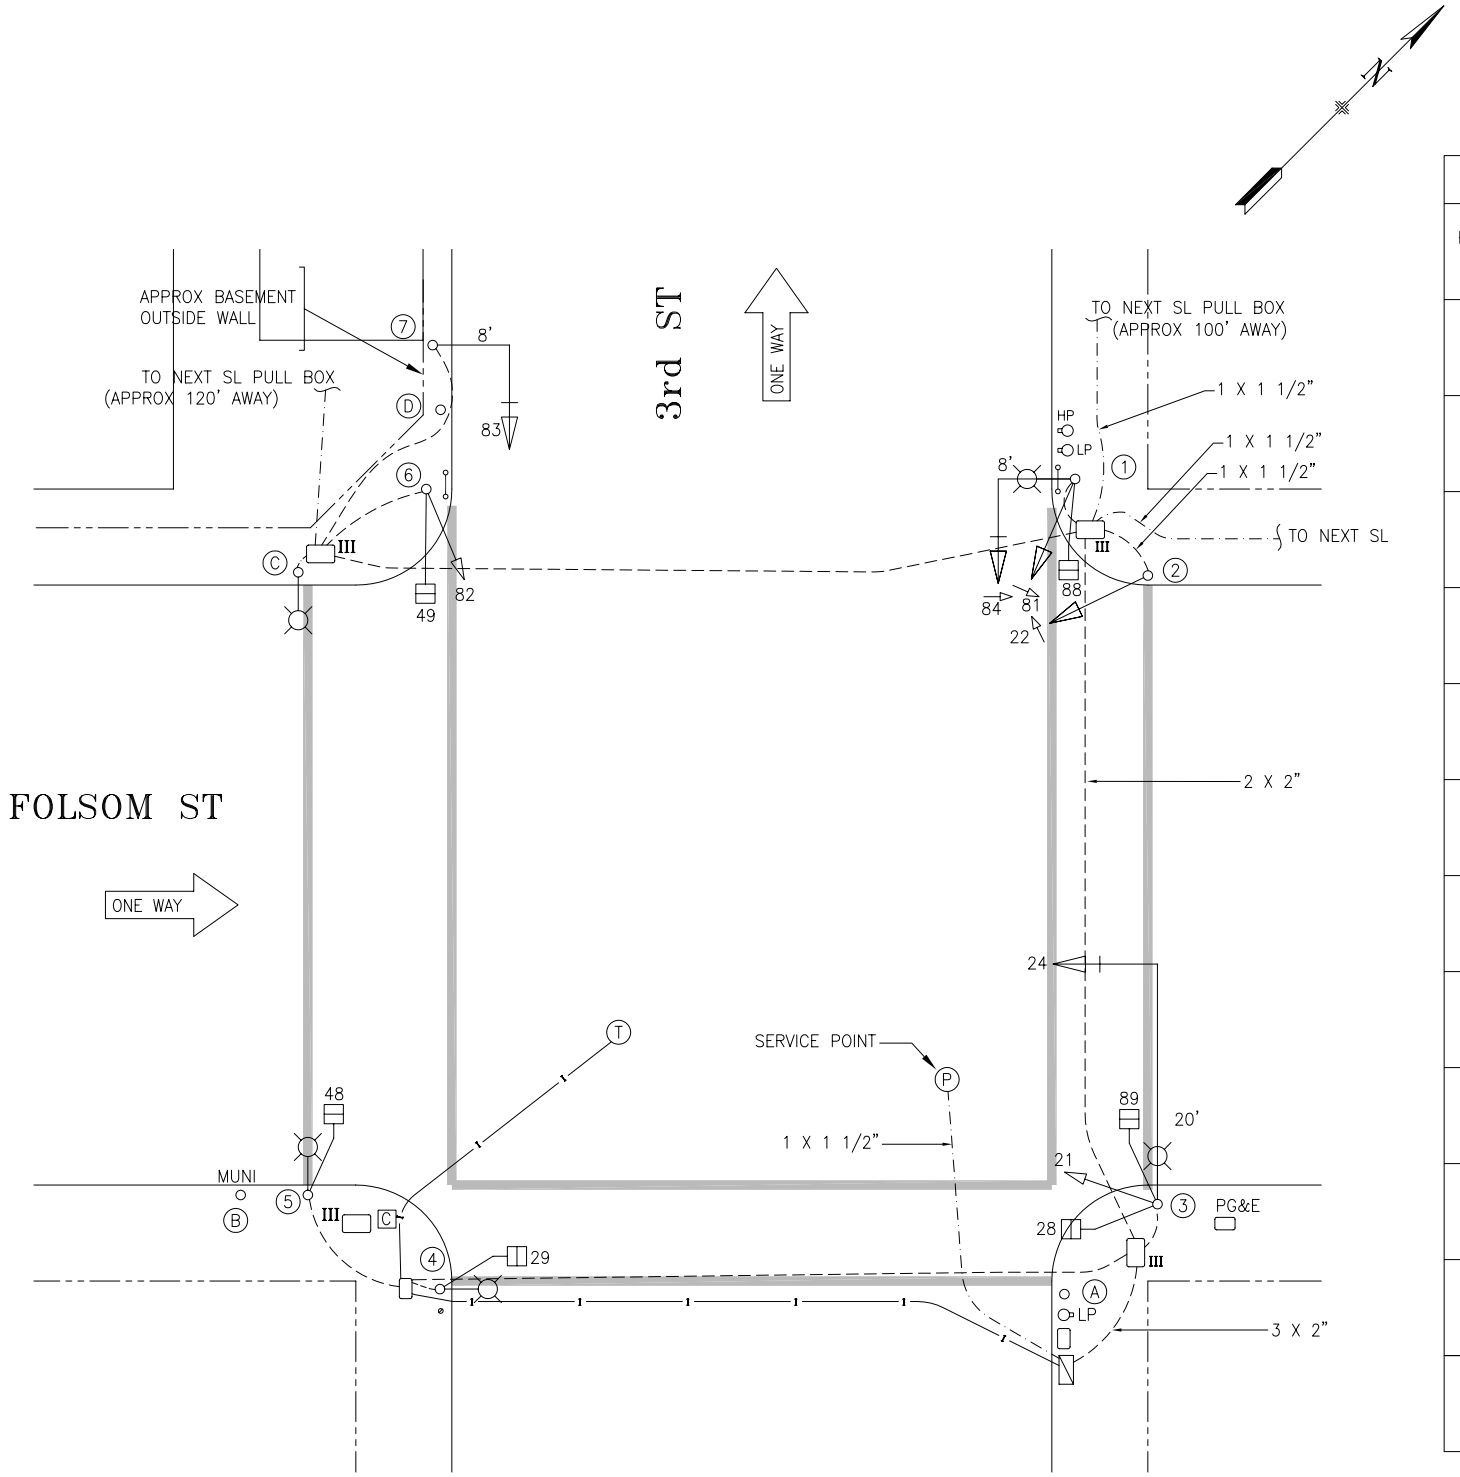

POLE AND EQUIPMENT SCHEDULE

POLE No.	TYPE OF POLE	VEHICLE SIGNAL					PEDESTRIAN SIGNAL			REMARKS
		No.	TYPE	MOUNTING	VISORS	LOUVERS	No.	TYPE	MOUNTING	
1	17B-1-70 WITH 8' MAST AND 6' LUMINAIRE ARMS	84 81	4S12"GRA 4S12"GRA	MAS SV-1-T	T T		88	1S-IN	SP-1	BACKPLATE
2	EX MUNI POLE	22	4S12"GLA	SV-1-T	T					
3	17B-1-70 WITH 20' MAST AND 6' LUMINAIRE ARMS	21 24	3S8" 3S12"	SV-1-T MAS	T T		89 28	1S-IN 1S-IN	SP-1 SP-1	
4	EX SL (MUNI)						29	1S-IN	SP-1	
5	EX. SL						48	1S-IN	SP-1	
6	1-A (10')	82	3S8"	TV-1	T		49	1S-IN	SP-1	
7	16-1-70 WITH 8' MAST ARM	83	3S12"	MAS	T					BACKPLATE
A	MUNI									
B	MUNI									
C	SL									
D	MUNI									

NOTE:

CABINET FOUNDATION TYPE: STD

10' 0 10' 20'

NO.	DATE	DESCRIPTION	BY	APP.
1	02/99	FOLSOM STREET SIGNAL IMPROVEMENT CT#1302N	DVC	RO

TABLE OF REVISIONS
CHECK WITH TRACING TO SEE IF YOU HAVE LATEST REVISION

COMPLETION DATE / ELECTRICIAN INITIAL

DEPARTMENT OF PARKING AND TRAFFIC
DIVISION OF TRAFFIC ENGINEERING
CITY AND COUNTY OF SAN FRANCISCO

DRAWN: DVC DATE: 5/1/01
CHECKED: DATE:
SCALE: 1" = 20'
SHEET OF SHEETS 1 OF 1

TRAFFIC SIGNAL INVENTORY DIAGRAM

3RD ST AND FOLSOM ST

CNN NO. 24583000
REV. NO.

EXTERNAL REFERENCES: T:\T_E_Files\Special Projects & Street Use\SID\Archived\Tb34x22.dwg
FONTS USED: ariain.ttf ARIBLK.TTF ROMAND.shx ROMANS.shx ROMANS.SHX ROMANT ROMANT.SHX txt
SCALE FACTOR: 120
PLOT SCALE: 1=1
ORIGIN: SALES & TAX
FILE NAME: 03ST_Folsom.dwg
DATE: Sep 05 2001 17:15