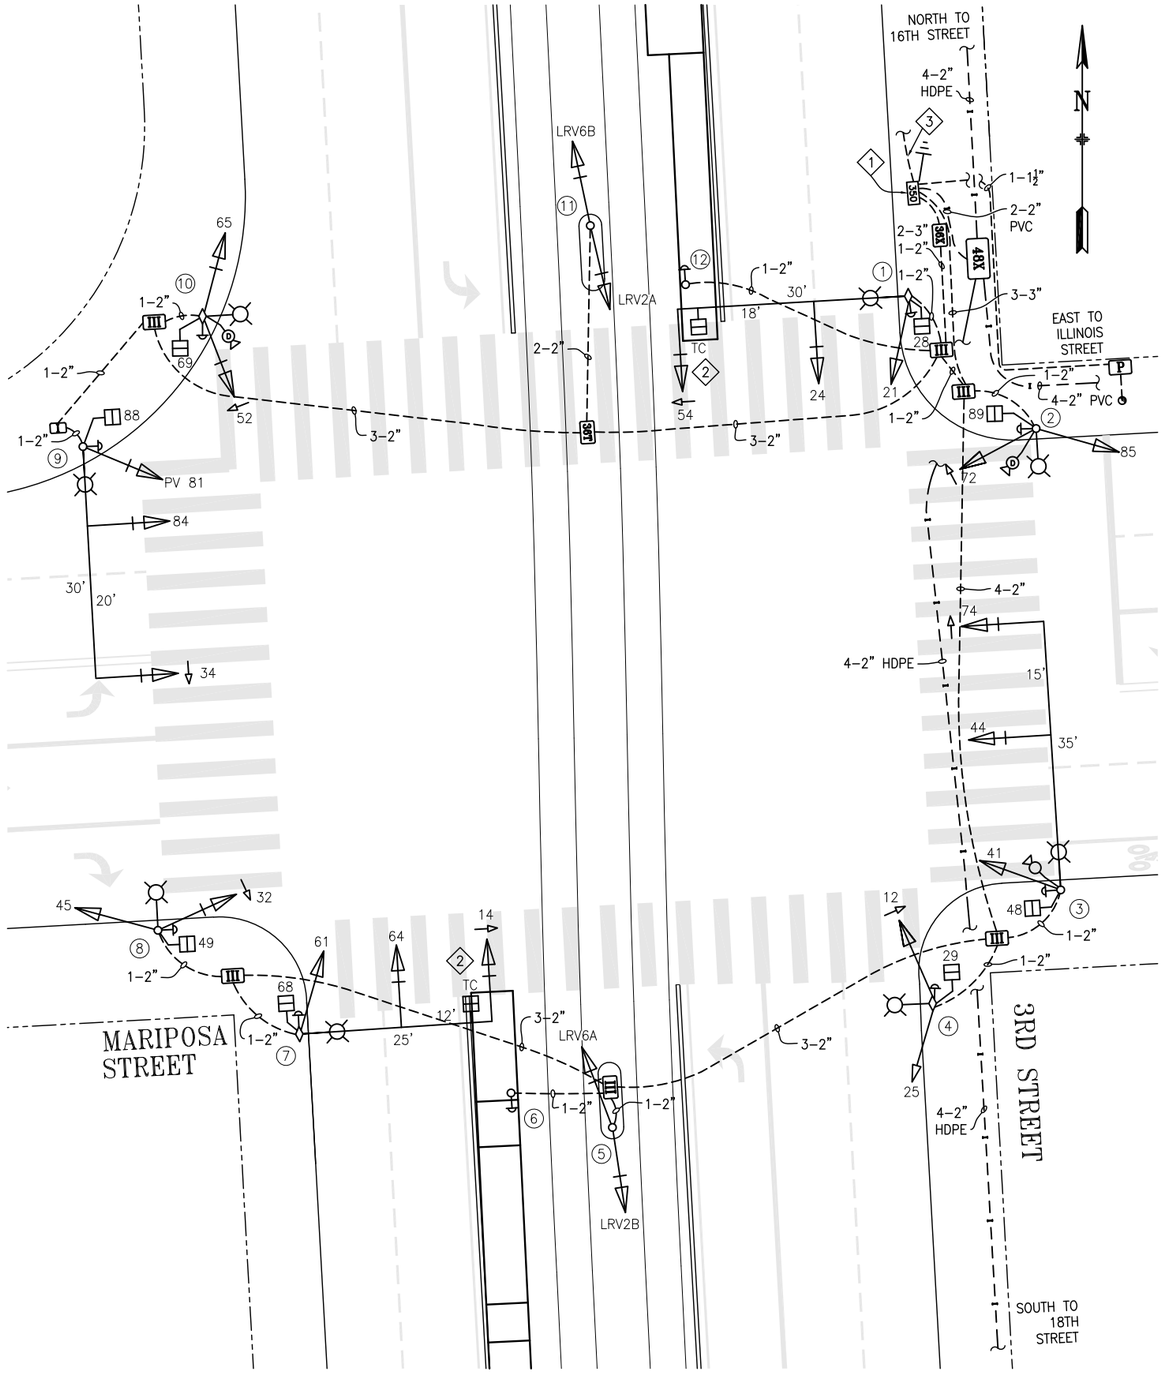


## POLE AND EQUIPMENT SCHEDULE

| POLE No. | TYPE OF POLE | LUMINAIRE TYPE | VEHICLE SIGNAL | | | | | PEDESTRIAN SIGNAL | | | REMARKS |
|---|---|---|---|---|---|---|---|---|---|---|---|
| | | | No. | TYPE | MOUNTING | VISORS | LOUVERS/BP | No. | TYPE | MOUNTING | |
| 1 | MUNI COMBO POLE W/30' MAST ARM | | 21<br>24<br>54<br>TC | 3S12"<br>3S12"<br>3S12"LA<br>1S 24"X24" | SV-1-T<br>MAS<br>MAS<br>MAC | T<br>T<br>T<br>T | BP<br>BP | 28 | 1S-COUNT | SP-1 | APS ◇5 |
| 2 | STREET LIGHT POLE | | 72<br>85 | 3S12"LA<br>3S12" | SV-2-T | T<br>T | | 89 | 1S-COUNT | SP-1 | APS<br>DETECTION CAMERA (FISHEYE) |
| 3 | MSSION BAY POLE W/35' MAST ARM | | 41<br>44<br>74 | 3S12"<br>3S12"<br>3S12"LA | SV-1-T<br>MAS<br>MAS | T<br>T<br>T | BP<br>BP | 48 | 1S-COUNT | SP-1 | APS<br>CCTV CAMERA |
| 4 | MUNI COMBO POLE | | 12<br>25 | 3S12"LA<br>3S8" | SV-2-T | T<br>T | | 29 | 1S-COUNT | SP-1 | APS |
| 5 | 1-A (12') | | LRV2B<br>LRV6A | 2S12"LB<br>2S12"LB | TV-2-T | T<br>T | BP<br>BP | | | | |
| 6 | PPB POLE | | | | | | | | | | APS W/SIGN ( ⟶ ) |
| 7 | MUNI COMBO POLE W/25' MAST ARM | | 14<br>61<br>64<br>TC | 3S12"LA<br>3S12"<br>3S12"<br>1S 24"X24" | MAS<br>SV-1-T<br>MAS<br>MAC | T<br>T<br>T<br>T | BP<br>BP | 68 | 1S-COUNT | SP-1 | APS ◇4 |
| 8 | STREET LIGHT POLE | | 32<br>45 | 3S12"LA<br>3S12" | SV-2-T | T<br>T | | 49 | 1S-COUNT | SP-1 | APS |
| 9 | MSSION BAY POLE W/30' MAST ARM | | 34<br>PV 81<br>84 | 3S12"LA<br>3S12"PV<br>3S12" | MAS<br>SV-1-T<br>MAS | T<br>T<br>T | BP<br>BP<br>BP | 88 | 1S-COUNT | SP-1 | APS |
| 10 | MUNI COMBO POLE | | 52<br>65 | 3S12"LA<br>3S12" | SV-2-T | T<br>T | BP<br>BP | 69 | 1S-COUNT | SP-1 | APS<br>DETECTION CAMERA (FISHEYE) |
| 11 | 1-A (12') | | LRV2A<br>LRV6B | 2S12"LB<br>2S12"LB | TV-2-T | T<br>T | BP<br>BP | | | | |
| 12 | PPB POLE | | | | | | | | | | APS W/SIGN ( ⟶ ) |

## SHEET NOTES:

1. CABINET FOUNDATION TYPE: 350i-ATC
2. TC = TRAIN COMING
3. TO VTS LOOPS – SEE CONTRACT MR-1147, SHEET EL-18 FOR FURTHER DETAILS
4. SEE DETAIL 'E', CONTRACT MR-1141, DRAWING T-11 FOR MAST ARM DETAILS
5. SEE DETAIL 'H', CONTRACT MR-1141, DRAWING T-11 FOR MAST ARM DETAILS

| NO. | DATE | DESCRIPTION | BY | APPROVED |
|---|---|---|---|---|
| 5 | 5/12/22 | SRC 2021-171: INSTALLED 24"X24" FTCs ON POLES 1 AND 7 & PER FIELD CHECK | T. YOUNG | C. LIU |
| 4 | 8/3/19 | SRC 2019-253: INSTALLED 350i-ATC CABINET, POLES 2 & 3, SIGNALS 32,34,41,44,72,74,85 | S. WONG | B. DUSSEAULT |
| 3 | 4/11/15 | SRC 2015-084: RELOCATED POLE 11 NORTHERLY & INSTALLED SIGNALS ON NEW POLES 9 & 10 | C. HUI | B. DUSSEAULT |
| 2 | 5/25/14 | SRC 2014-100: INSTALL LUNAR BARS, DELETE SIGNALS 13 AND 53 | B. WOO | C. WONG |
| 1 | 7/20/04 | TRAFFIC SIGNAL UPGRADE FOR THIRD STREET LIGHT RAIL CT#MR-1141 | D. YEUNG | A. HERCE |

TABLE OF REVISIONS
CHECKOUT DRAWING THROUGH THE SID CUSTODIAN FOR THE LATEST REVISION

SFMTA

DRAWN BY: T. YOUNG DATE: 6/2022
CHECKED BY: C. LIU DATE: 6/2022

SCALE: 1" = 10'
SHEET OF SHEETS: 1 OF 1

# TRAFFIC SIGNAL INVENTORY DIAGRAM

## 3RD STREET & MARIPOSA STREET

CNN NO: 23572000
REV NO: 5