BALBOA & 6TH

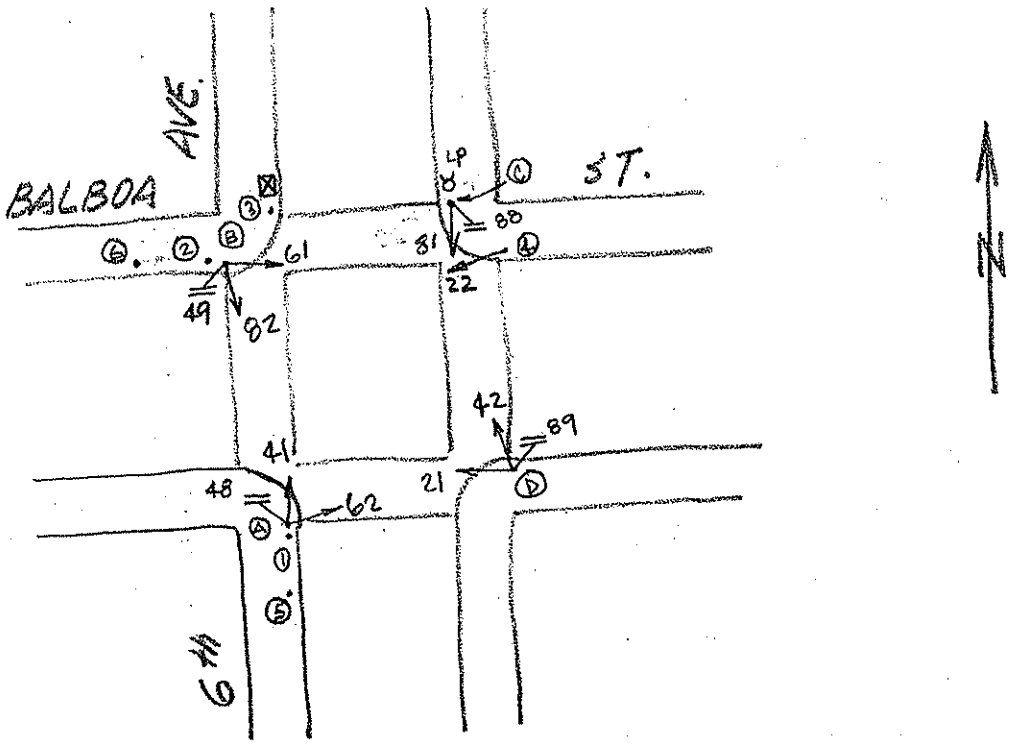

Φ2 →

7-16-94

POLE	FUNC.	MAT'L
A	S	C
B	S	C
C	M	S
D	S	S
1	U	W
2	U	W
3	U	W
4	U	W
5	M	S
6	M	S

SIGNAL NO.	MAKE	NO. OF SECT.	SIZE	VISOR	B.P. OR LOUVERS	MOUN'T
41	EC	3	8"	FC 8"	NO	T
62	EC	3	8"	FC 8"	NO	T
82	EC	3	8"	FC 8"	NO	T
61	EC	3	8"	FC 8"	NO	T
22	TCT	3	8"	FC 8"	NO	S
81	TCT	3	8"	FC 8"	NO	S
42	EC	3	8"	FC 8"	NO	T
21	EC	3	8"	FC 8"	NO	T

PED SIGNAL NO.	LEGEND	MESSAGE ELEMENT	MESSAGE COLOR	MAKE	MOUN'T
48	I	15-1	W/OR	ICC	S
49	I	15-1	W/OR	ICC	S
88	I	15-1	W/OR	ICC	S
89	I	15-1	W/OR	ICC	S

CONTROLLER CABINET SIZE : ORDINARY BASE CABINET: YES

COMMENTS: Replaced with ICC Ped Signals

NEW MUNI POLE C AND NEW SIGNALS 81, 88, 22 WERE INSTALLED UNDER MR 881 CONTRACT #31 BALBOA LINE.