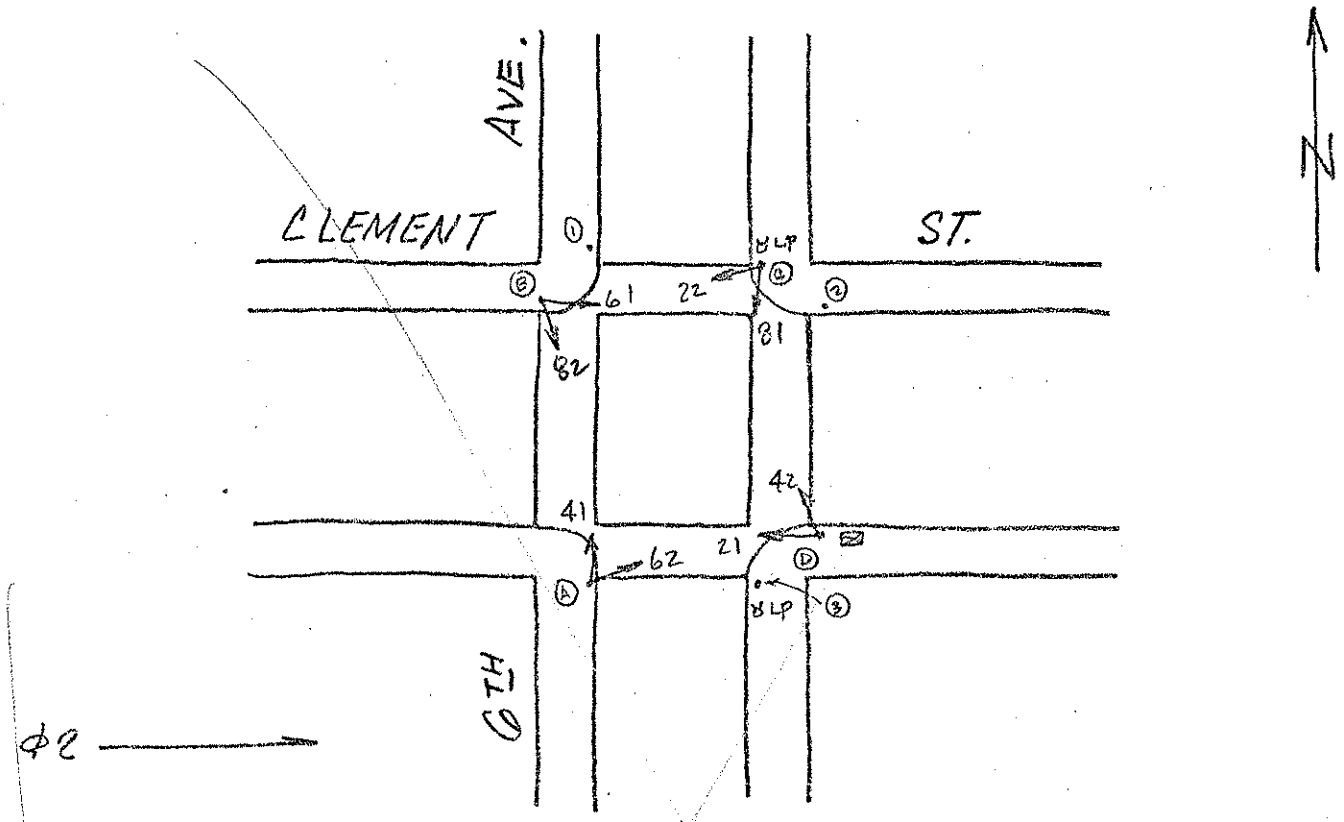

1-22-79

POLE	FUNC.	MAT'L
A	S	S
B	L	S
C	M	S
D	L	S
1	M	S
2	M	S
3	U	W

SIGNAL NO.	MAKE	NO. OF SECT.	SIZE	VISOR	B.P. OR LOUVERS	MOUN'T
62	EC	3	8"	FC 8"	NO	T
41	EC	3	8"	FC 8"	NO	T
82	EA	3	8"	FC 8"	NO	S
61	EA	3	8"	FC 8"	NO	S
22	EA	3	8"	FC 8"	NO	S
81	EA	3	8"	FC 8"	NO	S
42	EA	3	8"	FC 8"	NO	S
21	EA	3	8"	FC 8"	NO	S

PED SIGNAL NO.	LEGEND	MESSAGE ELEMENT	MESSAGE COLOR	MAKE	MOUN'T

CONTROLLER CABINET SIZE : ORDINARY BASE CABINET : YES

COMMENTS :