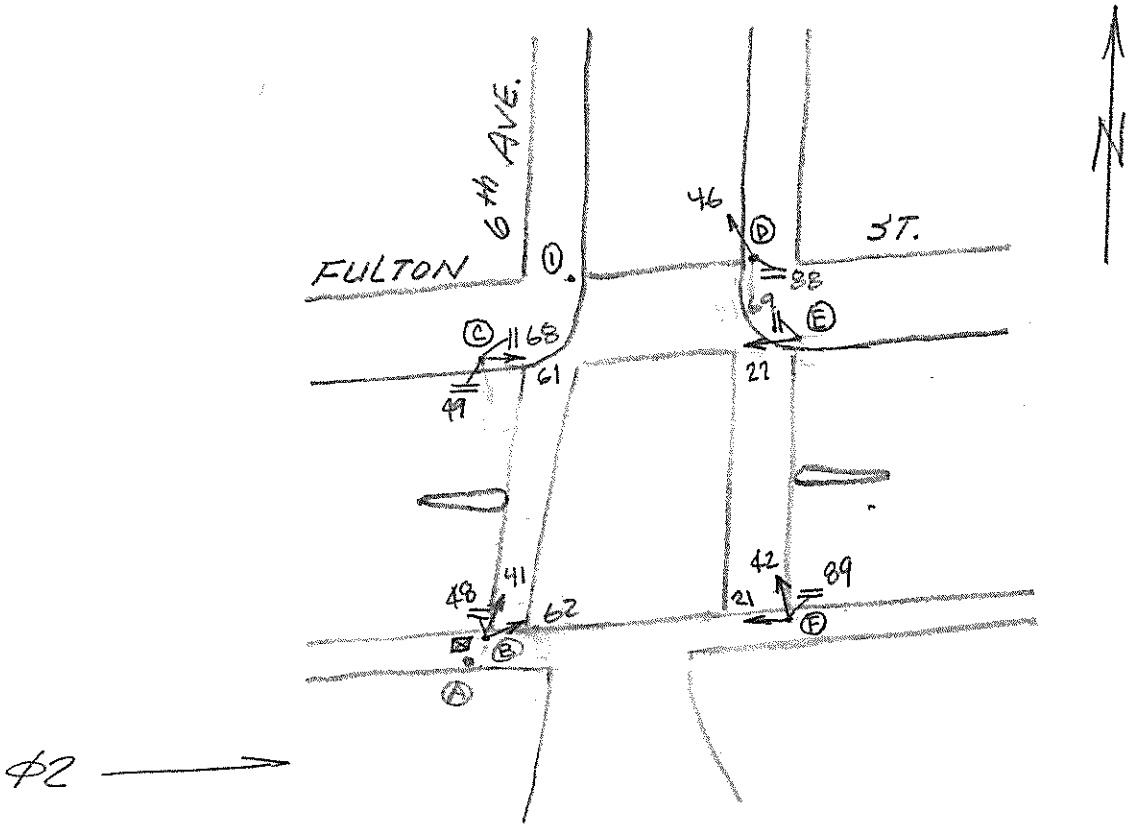

10-09-2013

POLE	FUNC.	MAT'L
A	M	S
B	S	S
C	S	S
D	M	S
E	M	S
F	M	S
1	U	W

SIGNAL NO.	MAKE	NO. OF SECT.	SIZE	VISOR	B.P. OR LOUVERS	MOUN'T
41	EC	3	12"	T 12"	No	T
62	EC	3	12"	FC 12"	No	T
61	EC	3	12"	T 12"	BP	T
46	EC	3	12"	FC 12"	No	S
22	EC	3	12"	T 12"	No	S
42	EC	3	12"	T 12"	No	T
21	EC	3	12"	T 12"	NO	T

PED SIGNAL NO.	LEGEND	MESSAGE ELEMENT	MESSAGE COLOR	MAKE	MOUN'T
48	W/DW	GRD	W/OR	ED	S
49	W/DW	GRD	W/OR	ED	S
88	W/DW	GRD	W/OR	ED	S
89	I	1S-1	W/OR	ICC	S
68	I	1S-1	W/OR		S
69	I	1S-1	W/OR		S

CONTROLLER CABINET SIZE: LARGE BASE CABINET: YES

COMMENTS: UPGRADED 21, 22, 42 TO 12" ADDED 68 & 69 PER SRC 2013-113