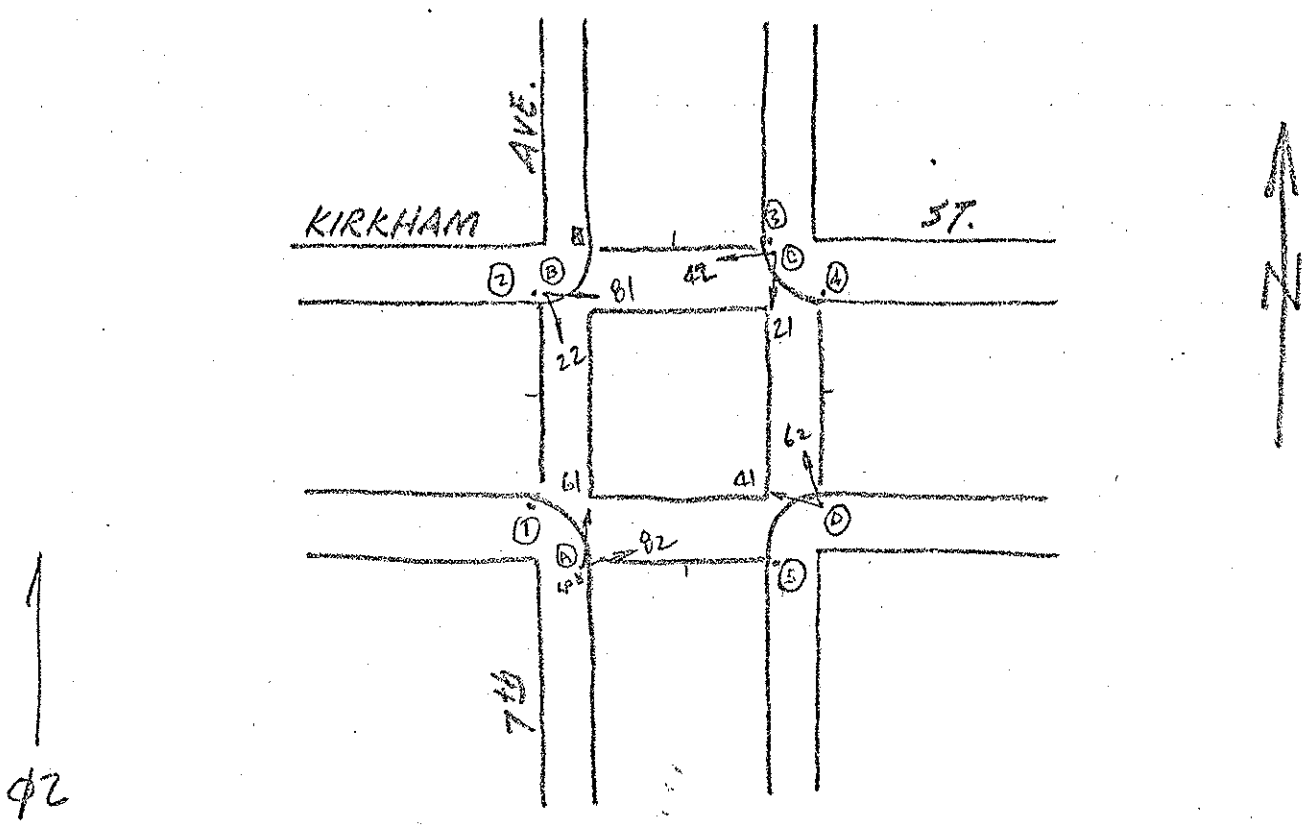

3-1-79

POLE	FUNC.	MAT'L	SIGNAL NO.	MAKE	NO. OF SECT.	SIZE	VISOR	B.P. OR LOUVERS	MOUN'T	PED SIGNAL NO.	LEGEND	MESSAGE ELEMENT	MESSAGE COLOR	MAKE	MOUN'T
A	S	C	82	EA	3	8"	FC 8"	NO	T						
B	S	C	61	EA	3	8"	FC 8"	NO	T						
C	S	C	22	EA	3	8"	FC 8"	NO	T						
D	S	C	81	EA	3	8"	FC 8"	NO	T						
			42	EA	3	8"	FC 8"	NO	T						
1	L	W	21	EA	3	8"	FC 8"	NO	T						
2	U	W	62	EA	3	8"	FC 8"	NO	T						
3	U	W	41	EA	3	8"	FC 8"	NO	T						
4	U	W													
5	U	W													

CONTROLLER CABINET SIZE : ORDINARY BASE CABINET: YES

COMMENTS :