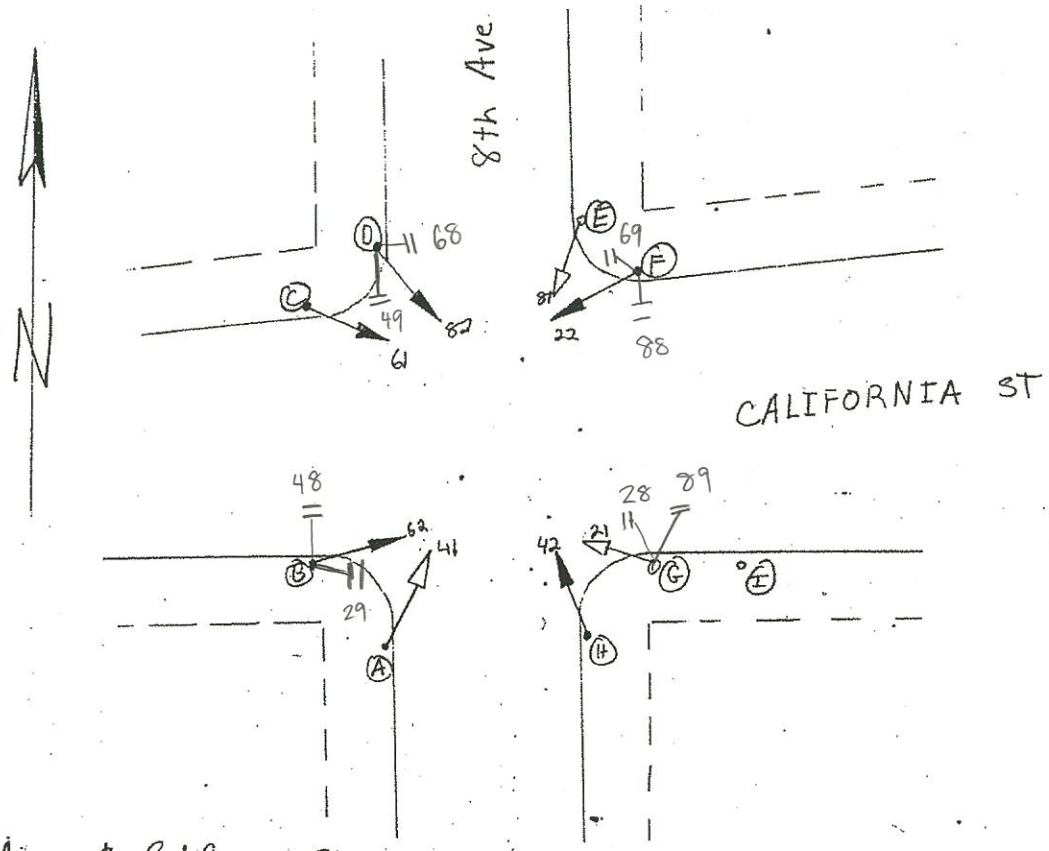


4/30/15
4/3/02
8/24-/01

8th Ave. & California St.

| POLE | FUNC. | MAT'L |
|---|---|---|
| A | M | W |
| B | M | S |
| C | L | S |
| D | L | S |
| E | S | S |
| F | L/M | S |
| G | S | C |
| H | L | S |
| I | M | S |

| SIGNAL NO. | MAKE | NO. OF SECT. | SIZE | VISOR | B.P. OR LOUVERS | MOUN'T |
|---|---|---|---|---|---|---|
| 41 | EC | 3 | 8" | FC | – | SV-1 |
| 62 | EC | 3 | 8" | T | – | SV-1 |
| 61 | EC | 3 | 8" | T | – | SV-1 |
| 82 | EC | 3 | 8" | T | – | SV-1 |
| 81 | EC | 3 | 8" | FC | – | SV-1 |
| 22 | EC | 3 | 8" | T | – | SV-1 |
| 21 | EC | 3 | 8" | FC | – | TV-1 |
| 42 | EC | 3 | 8" | T | – | SV-1 |

| PED SIGNAL NO. | LEGEND | MESSAGE ELEMENT | MESSAGE COLOR | MAKE | MOUN'T |
|---|---|---|---|---|---|
| 29/48 | I | LED | W/OR | | S |
| 49/68 | I | LED | W/OR | | S |
| 69/88 | I | LED | W/OR | | S |
| 28/89 | I | LED | W/OR | | S |

CONTROLLER CABINET SIZE : ordinary BASE CABINET: no

COMMENTS:

INSTALLED PEDESTRIAN SIGNALS FOR ALL CROSSINGS PER SRC # 2015-105 - 4/30/15 1010 activated