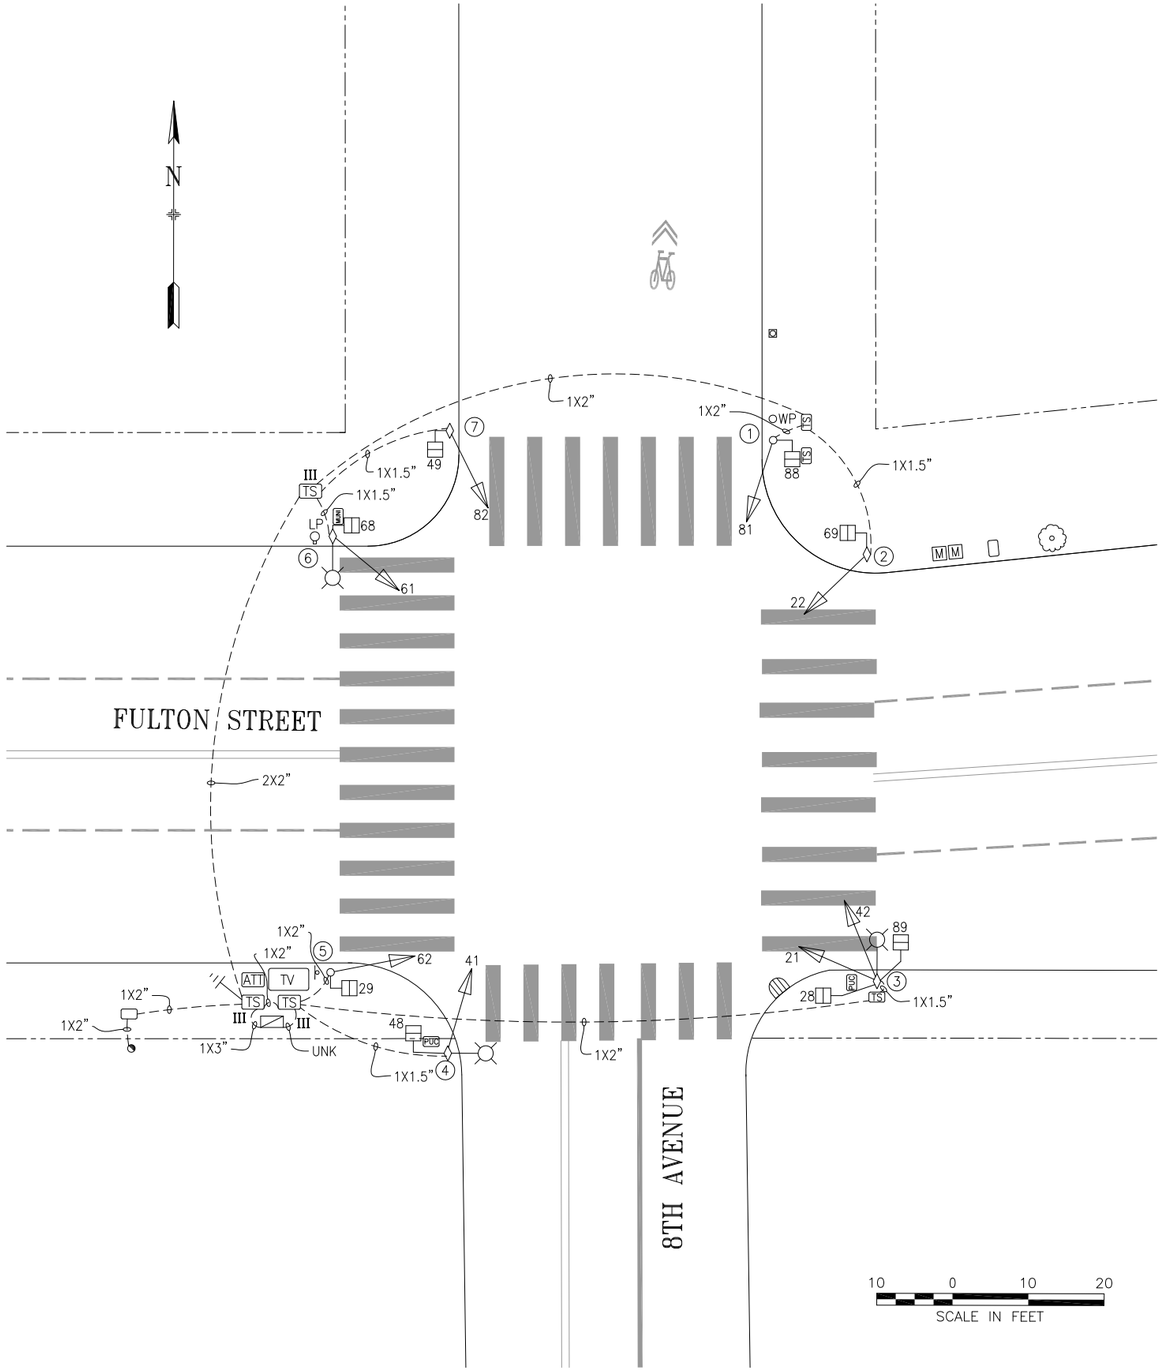

POLE AND EQUIPMENT SCHEDULE

POLE No.	TYPE OF POLE	LUMINAIRE VOLTAGE/ WATTAGE	VEHICLE SIGNAL					PEDESTRIAN SIGNAL			REMARKS
			No.	TYPE	MOUNTING	VISORS	LOUVERS	No.	TYPE	MOUNTING	
1	MARBLELITE PEDESTAL SIGNAL POLE (10')		81	3S12"	TV-1-T	T		88	1S-COUNT	SP-1	
2	MUNI POLE		22	3S12"	SV-1-T	T		69	1S-COUNT	SP-1-T	EXTERNAL CONDUIT
3	STREET LIGHT & MUNI POLE		42 21	3S12" 3S12"	SV-2-T-SF	T T		89 28	1S-COUNT 1S-COUNT	SP-2-T-SF	EXTERNAL CONDUIT
4	STREET LIGHT & MUNI POLE		41	3S12"	SV-1-T	T		48	1S-COUNT	SP-1	
5	1-A (10')		62	3S12"	TV-1-T	T		29	1S-COUNT	SP-1	
6	STREET LIGHT & MUNI POLE		61	3S12"	SV-1-T	T		68	1S-COUNT	SP-1-T	EXTERNAL CONDUIT
7	CUTOFF MUNI POLE		82	3S12"	SV-1-T	T		49	1S-COUNT	SP-1-T	EXTERNAL CONDUIT

NO.	DATE	DESCRIPTION	BY	APP.
0	8/5/15	2543J PUNCHLIST WALKTHROUGH	DY	MV

TABLE OF REVISIONS
CHECK WITH TRACING TO SEE IF YOU HAVE LATEST REVISION

REFERENCE INFORMATION & FILE NO. OF SURVEYS

SAN FRANCISCO MUNICIPAL TRANSPORTATION AGENCY
CITY AND COUNTY OF SAN FRANCISCO

DRAWN: AS DATE: 9/2015
CHECKED: MV DATE: 9/2015

SCALE: AS SHOWN
SHEET OF SHEETS 1 OF 1

TRAFFIC SIGNAL INVENTORY DIAGRAM
8TH AVENUE AND FULTON STREET

CNN NO. 27258000
REV NO. 0