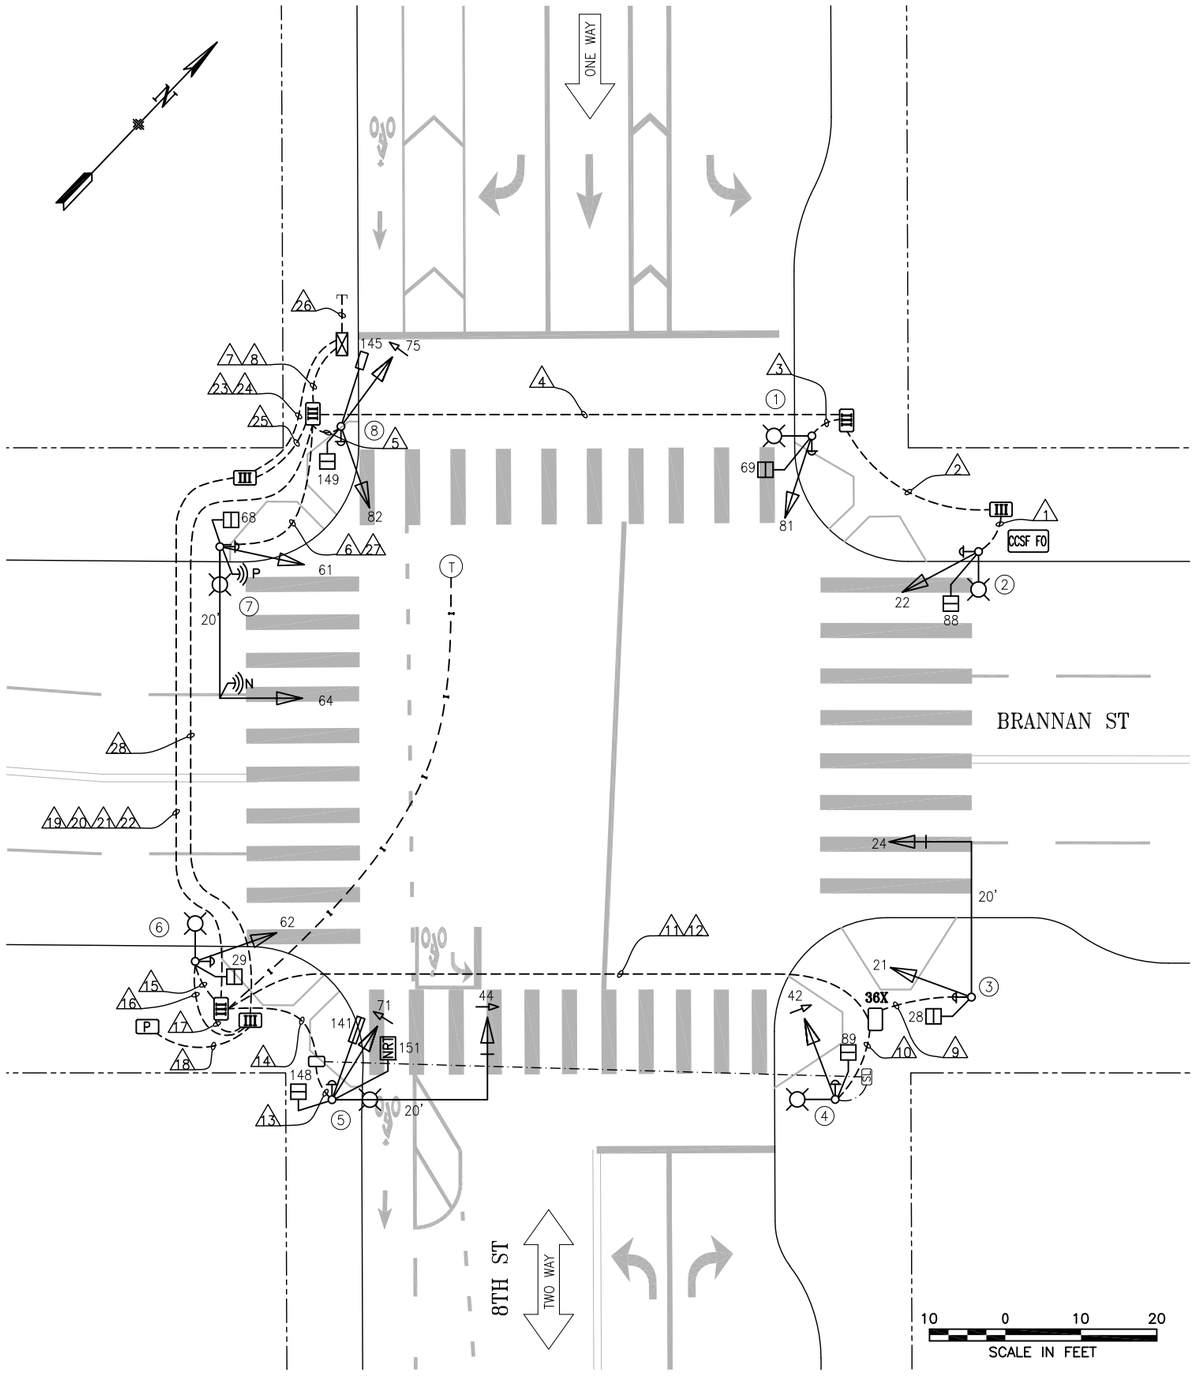

POLE AND EQUIPMENT SCHEDULE

POLE No.	TYPE OF POLE	LUMINAIRE VOLTAGE/ WATTAGE	VEHICLE SIGNAL					PEDESTRIAN SIGNAL			REMARKS
			No.	TYPE	MOUNTING	VISORS	LOUVERS/ BACKPLATE	No.	TYPE	MOUNTING	
1	CITY STANDARD STREET LIGHT	108W LED	81	3S12"FY	SV-1	T		69	1S-COUNT	SP-1-SF	APS-2W
2	CITY STANDARD STREET LIGHT	108W LED	22	3S12"	SV-1	T		88	1S-COUNT	SP-1	APS-2W
3	16-3-100 W/ 20' MAST ARM		21 24	3S12" 3S12"	SV-1-T MAS	T T	BACKPLATE	28	1S-COUNT	SP-1	APS-2W
4	CITY STANDARD STREET LIGHT	108W LED	42	4S12"GLA	SV-1-T	T		89	1S-COUNT	SP-1	APS-2W
5	17-1-70 W/ 20' MAST ARM AND 6' LA	108W LED	71 141 44 151(NRT)	3S12"RA 3S12"BIKE 4S12"GLA 1S 24"X24"	CUSTOM SV-2-T-SF MAS SV-1	T T T	BACKPLATE	148	1S-COUNT	SP-1	APS-2W
6	CITY STANDARD STREET LIGHT	108W LED	62	3S12"	SV-1-T	T		29	1S-COUNT	SP-1	APS-2W
7	17-2-100 W/ 20' MAST ARM AND 6' LA	108W LED	61 64	3S12" 3S12"	SV-1-T MAS	T T	BACKPLATE	68	1S-COUNT	SP-1	NETWORK AND PREEMPT RADIOS APS-2W
8	1-A(15')		75 145 82	3S12"RA 3S8"BIKE 3S12"FY	CUSTOM SV-3-T-SF	T T T		149	1S-COUNT	SP-1	APS-2W

NO.	DATE	DESCRIPTION	BY	APPROVED
1	7/5/23	INSTALL APS (2023-028)	E. LUU	G. DE LEON
0	5/20/20	CONVERT FR. AS BUILT: CT34 (2805J). PER FIELD: UPDATE 14P/15 LABELS, ADD RADIO EQUIPMENT	E. LUU	G. DE LEON

TABLE OF REVISIONS
CHECKOUT DRAWING THROUGH THE SID CUSTODIAN FOR THE LATEST REVISION

SFMTA

DRAWN BY: E. Luu DATE: 02/2023
CHECKED BY: G. de Leon DATE: 02/2023

SCALE: AS SHOWN
SHEET OF SHEETS: 1 OF 2

TRAFFIC SIGNAL INVENTORY DIAGRAM

8TH STREET AND BRANNAN STREET

CNN NO: 23872000
REV NO: 1

CONDUIT AND WIRING SCHEDULE

CONDUIT RUN NUMBER		1	2	3	4	5	6	7	8	9	10	11	12	13	14	15	16	17	18	19	20	21	22	23	24	25	26
CONDUIT SIZE (INCH)		UNK	UNK	UNK	2	2	2	3	2	2	2	2	2	2	2	2	2	1½	UNK	2	2	2	2	3	2	2	2
							GRS		SP				SP				GRS						SP			SP	SP
NOTES																											
	VEHICLE SIGNAL 22	3	3		3			3																			
	PED SIGNAL 88	2	2		2			2																			
	VEHICLE SIGNAL 81			3	3			3																			
	PED SIGNAL 69			2	2			2																			
	VEHICLE SIGNAL 75					3		3																			
	VEHICLE SIGNAL 82					3		3																			
	VEHICLE SIGNAL 145					3		3																			
	PED SIGNAL 109					2		2																			
	VEHICLE SIGNAL 61						3	3																			
	VEHICLE SIGNAL 64						3	3																			
	PED SIGNAL 68						2	2																			
	VEHICLE SIGNAL 21									3		3										3		3			
	VEHICLE SIGNAL 24									3		3										3		3			
	PED SIGNAL 28									2		2										2		2			
	VEHICLE SIGNAL 42										3	3										3		3			
	PED SIGNAL 89										2	2										2		2			
	VEHICLE SIGNAL 44													3	3							3		3			
	VEHICLE SIGNAL 71													3	3							3		3			
	VEHICLE SIGNAL 141													3	3							3		3			
	ILLUMINATED NRT SIGN													2	2							2		2			
	PED SIGNAL 108													2	2							2		2			
	VEHICLE SIGNAL 62															3						3		3			
	PED SIGNAL 29															2						2		2			
	#14 NEUTRAL	2		2		2	3			3	2			2	2	2											
	#14 SPARE		3		3			3				3										3		3			
	TOTAL #14 WIRES	7	8	7	13	13	11	32		11	7	16		15	15	7						34		34			
	#10 WIRES NEUTRAL		1		1			2				1										2		2			
	#10 WIRES STREET LIGHT	2		2			2										2										
	#8 WIRES STREET LIGHT		2															2			2						
	#8 WIRES (120 V SERVICE)																	2	2	2					2		
	#6 BSCW																										
	INTERCONNECT 12C CABLE																			2				2			
	APS-3W CABLE																										
	APS PPB XING BRANNAN, POLE 3 (8P)									1	1																
	APS PPB XING 8TH ST, POLE 4 (2P)									1	1																
	APS PPB XING 8TH ST, POLE 5 (2P)													1	1	1											
	APS PPB XING BRANNAN, POLE 6 (14P)													1	1	1											
	APS PPB XING BRANNAN, POLE 7 (14P)					1	1																				
	APS PPB XING 8TH ST, POLE 8 (6P)					1	1																				

NO.	DATE	DESCRIPTION	BY	APPROVED
1	7/5/23	INSTALL APS (2023-028)	E. LUU	G. DE LEON
0	5/20/20	CONVERT FROM AS BUILT: CONTRACT 34 (2805J)	E. LUU	G. DE LEON

TABLE OF REVISIONS
CHECKOUT DRAWING THROUGH THE SID CUSTODIAN FOR THE LATEST REVISION

CITY AND COUNTY OF SAN FRANCISCO

SFMTA

DRAWN BY: E. Luu DATE: 02/2023
CHECKED BY: G. de Leon DATE: 02/2023

SCALE: NONE
SHEET OF SHEETS: 2 OF 2

TRAFFIC SIGNAL INVENTORY DIAGRAM
8TH STREET AND BRANNAN STREET
CONDUIT AND WIRING SCHEDULE

CNN NO: 23872000
REV NO: 1